


HOPKINS & IRVIN TRACT

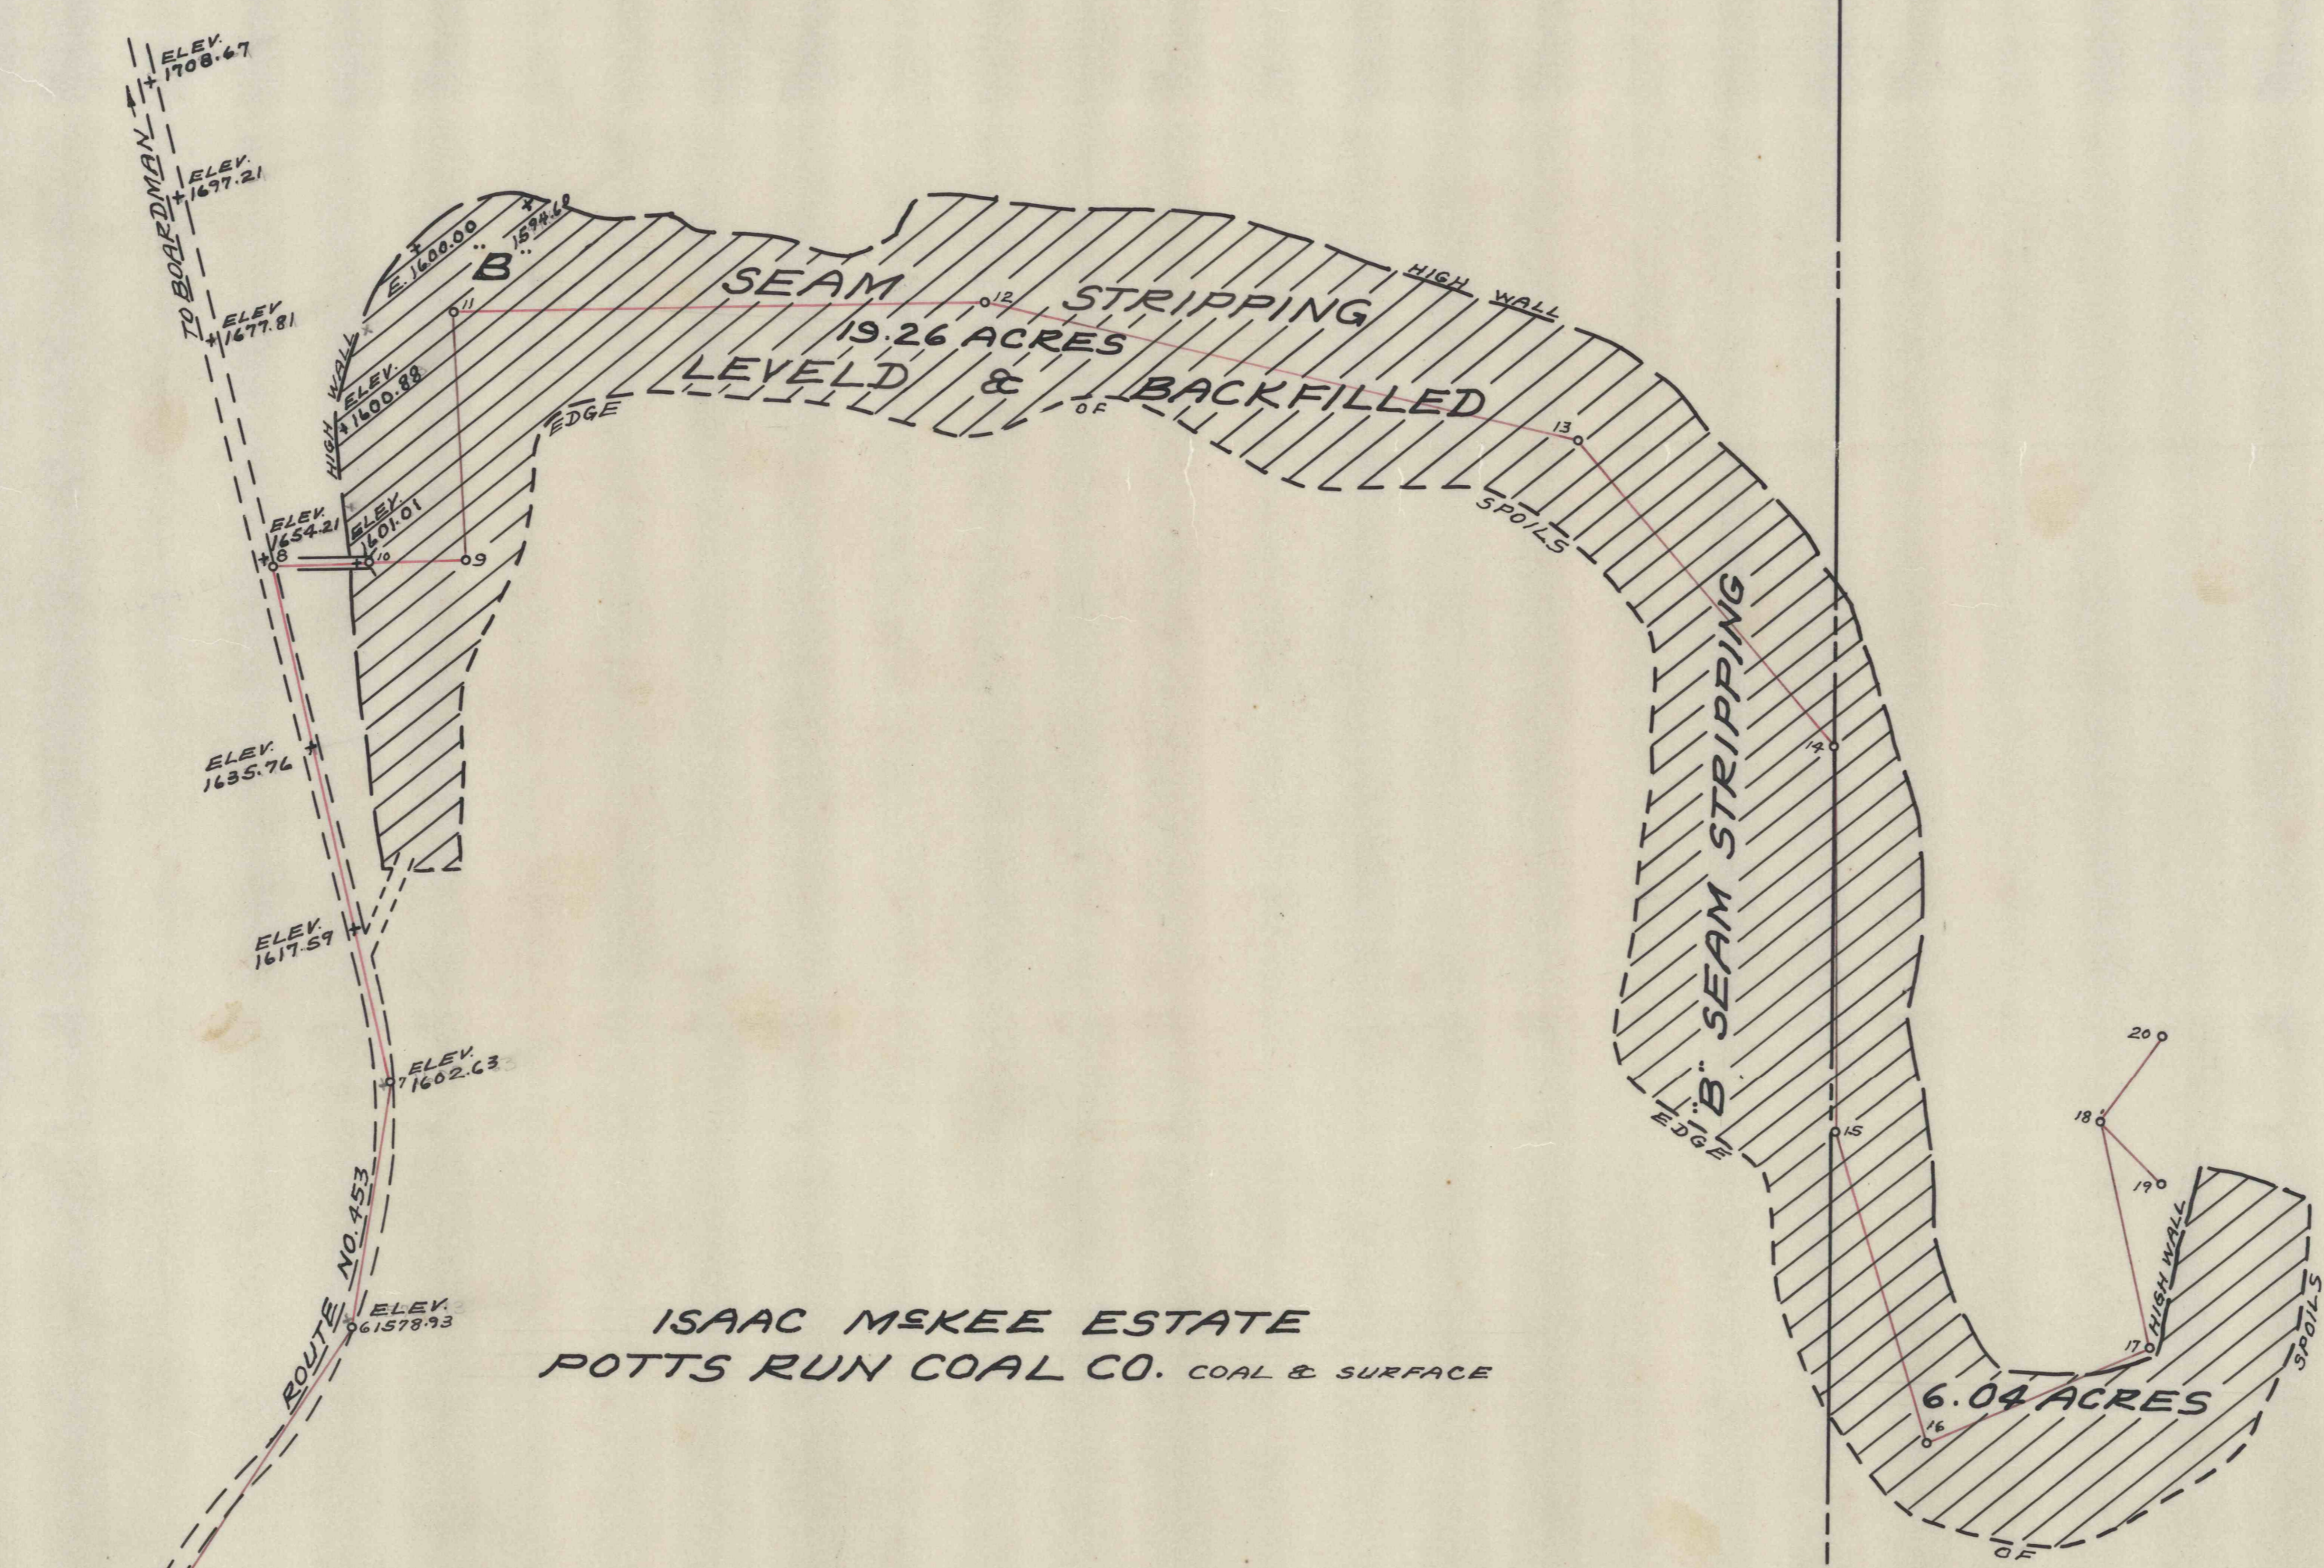


ISAAC MSKEE ESTATE
POTTS RUN COAL CO. COAL & SURFACE

RALPH BARNETT TRACT SURFACE
POTTS RUN COAL CO. COAL

SAMUEL EMLINE WT.

WILLIAM PARKER WT.

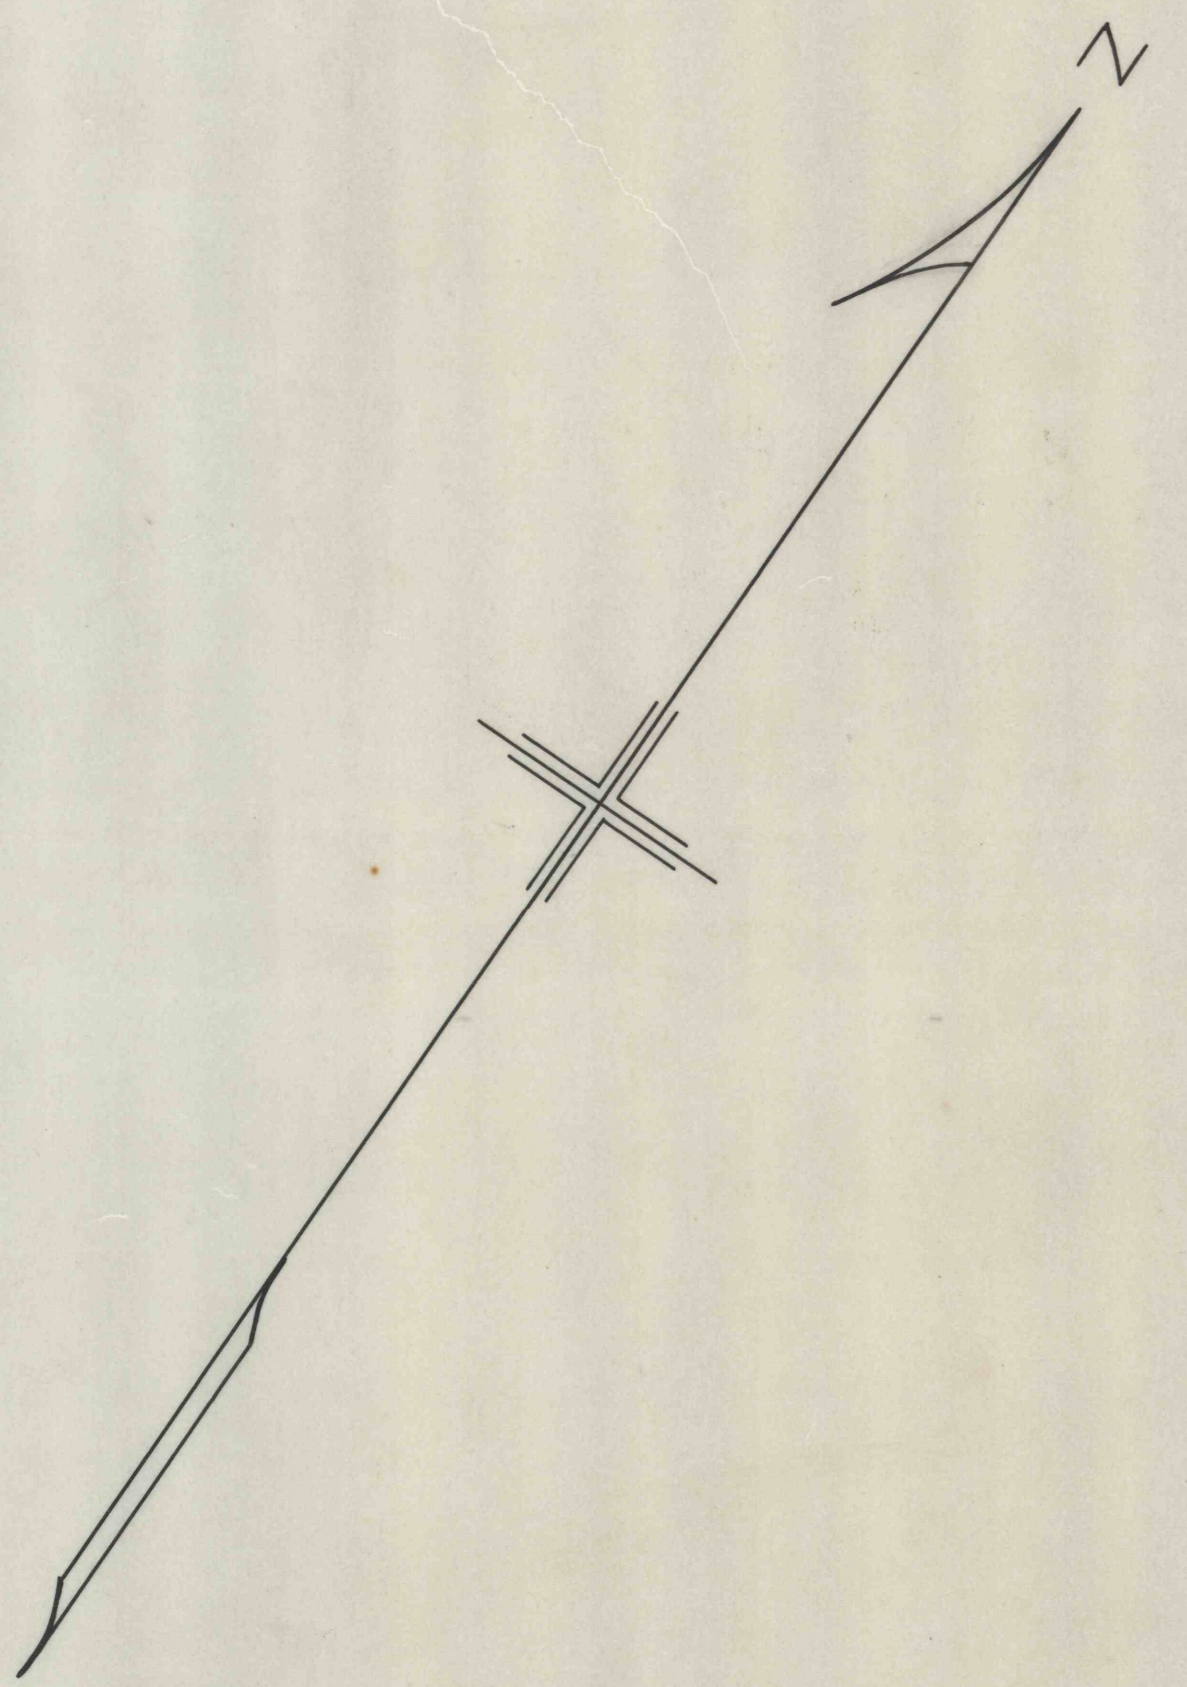

M

— MAP SHOWING "B" SEAM STRIPPING —
 — OPERATED BY S. R. HANSEL COAL COMPANY —
 — KNOX TWP. CLEARFIELD COUNTY PA. —
 — SCALE 1" = 200' — APRIL 18 1955 —
 — BERNARD LUCAS & ASSOC. ENGRS. —

C.D. 469