


POLLY McCLANAHAN

SAMUEL FOREST

WILLIAM BINGHAM

ANDREW BAYARD  
MIDLAND MINING CO.

JAMES WHEELER  
L.V.C. CO.

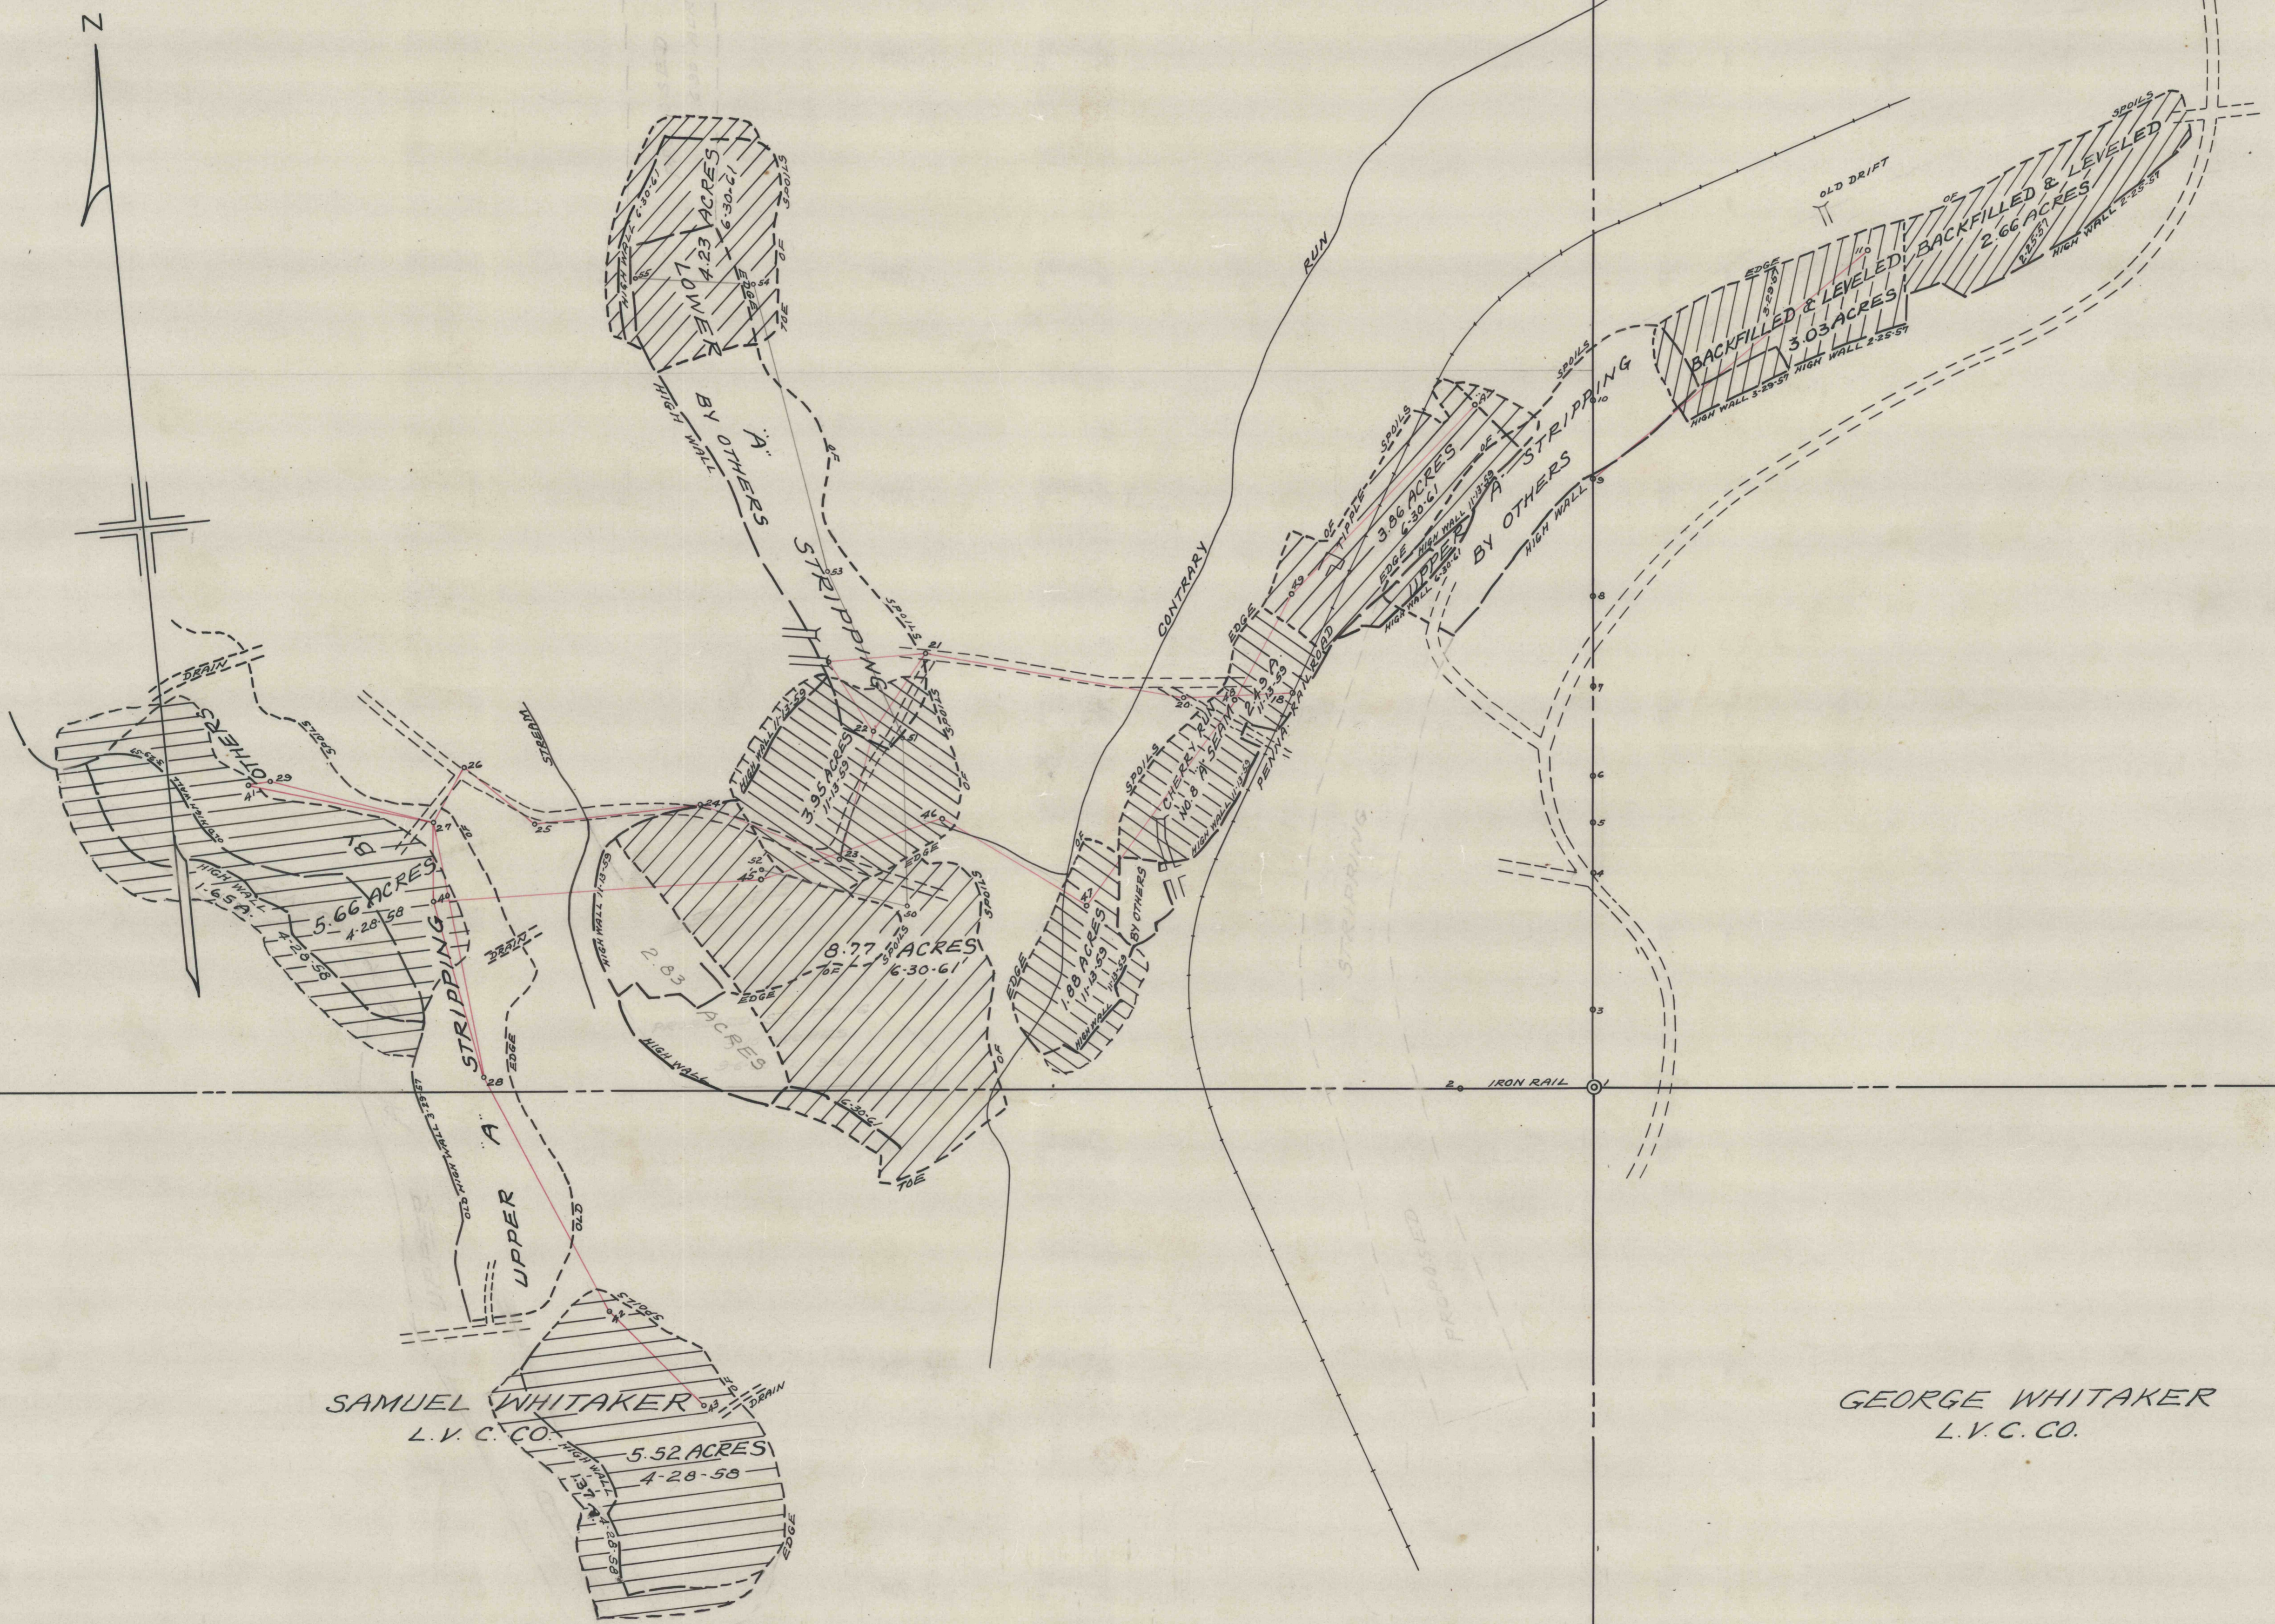

SAMUEL WHITAKER  
L.V.C. CO.

GEORGE WHITAKER  
L.V.C. CO.

JAMES WHITAKER

NOTE:  
 BACKFILLED & LEVELED 2-25-51 2.66 ACRES  
 " " " 3-29-51 3.03 "  
 BACKFILLED & LEVELED 4-28-58 14.20 ACRES  
 " " " 11-13-59 8.32 "  
 BACKFILLED & LEVELED 6-30-61 16.86 ACRES

M  
 — MAP OF UPPER & LOWER "A" STRIPPINGS —  
 — OPERATED BY JOSEPH PADISAK —  
 — SNOW SHOE TWP CENTRE COUNTY PENNA. —  
 — SCALE 1" = 200' — SEPT. 28 1956 —  
 — BERNARD LUCAS ASSOC. —

C.D. 452

6/1/51

1467