


9541

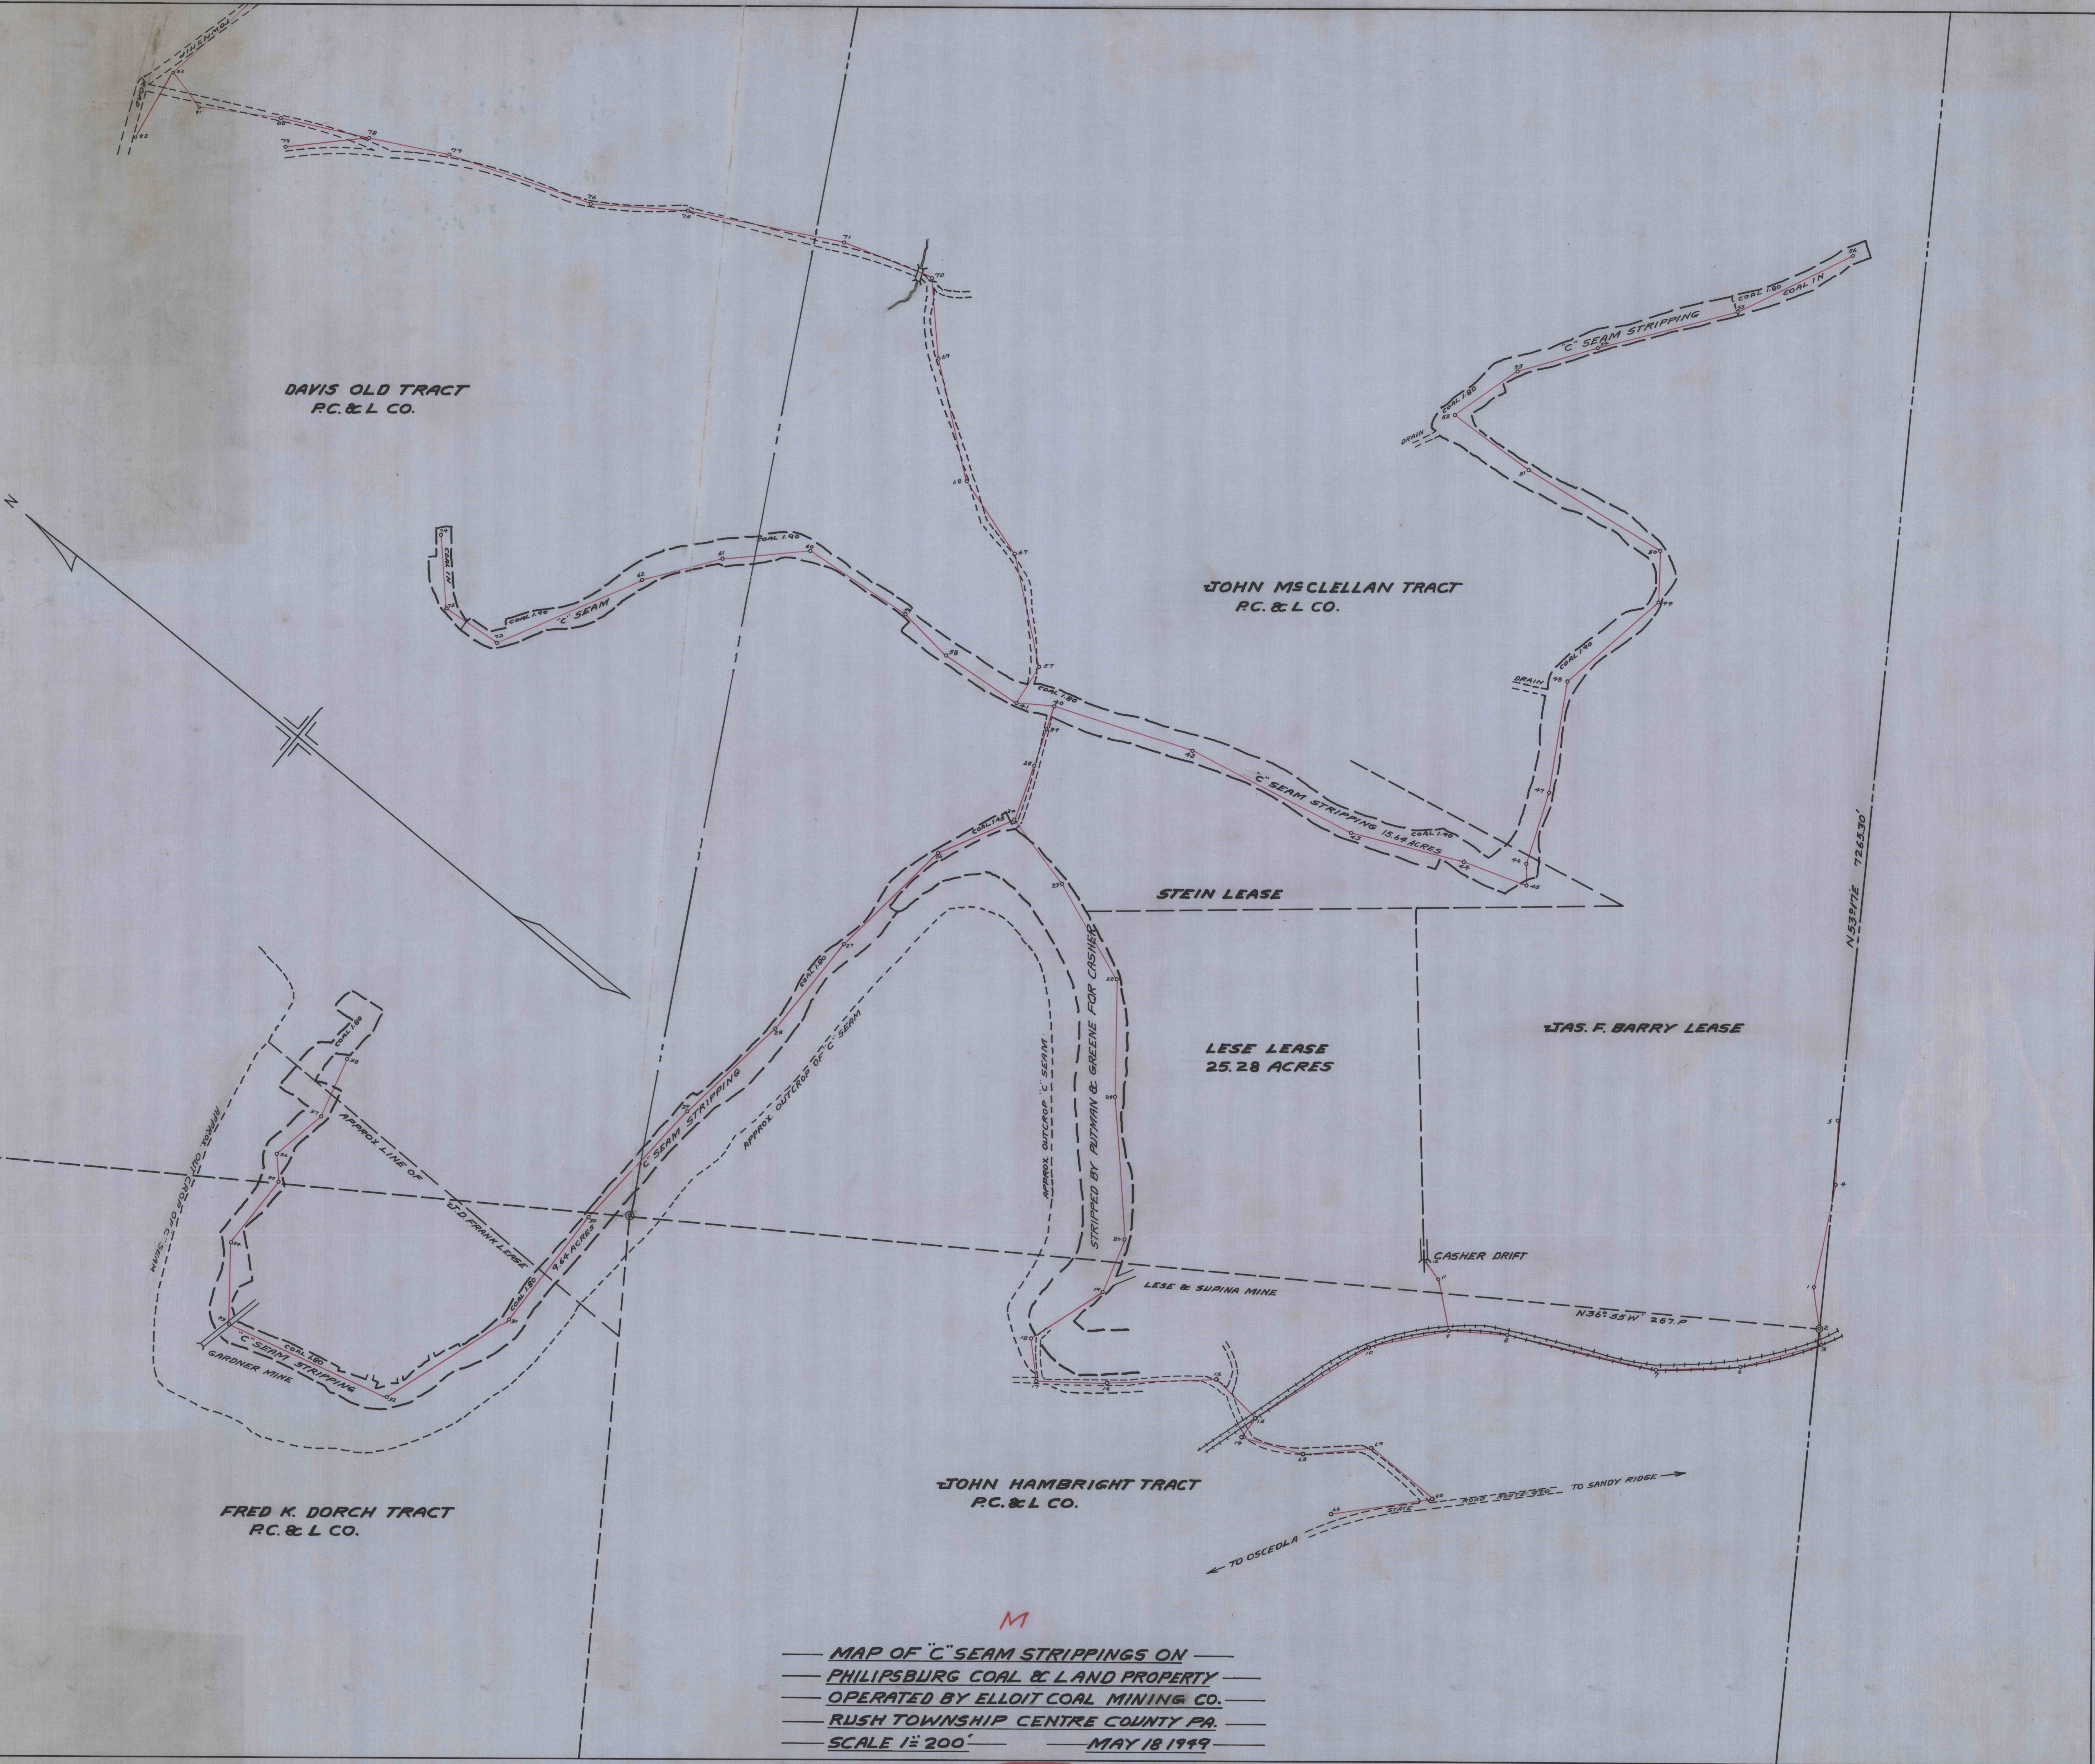

DAVIS OLD TRACT
P.C. & L. CO.

JOHN MCCLELLAN TRACT
P.C. & L. CO.

STEIN LEASE

LEESE LEASE
25.28 ACRES

JAS. F. BARRY LEASE

FRED K. DORCH TRACT
P.C. & L. CO.

JOHN HAMBRIGHT TRACT
P.C. & L. CO.

M

— MAP OF "C" SEAM STRIPPINGS ON —
 — PHILIPSBURG COAL & LAND PROPERTY —
 — OPERATED BY ELLOIT COAL MINING CO. —
 — RUSH TOWNSHIP CENTRE COUNTY PA. —
 — SCALE 1" = 200' — MAY 18 1949 —

C.D. 309

1479