

1021

1501


HAGARTY TRACT

W.W. MEWANS ESTATE
J.C.M. CO. IN FEE

JOHN C. GATES

FITZGIBBONS TRACT

BEERS TRACT

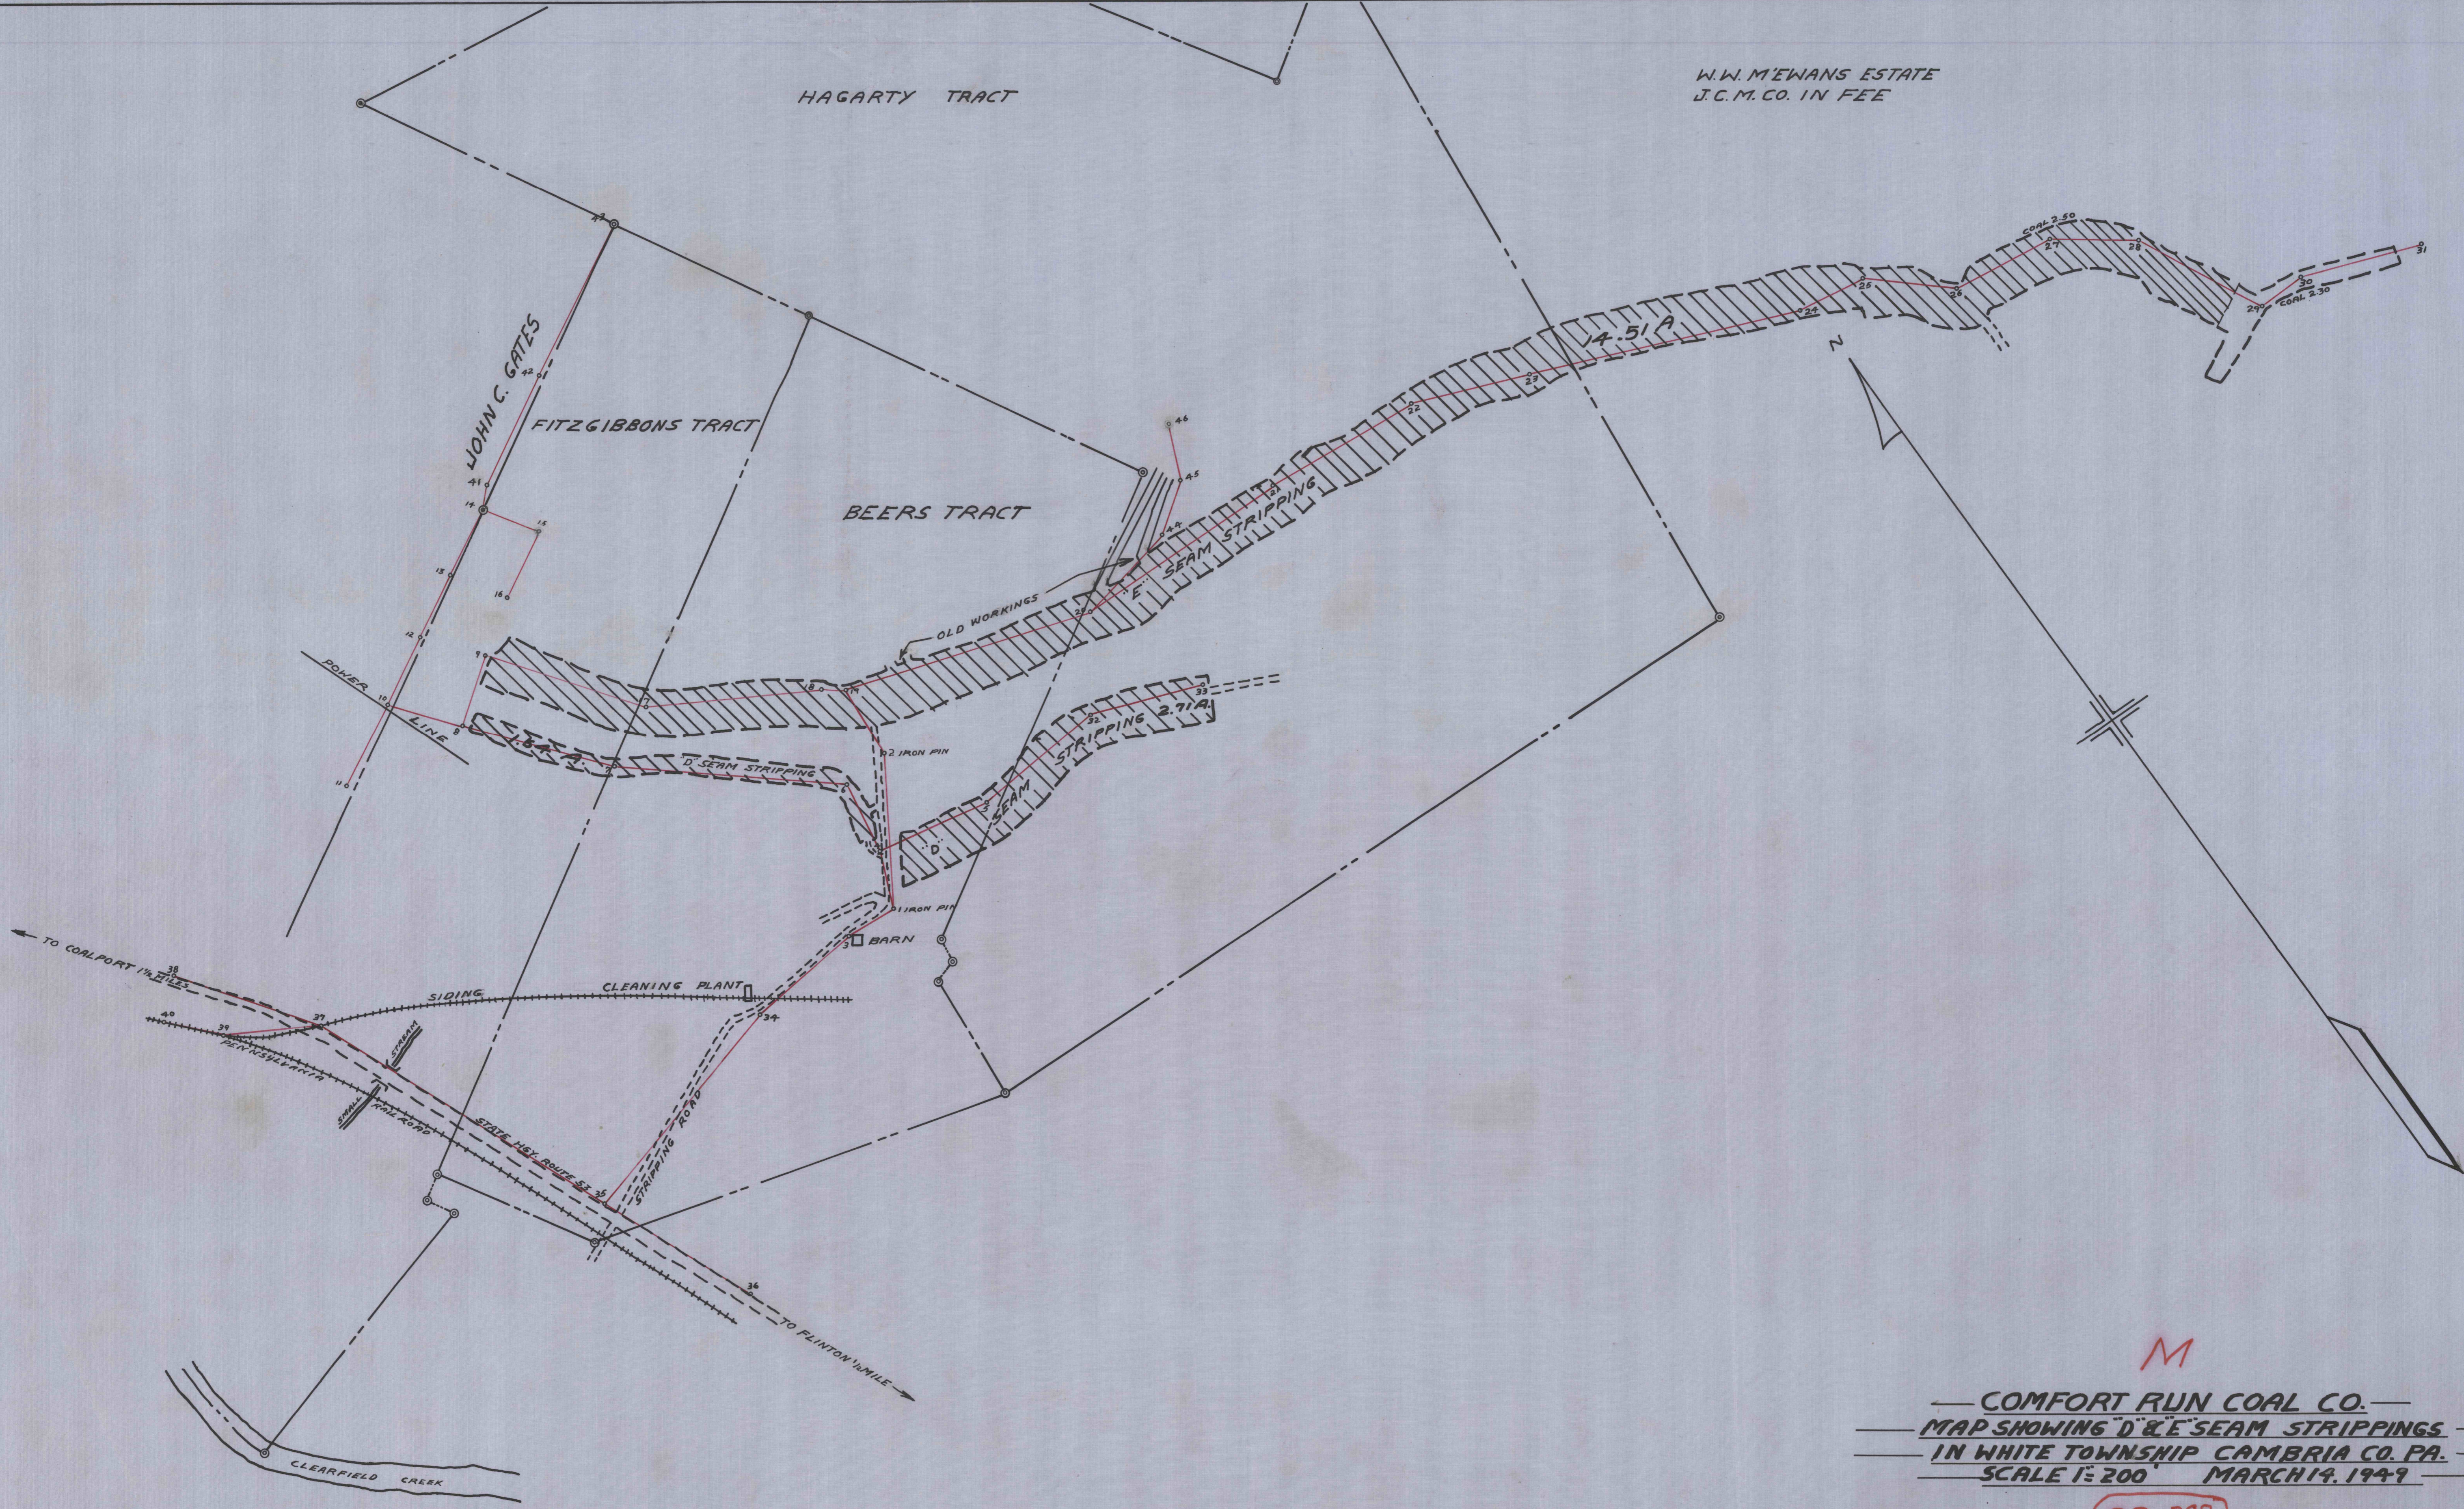

M

COMFORT RUN COAL CO.
 MAP SHOWING D & E SEAM STRIPPINGS
 IN WHITE TOWNSHIP CAMBRIA CO. PA.
 SCALE 1"=200' MARCH 14, 1949

C.D. 302