


1218

1518

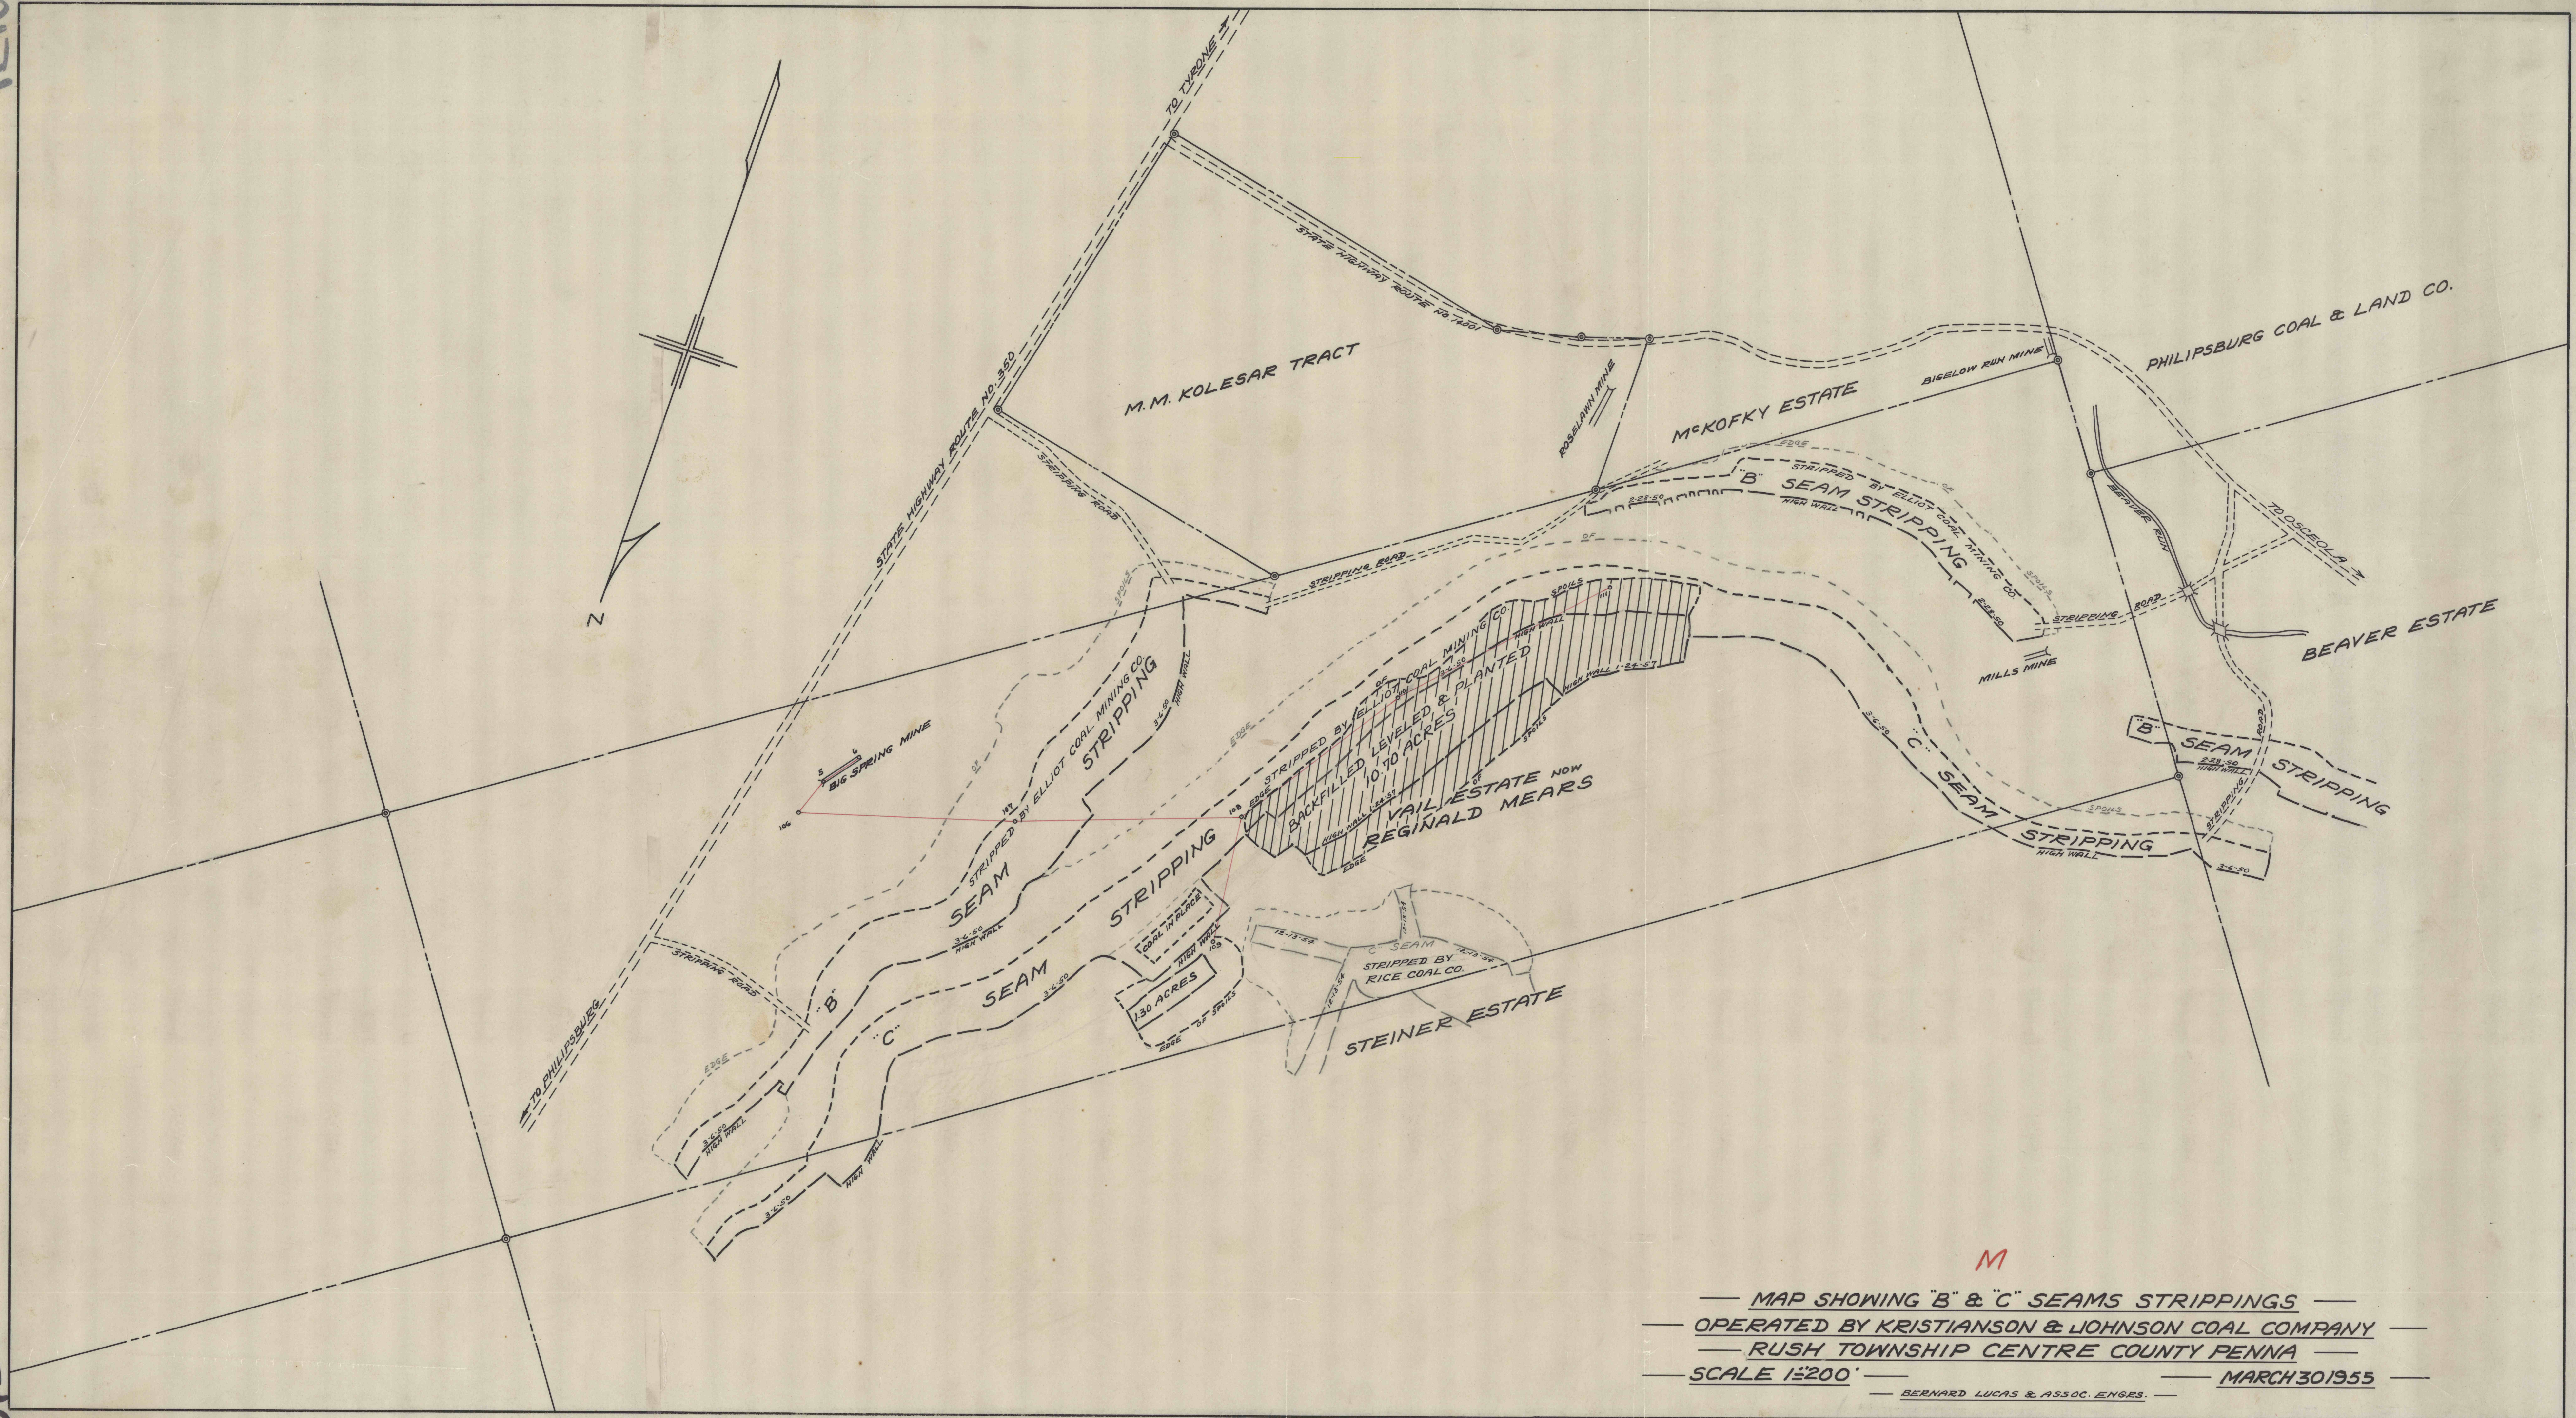

M

— MAP SHOWING "B" & "C" SEAMS STRIPPINGS —
 — OPERATED BY KRISTIANSON & JOHNSON COAL COMPANY —
 — RUSH TOWNSHIP CENTRE COUNTY PENNA —
 — SCALE 1:200' — MARCH 30/1955 —
 — BERNARD LUCAS & ASSOC. ENGRS. —

C.D.397