

R. H. MULL ESTATE

RALSTON & SHANNON

MORRIS BOGGS

UNNAMED BR LAUREL RUN TO LAUREL RUN 1.42 MILES

TOWNSHIP TOWNSHIP

WILLIAM L. GOSS

J. SMEAL

D. J. SMEAL

WILLIAM FLECK

WILLIAM FLECK

NOTE:

"A" SEAM SPOILS 5.10 A. PLUS "A" STRIPPING 9.80 A. = 14.90 ACRES
"B" SEAM SPOILS 12.38 A. PLUS "B" STRIPPING 40.22 A. = 52.60 ACRES
TOTAL AREA TO BE DISTURBED "A" & "B" SEAMS 67.50 ACRES

NOTE:

11-25-63 BACKFILLED LEVELED & PLANTED 21.04 ACRES

NOTE:

5-22-70 ORIGINAL PERMIT 20.00 ACRES IN YELLOW
5-22-70 REBOND OLD LAW AREA 9.53 ACRES IN RED SB 10471

MAP SHOWING STRIPPING OPERATIONS
OF THE THOMPSON BROS. COAL COMPANY
BOGGS TWP, CLEARFIELD COUNTY PENNA.

SCALE 1" = 200' JAN. 21, 1964


BERNARD LUCAS ASSOCIATES

C.D. 426

1523

REV. 8/14/70

R. K. HUNTER TRACT NOW GEN. REF. CO.

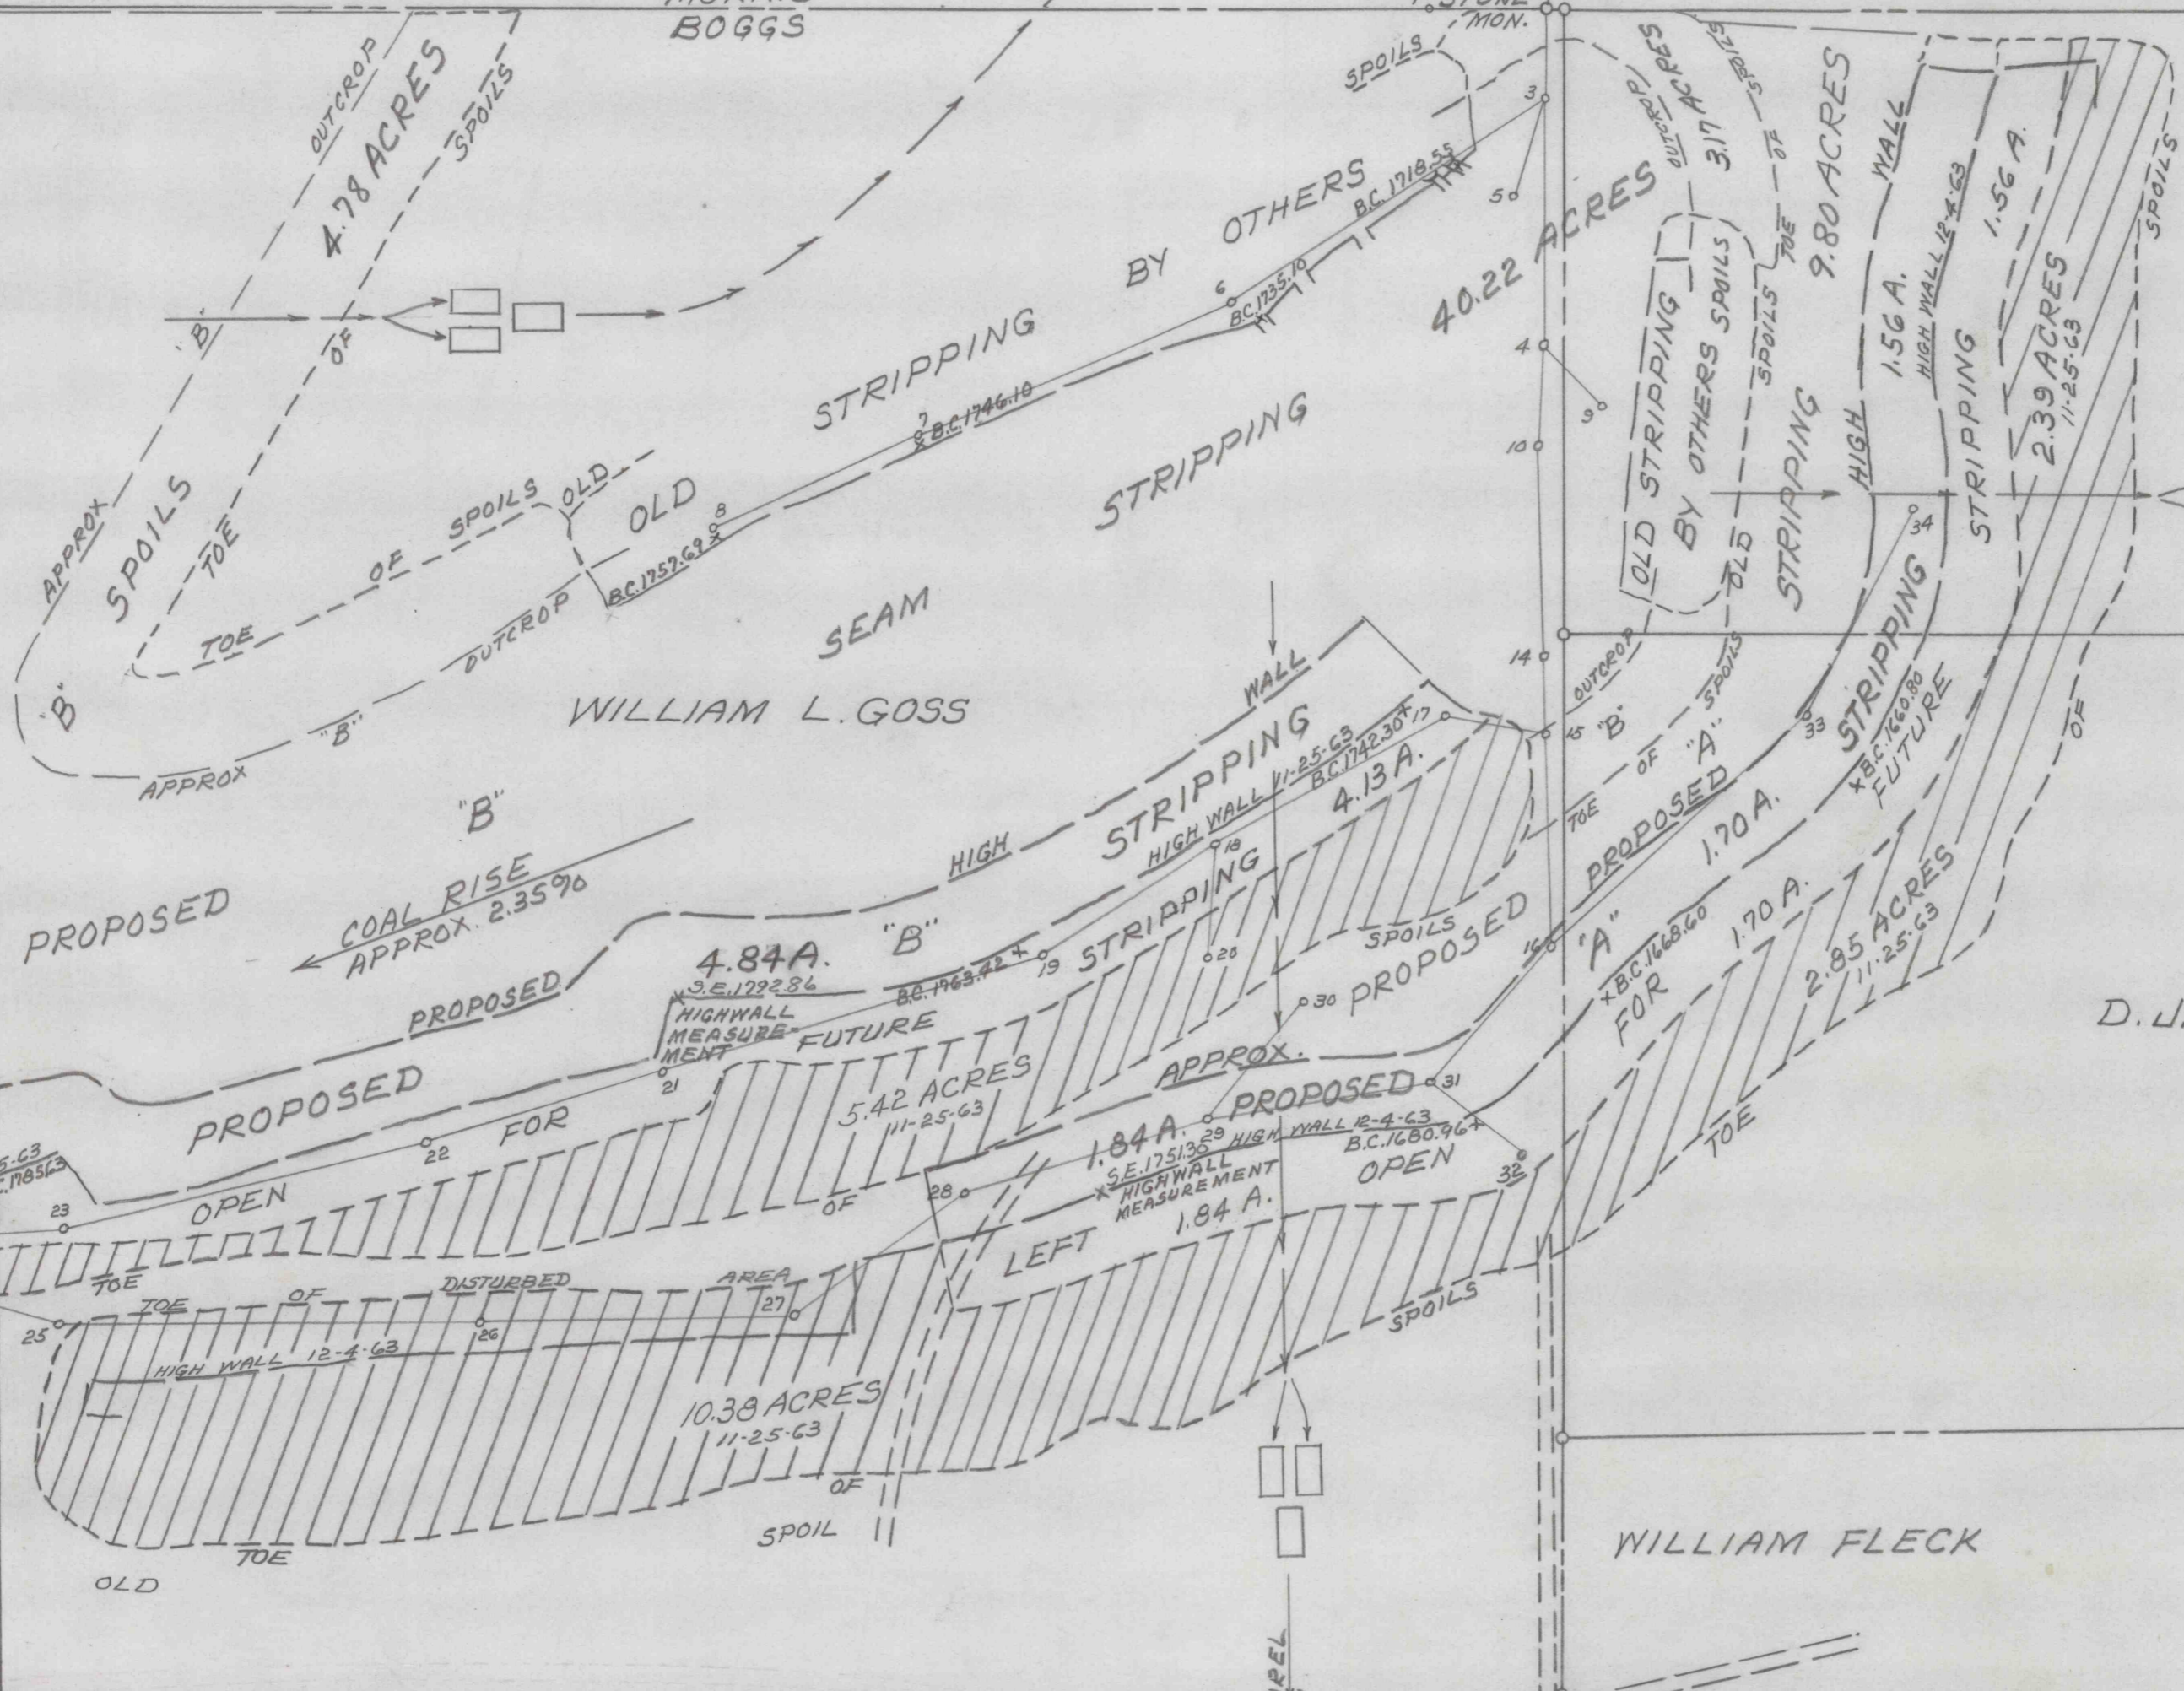

1523