


1242

1595

McDONALD TRACT

PENNA. STATE GAME LANDS

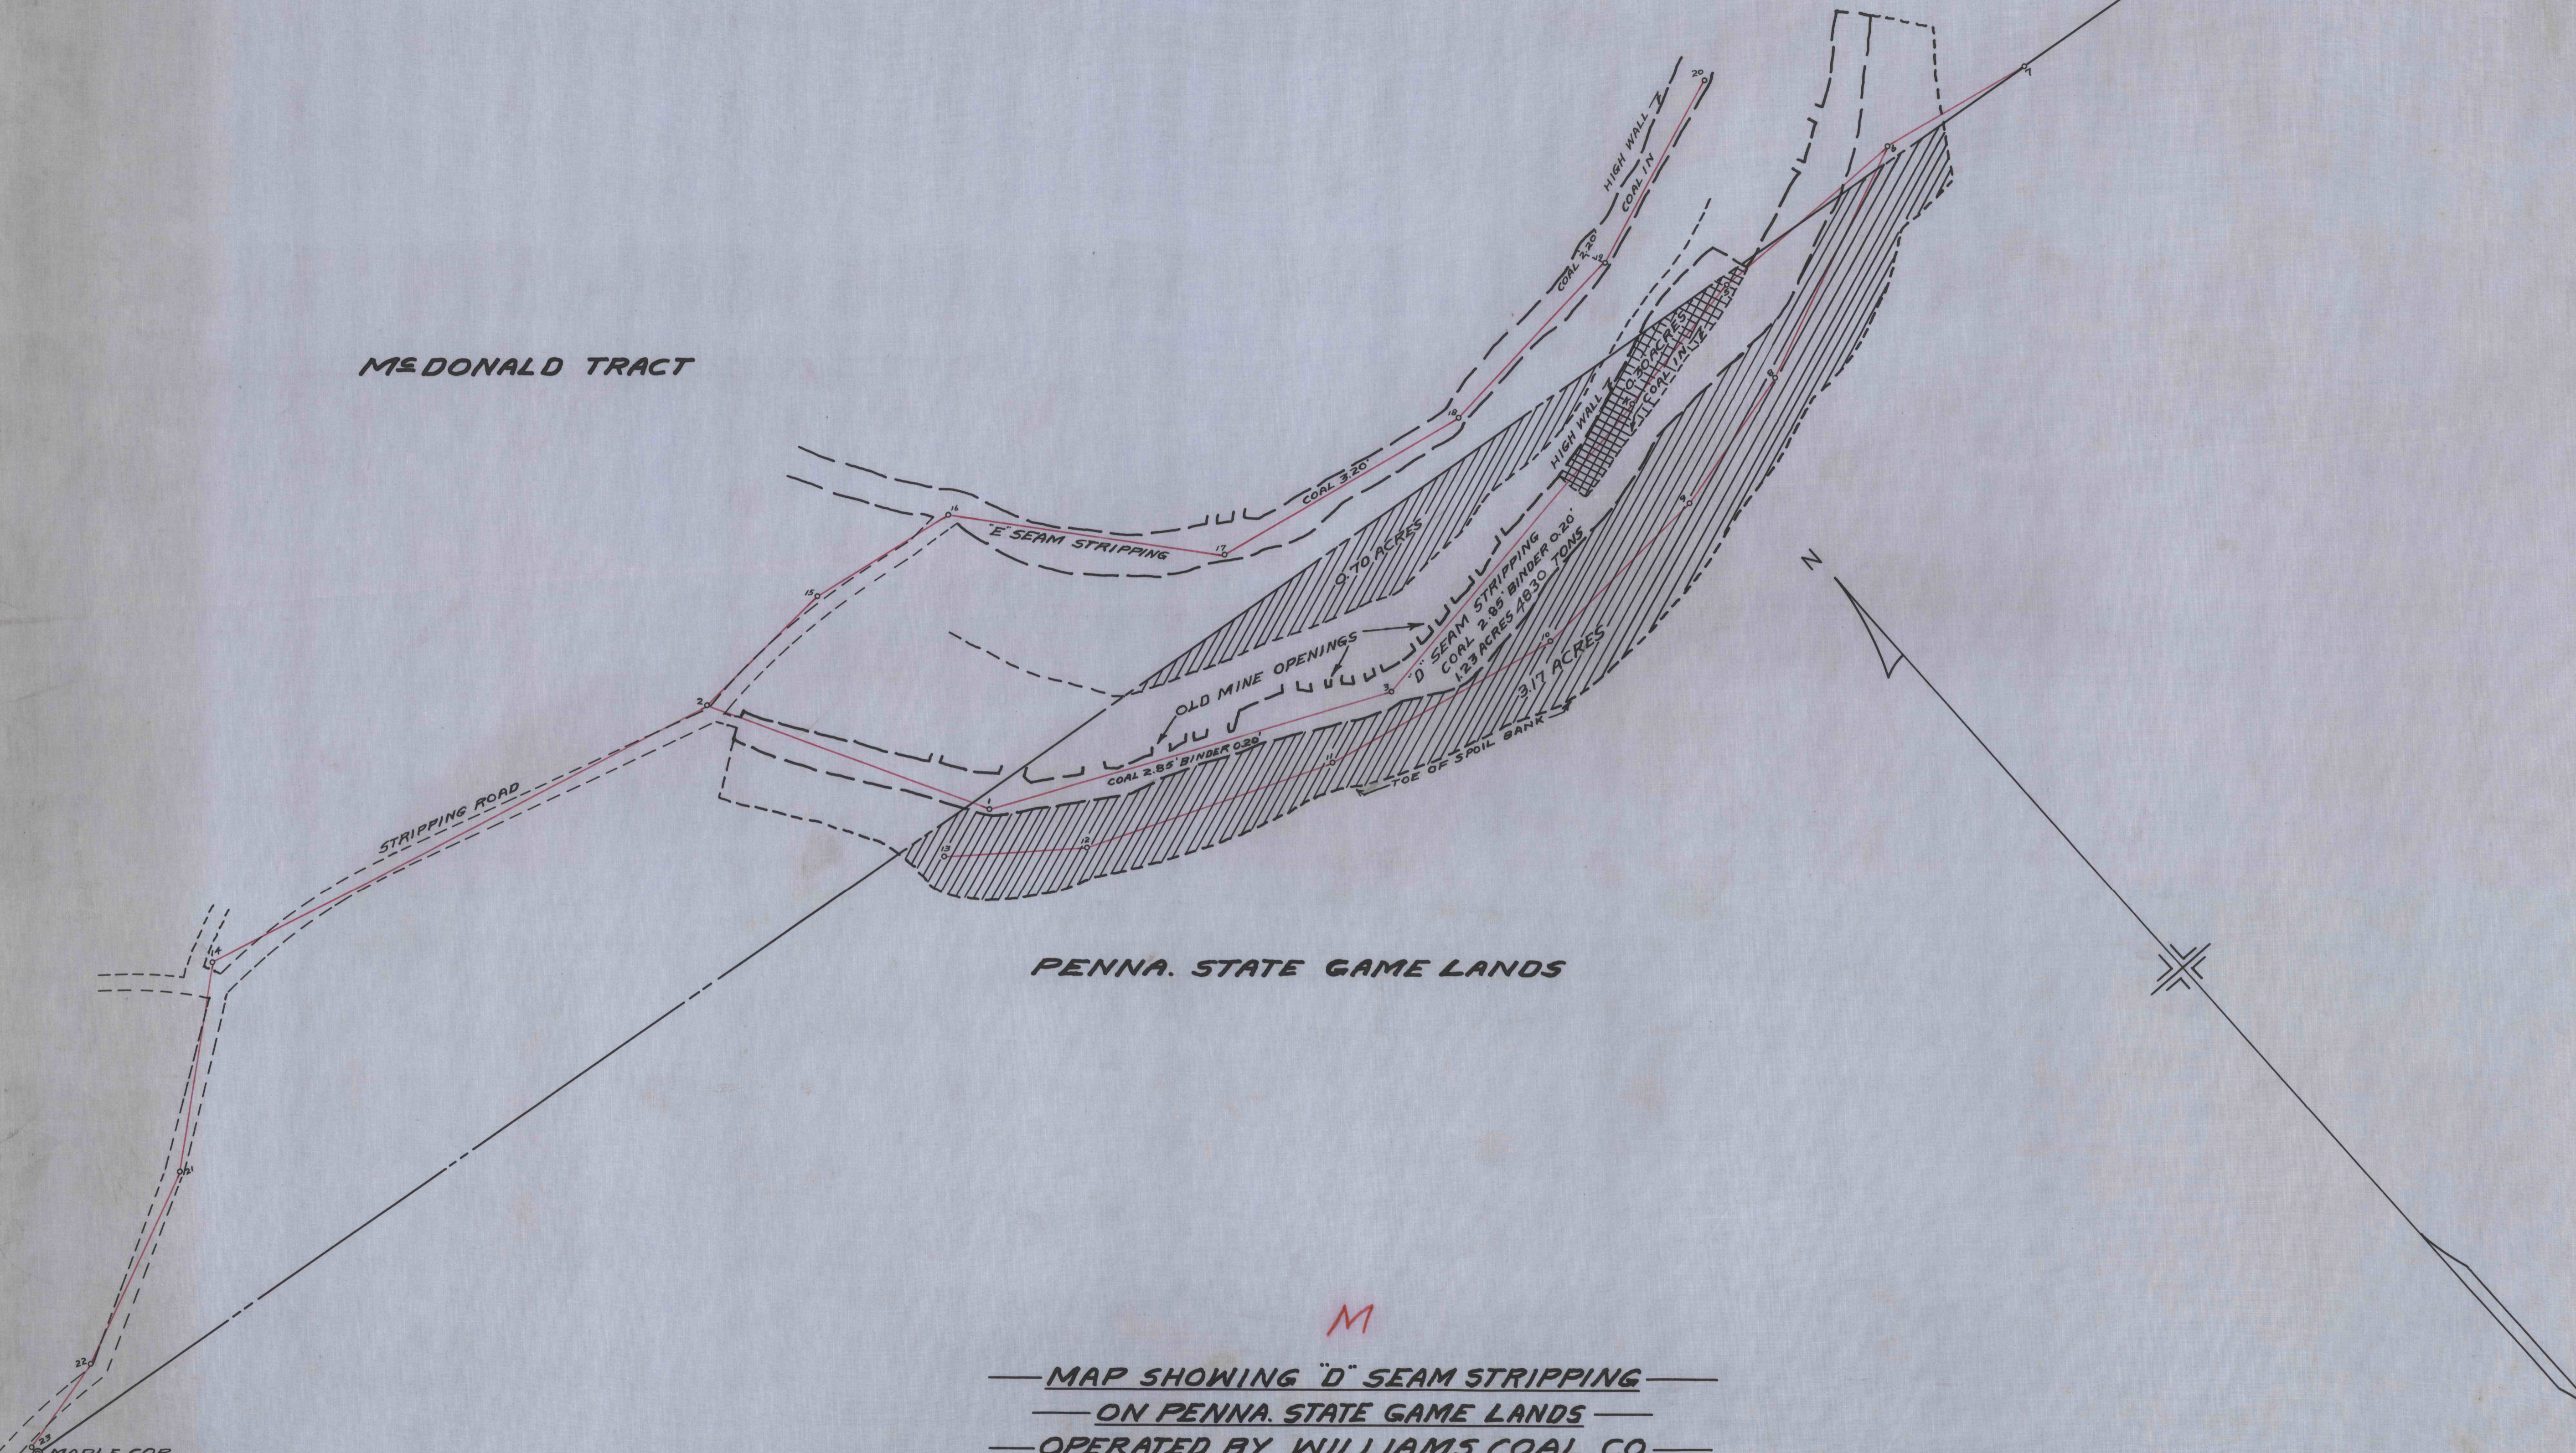

M

— MAP SHOWING "D" SEAM STRIPPING —
 — ON PENNA. STATE GAME LANDS —
 — OPERATED BY WILLIAMS COAL CO. —
 — READE TWP. CAMBRIA CO. PENNA. —
 — SCALE 1" = 200' — — MAY 31 1949 —

C.D.311