

1881

1865

JOSEPH MATLOCK TRACT

ROBERT HILTZAIMER TRACT

SAMUEL HAMBLETON TRACT
K.C. CO. LEASE TO CARL SMITH

NORTH BRANCH LITTLE BEAVER RUN

THOMAS COPE TRACT
BIGLER EST.

CUT STONE
MDN.


SEAM
MDN.

PENN NO. 10

JOHN B. McENELLY EST.

STATE ROAD ROUTE NO. 17049
TO OSCEOLA
TO ASHLAND

TOWNSHIP 2002

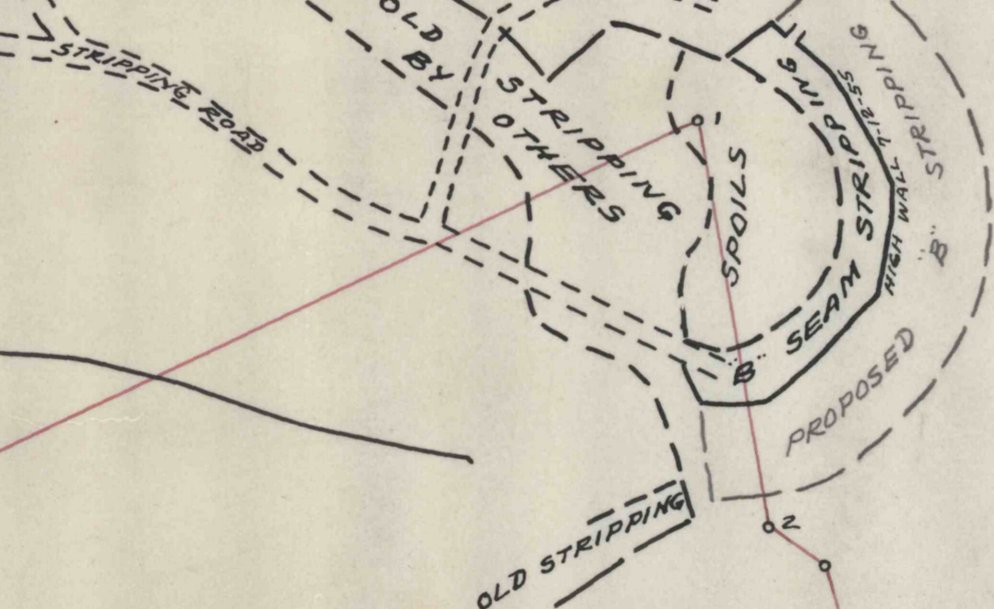

M

— MAP SHOWING "B" SEAM STRIPPING —
 — OPERATED BY WALLIN COAL COMPANY —
 — DECATUR TWP. CLEARFIELD CO. PA. —
 — SCALE 1" = 200' — JULY 13 1955 —
 BERNARD LUCAS ASSOC. ENGRS.

C.D. 493