


1956

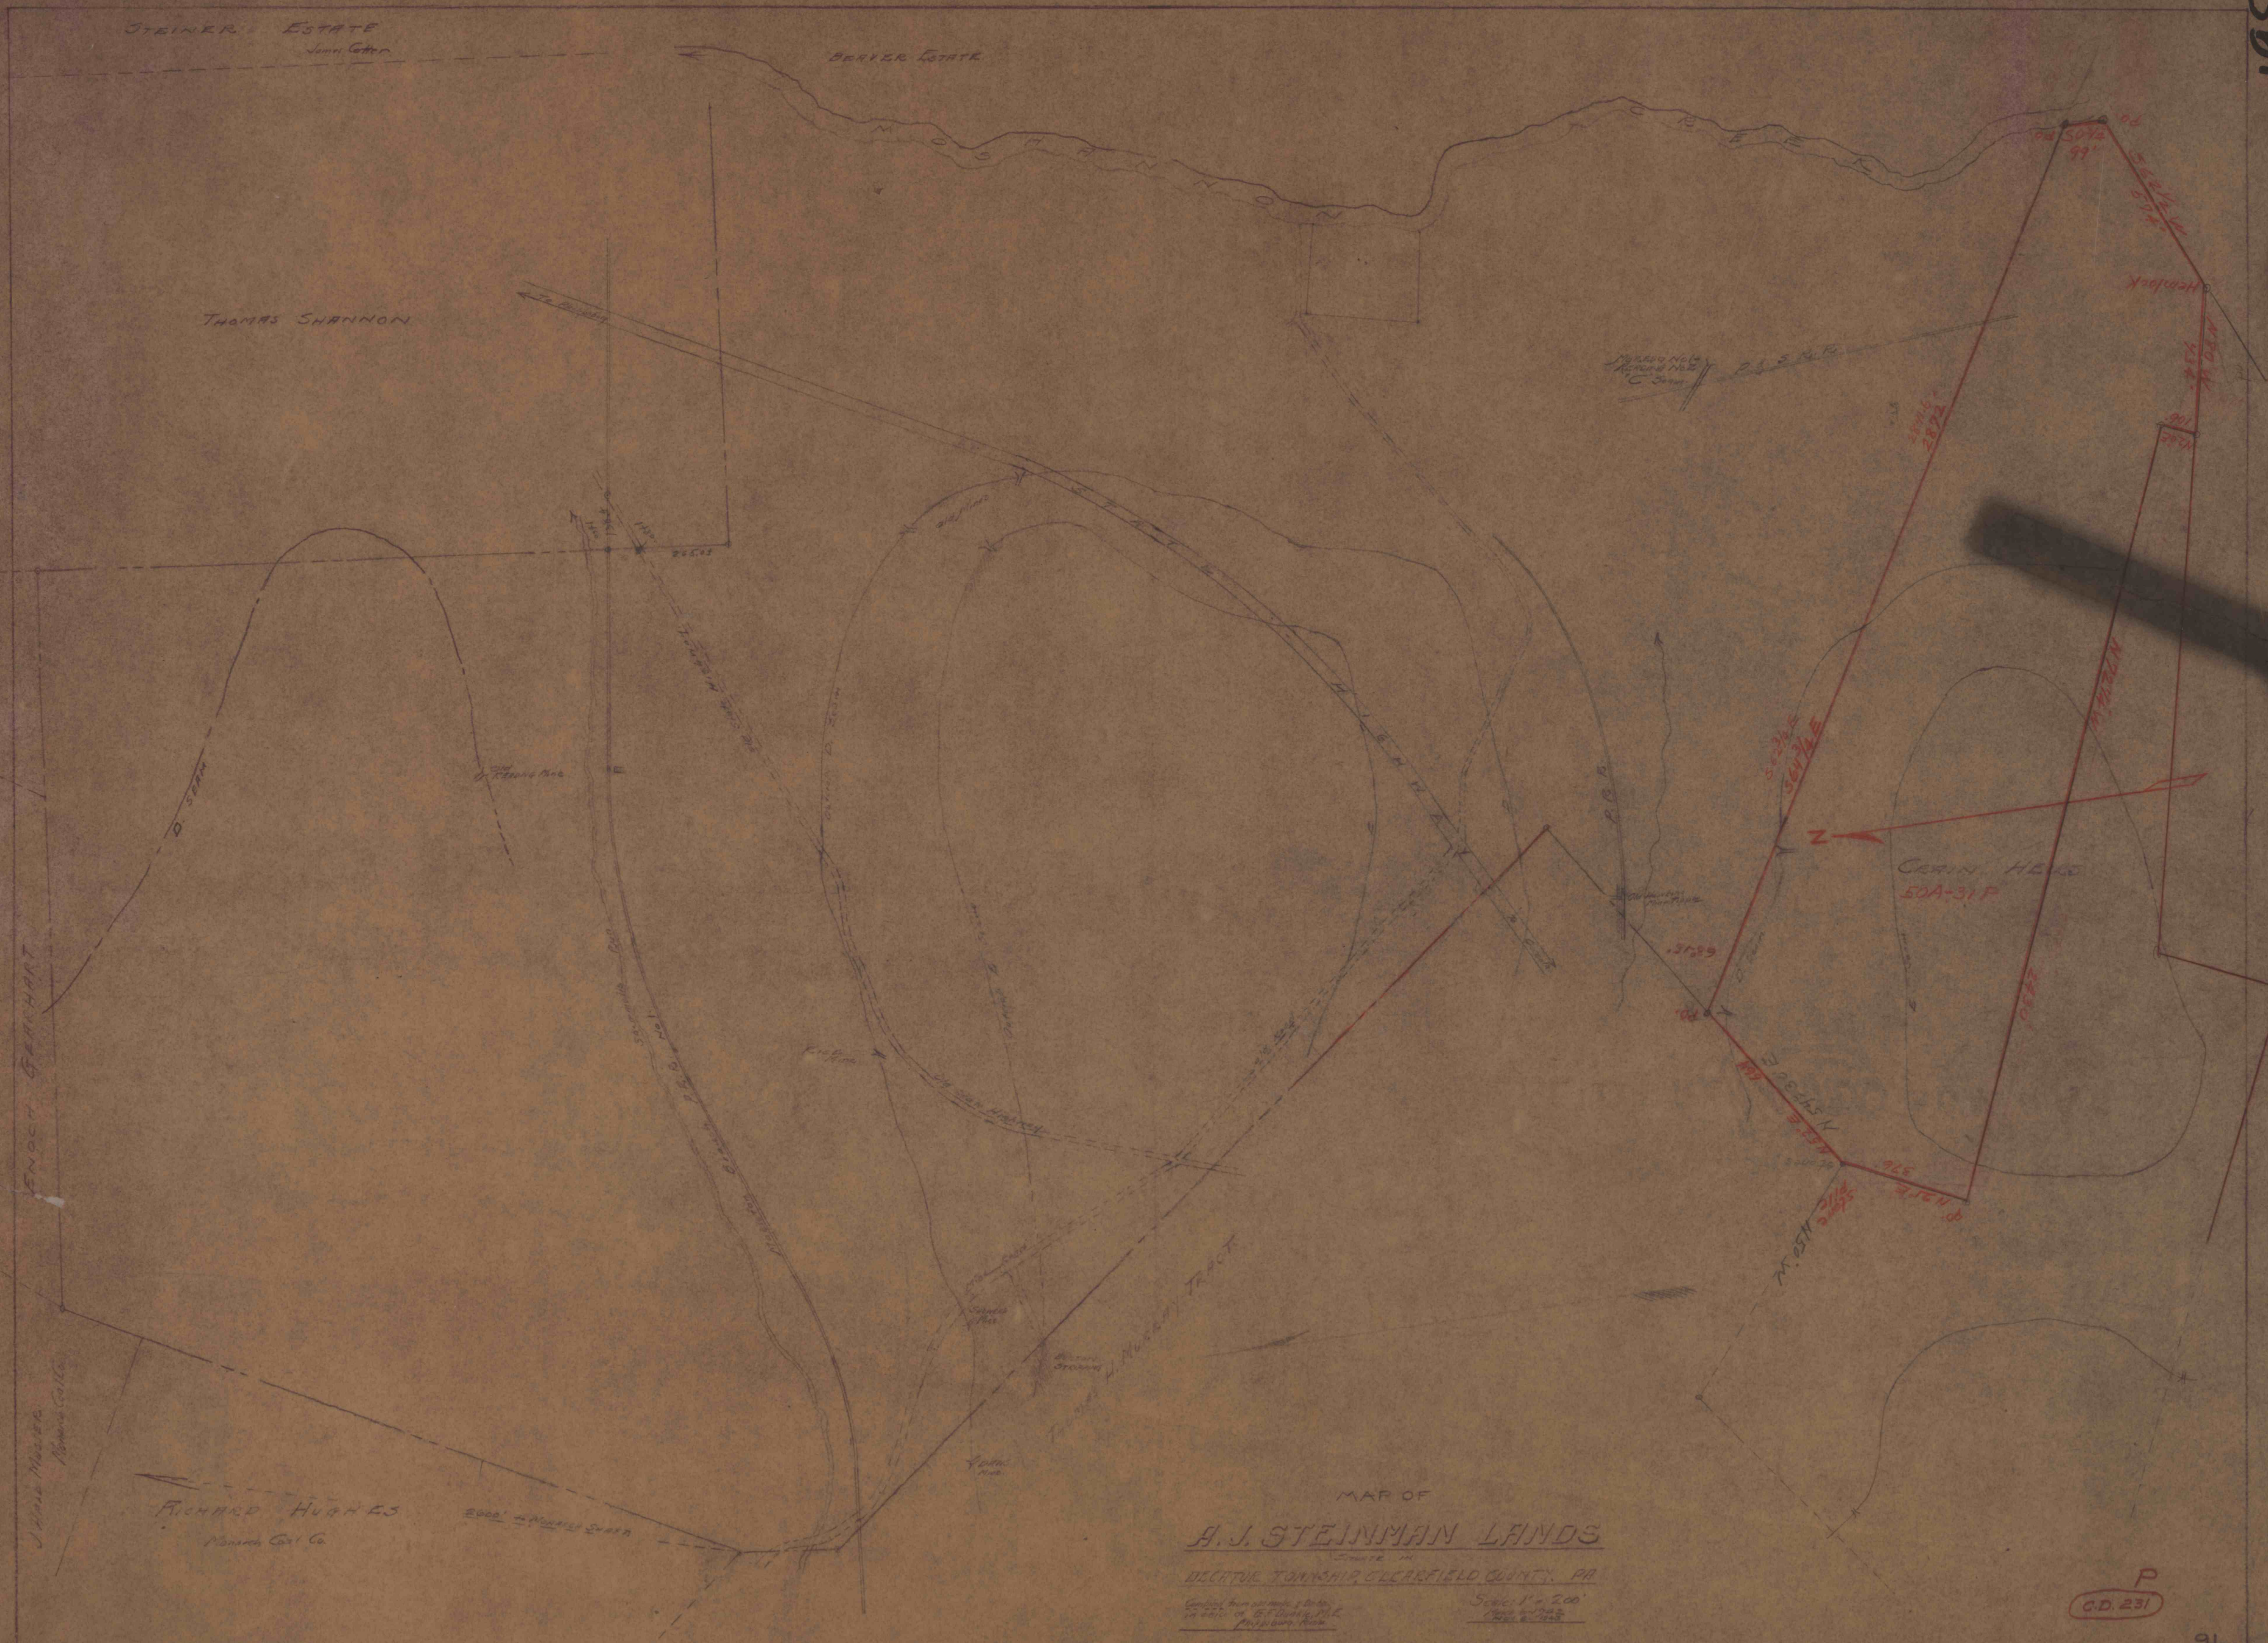

P
CD. 231

9L
275-418