

ENV. No.

SHEET No.


20-3-20

ENGINEERING DEPARTMENT

CLAY MINE - GREEN TRACT
CHAPMAN TWP. - CLINTON CO., PA.

SCALE 1" = 200 Ft.

DATE Feb 11, 1937

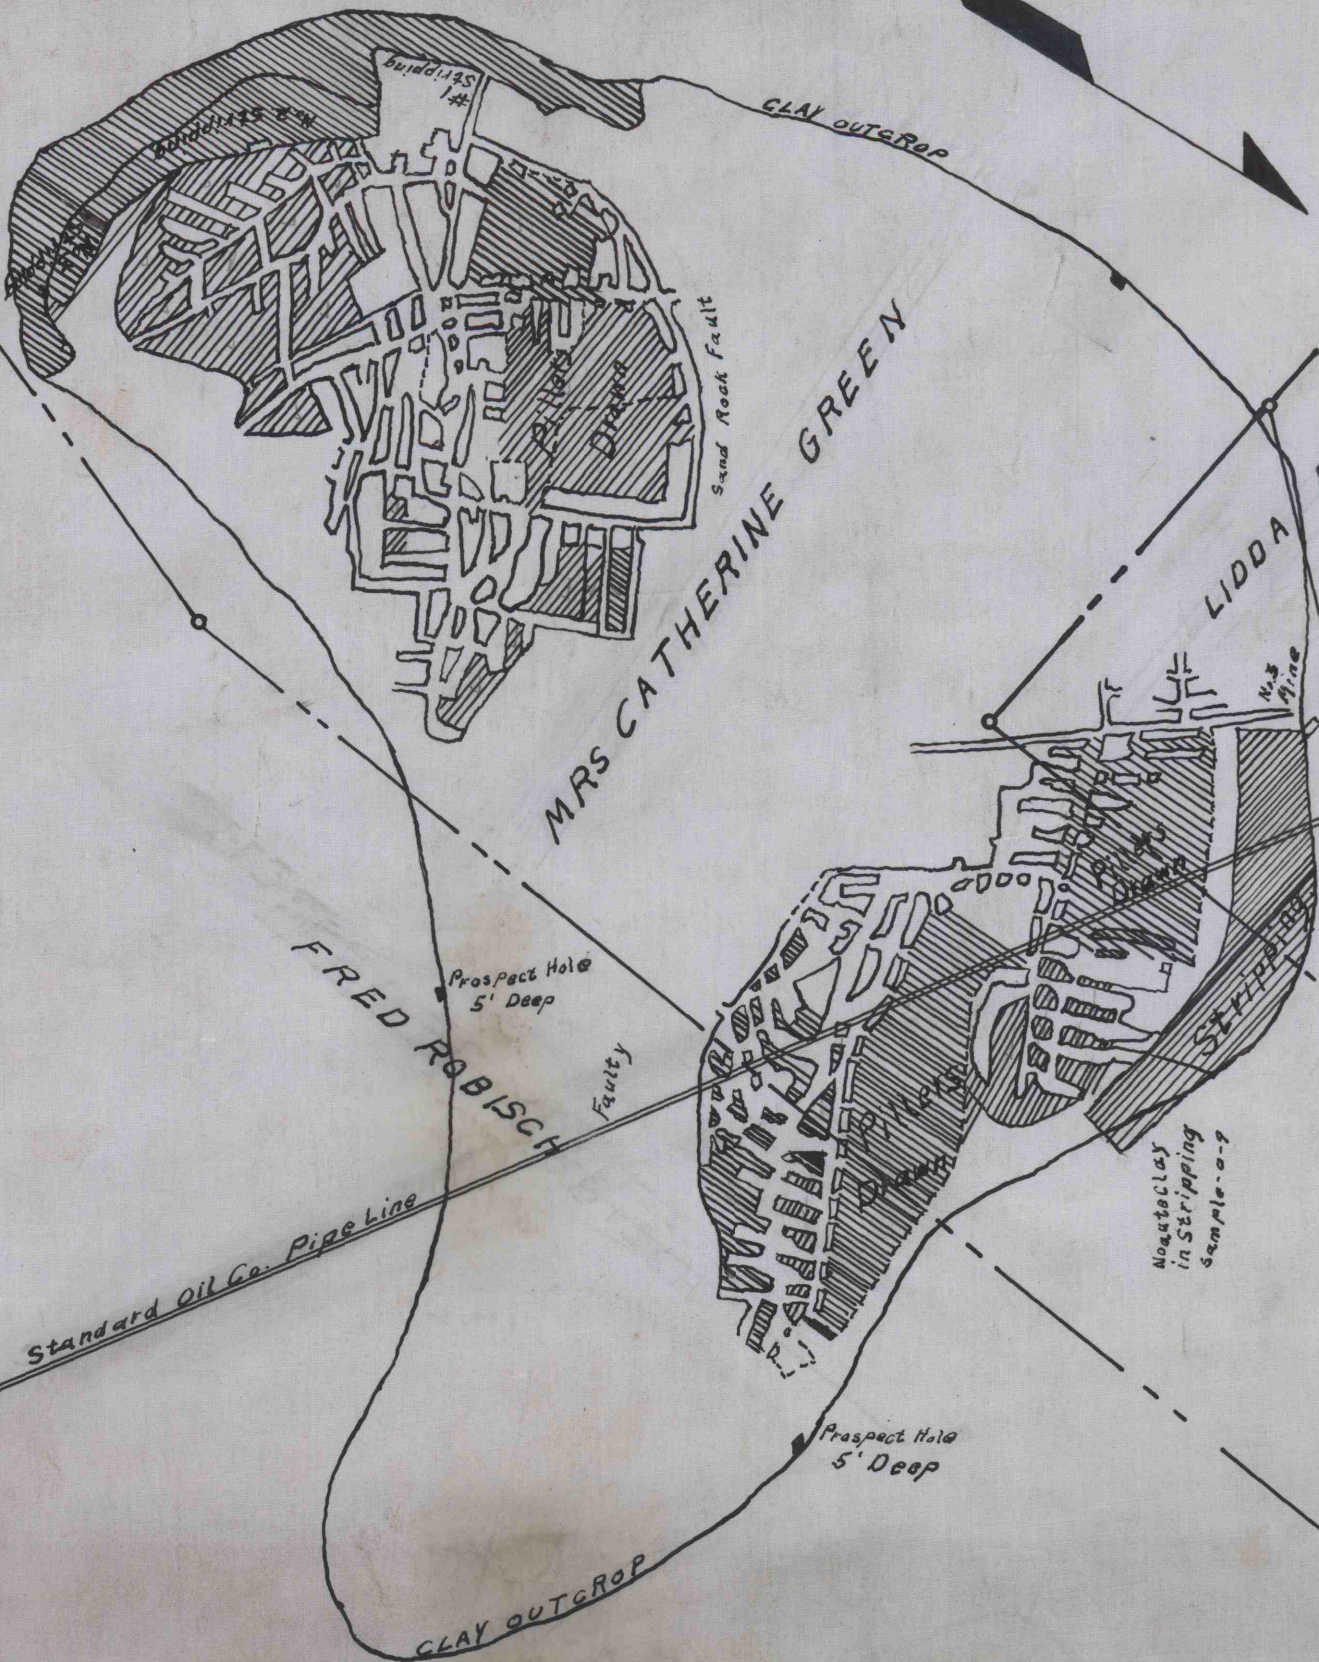

WORKED FROM *Sketch*

DRAWN BY *D.H.L.*

CHECKED BY