


2405

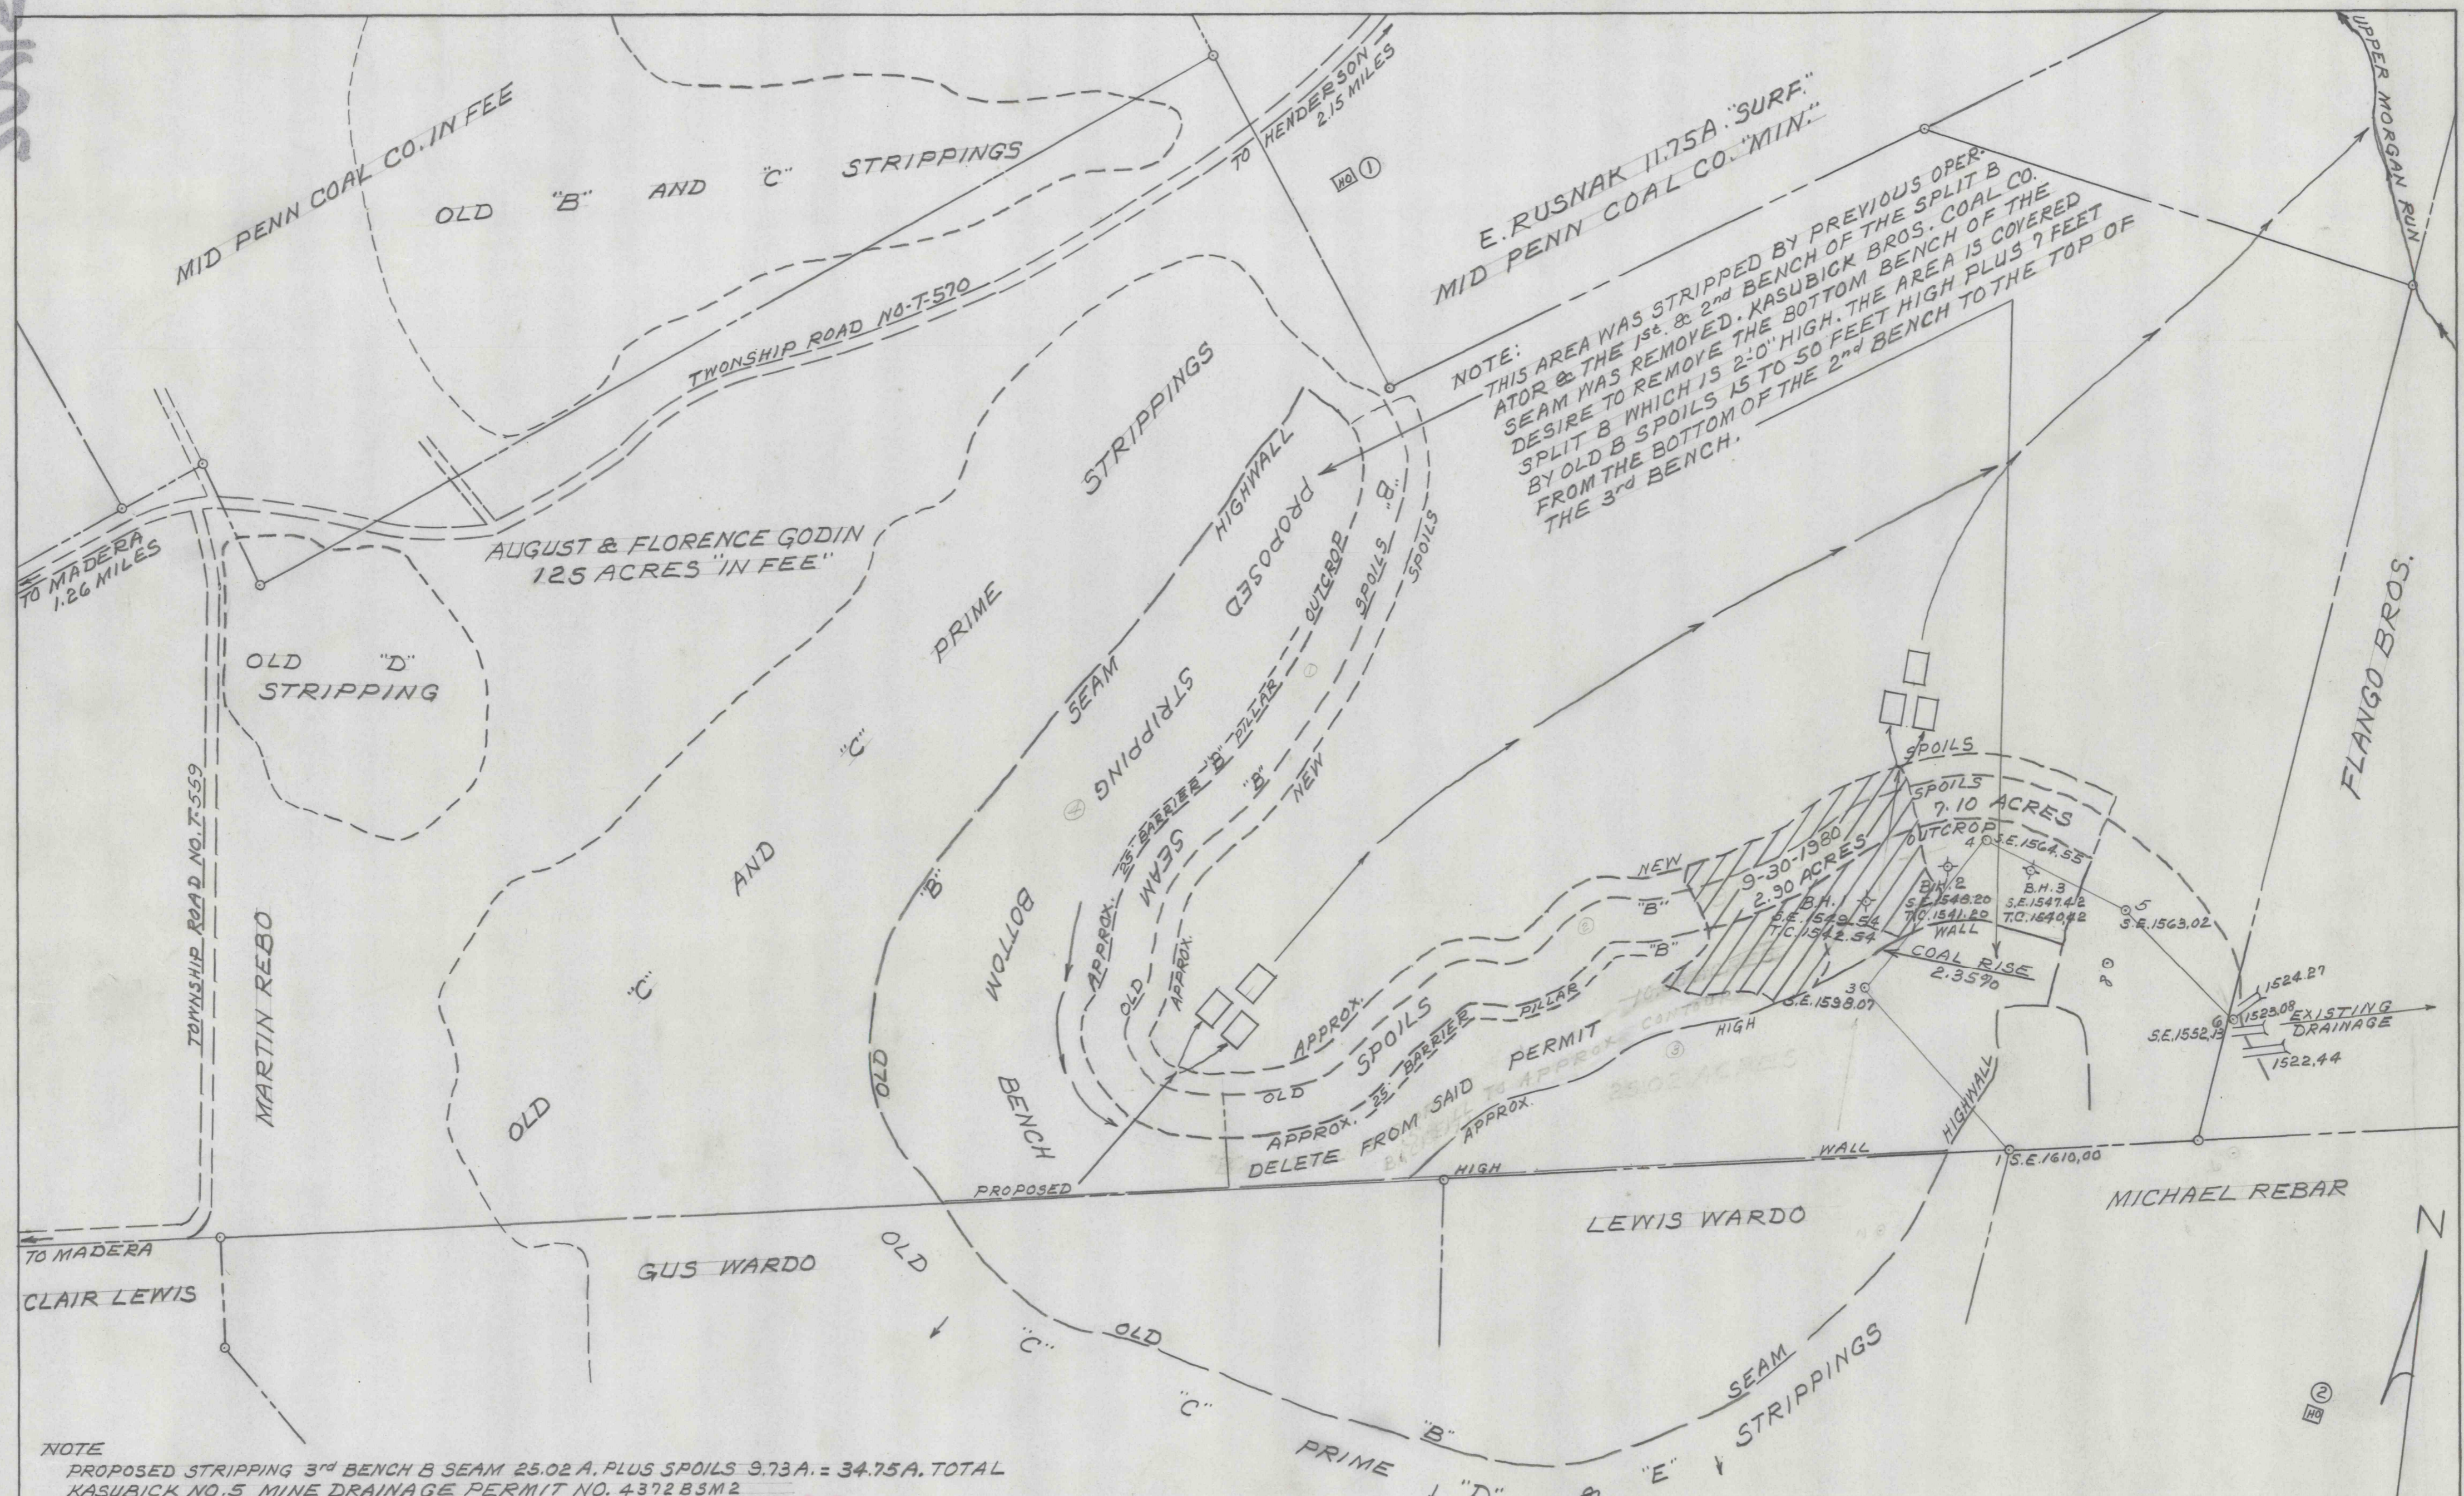

NOTE:
 THIS AREA WAS STRIPPED BY PREVIOUS OPERATOR & THE 1st & 2nd BENCH OF THE SPLIT B SEAM WAS REMOVED. KASUBICK BROS. COAL CO. DESIRE TO REMOVE THE BOTTOM BENCH OF THE SPLIT B WHICH IS 2'-0" HIGH. THE AREA IS COVERED BY OLD B SPOILS 15 TO 50 FEET HIGH PLUS 7 FEET FROM THE BOTTOM OF THE 2nd BENCH TO THE TOP OF THE 3rd BENCH.

NOTE
 PROPOSED STRIPPING 3rd BENCH B SEAM 25.02 A. PLUS SPOILS 9.73 A. = 34.75 A. TOTAL KASUBICK NO. 5 MINE DRAINAGE PERMIT NO. 4372 BSM 2

NOTE:
 10-31-72 ORIGINAL STRIPPING PERMIT 10.00 A. S.P. NO. 185-3 BOND U.S. 19858 - REPLACED BY BOND NO. 12426 8-27-76
 9-30-80 BACKFILLED, LEVELED 2.90 ACRES
 9-30-80 DELETE FROM SAID PERMIT 185-3 7.10 ACRES

MAP SHOWING PROPOSED "B" SEAM STRIPPING
 OPERATED BY KASUBICK BROS. COAL CO.
 BIGLER TOWNSHIP CLEARFIELD COUNTY PENNA.
 SCALE 1/2" = 200' FEB. 21, 1972
 BERNARD LUCAS ASSOC.

C.D. 596

185-72

2045