


8705

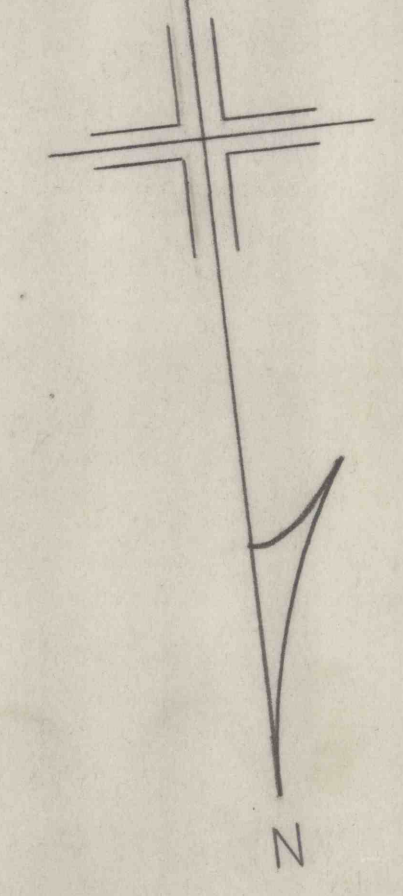

NOTE:  
 10-26-53 BACKFILLED LEVELED AND PLANTED 12.18 ACRES  
 PROPOSED STRIP 26.54 ACRES IN YELLOW  
 12-8-65 BACKFILLED AND LEVELED 5.00 ACRES NEW LAW  
 1ST AMENDMENT PROPOSED E STRIPPING 20 ACRES IN RED  
 12-18-66 BACKFILLED & LEVELED 55.68 ACRES IN YELLOW

M  
 MAP SHOWING STRIPPING OPERATIONS OF THE  
 FLANGO BROTHERS COAL MINING COMPANY  
 BECCARIA TWP. CLEARFIELD COUNTY PENNA.  
 SCALE 1" = 200' JAN. 29, 1959  
 BERNARD LUCAS ASSOC.

G.D. 569

2018