


PROS

L.C. HEGARTY

L.C. HEGARTY

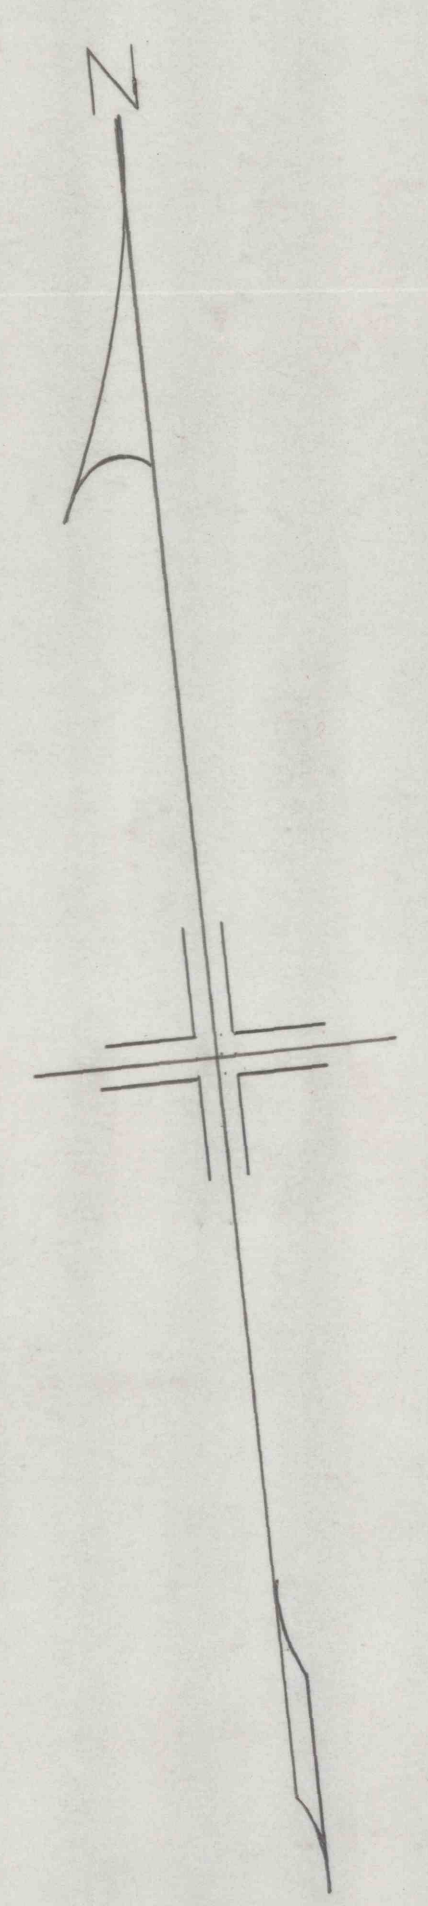

FOSTER GATES

ROSE FITCH

FRED SHOFF

FRED SHOFF

STATE ROAD ROUTE 90 12083

ROAD

MOSHANNON SMITHING COAL CORP.  
PER WALTER WILLIAMS

E. NEYLING

IRVIN MECOY

MECOY ESTATE

IRVIN MECOY

CLAIR SEMPLE

FRYBERGER

G. MULLEN

NOTE:  
CORRECTED ACREAGE AREA PLUS PROPOSED STRIPPING MAPS 1 AND 2 101.54 ACRES  
MAP NO. 2 75 ACRES  
MAP NO. 1 26.54 ACRES

NOTE:  
B & L & P = OLD ACREAGE BACKFILLED, LEVELED AND PLANTED  
B & L = ACREAGE BACKFILLED AND LEVELED ONLY  
7-22-65 B & L OLD LAW 13.22 ACRES PLUS 12-8-65 34.97 ACRES = 50.09 ACRES  
7-22-65 B & L NEW LAW 20.65 ACRES PLUS 12-8-65 23.64 ACRES = 44.29 ACRES  
6-23-67 B & L NEW LAW 30.71 ACRES  
6-23-67 B & L OLD LAW 1.72 ACRES

MAP SHOWING STRIPPING OPERATIONS OF THE  
FLANGO BROTHERS COAL COMPANY  
BECCARIA TOWNSHIP CLEARFIELD COUNTY PENNA.  
SCALE 1/4" = 200' JULY 26, 1965  
BERNARD LUCAS ASSOC.

C.D. 569

MAP 2 OF 2

2079