


51015

2107

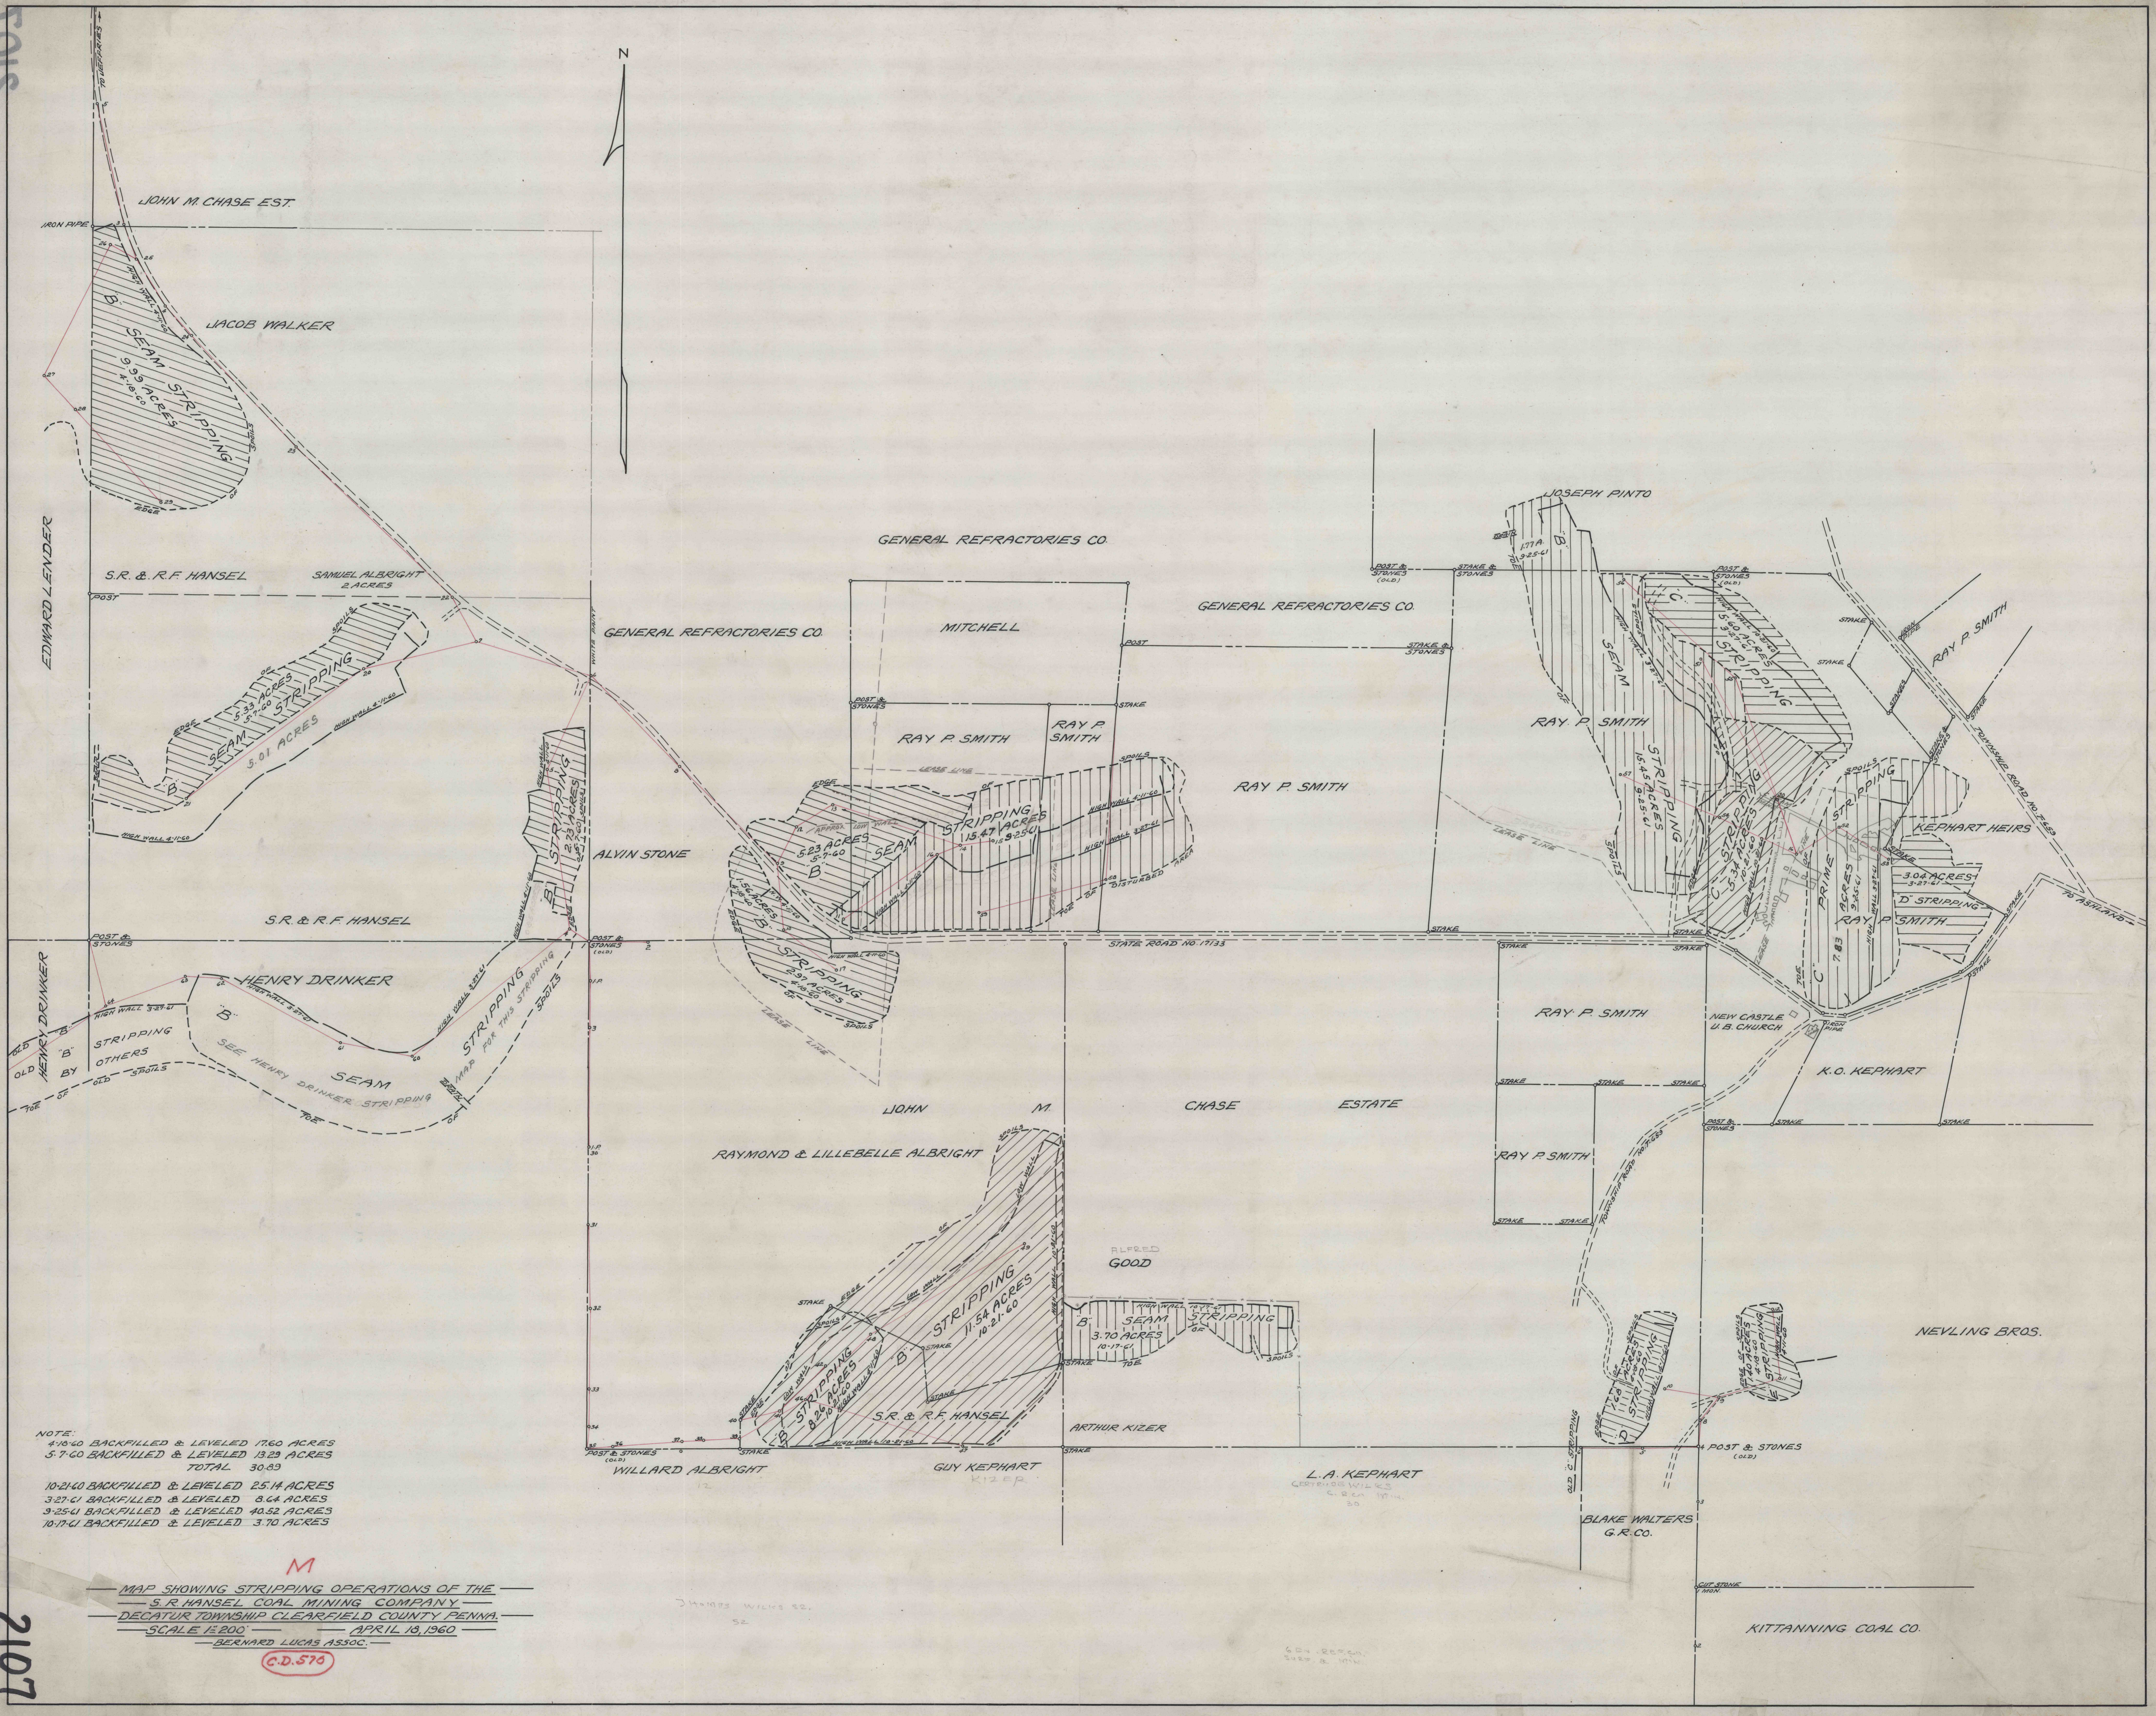

NOTE:
 4-10-60 BACKFILLED & LEVELED 17.60 ACRES
 5-7-60 BACKFILLED & LEVELED 13.29 ACRES
 TOTAL 30.89
 10-21-60 BACKFILLED & LEVELED 25.14 ACRES
 3-27-61 BACKFILLED & LEVELED 8.64 ACRES
 3-25-61 BACKFILLED & LEVELED 40.52 ACRES
 10-17-61 BACKFILLED & LEVELED 3.70 ACRES

M
 MAP SHOWING STRIPPING OPERATIONS OF THE
 S.R. HANSEL COAL MINING COMPANY
 DECATUR TOWNSHIP CLEARFIELD COUNTY PENN.
 BERNARD LUCAS ASSOC.

C.D. 570

J. HANCOCK WILKS CO.

604 REEFER
5100 S. 10th

KITTANNING COAL CO.