

STATE GAME LANDS

PHILIPSBURG BOY SCOUTS

C. EHLER TRACT

JACOB DILLER TRACT  
JOSEPH MULSON COAL & SURFACE

WOMELSDORFF & DUNKLE

W.W. STARK

WOMELSDORFF & DUNKLE

10°15'N


HENRY PINKERTON TRACT

10°15'E

HUGH MCINTYRE

2118

2118

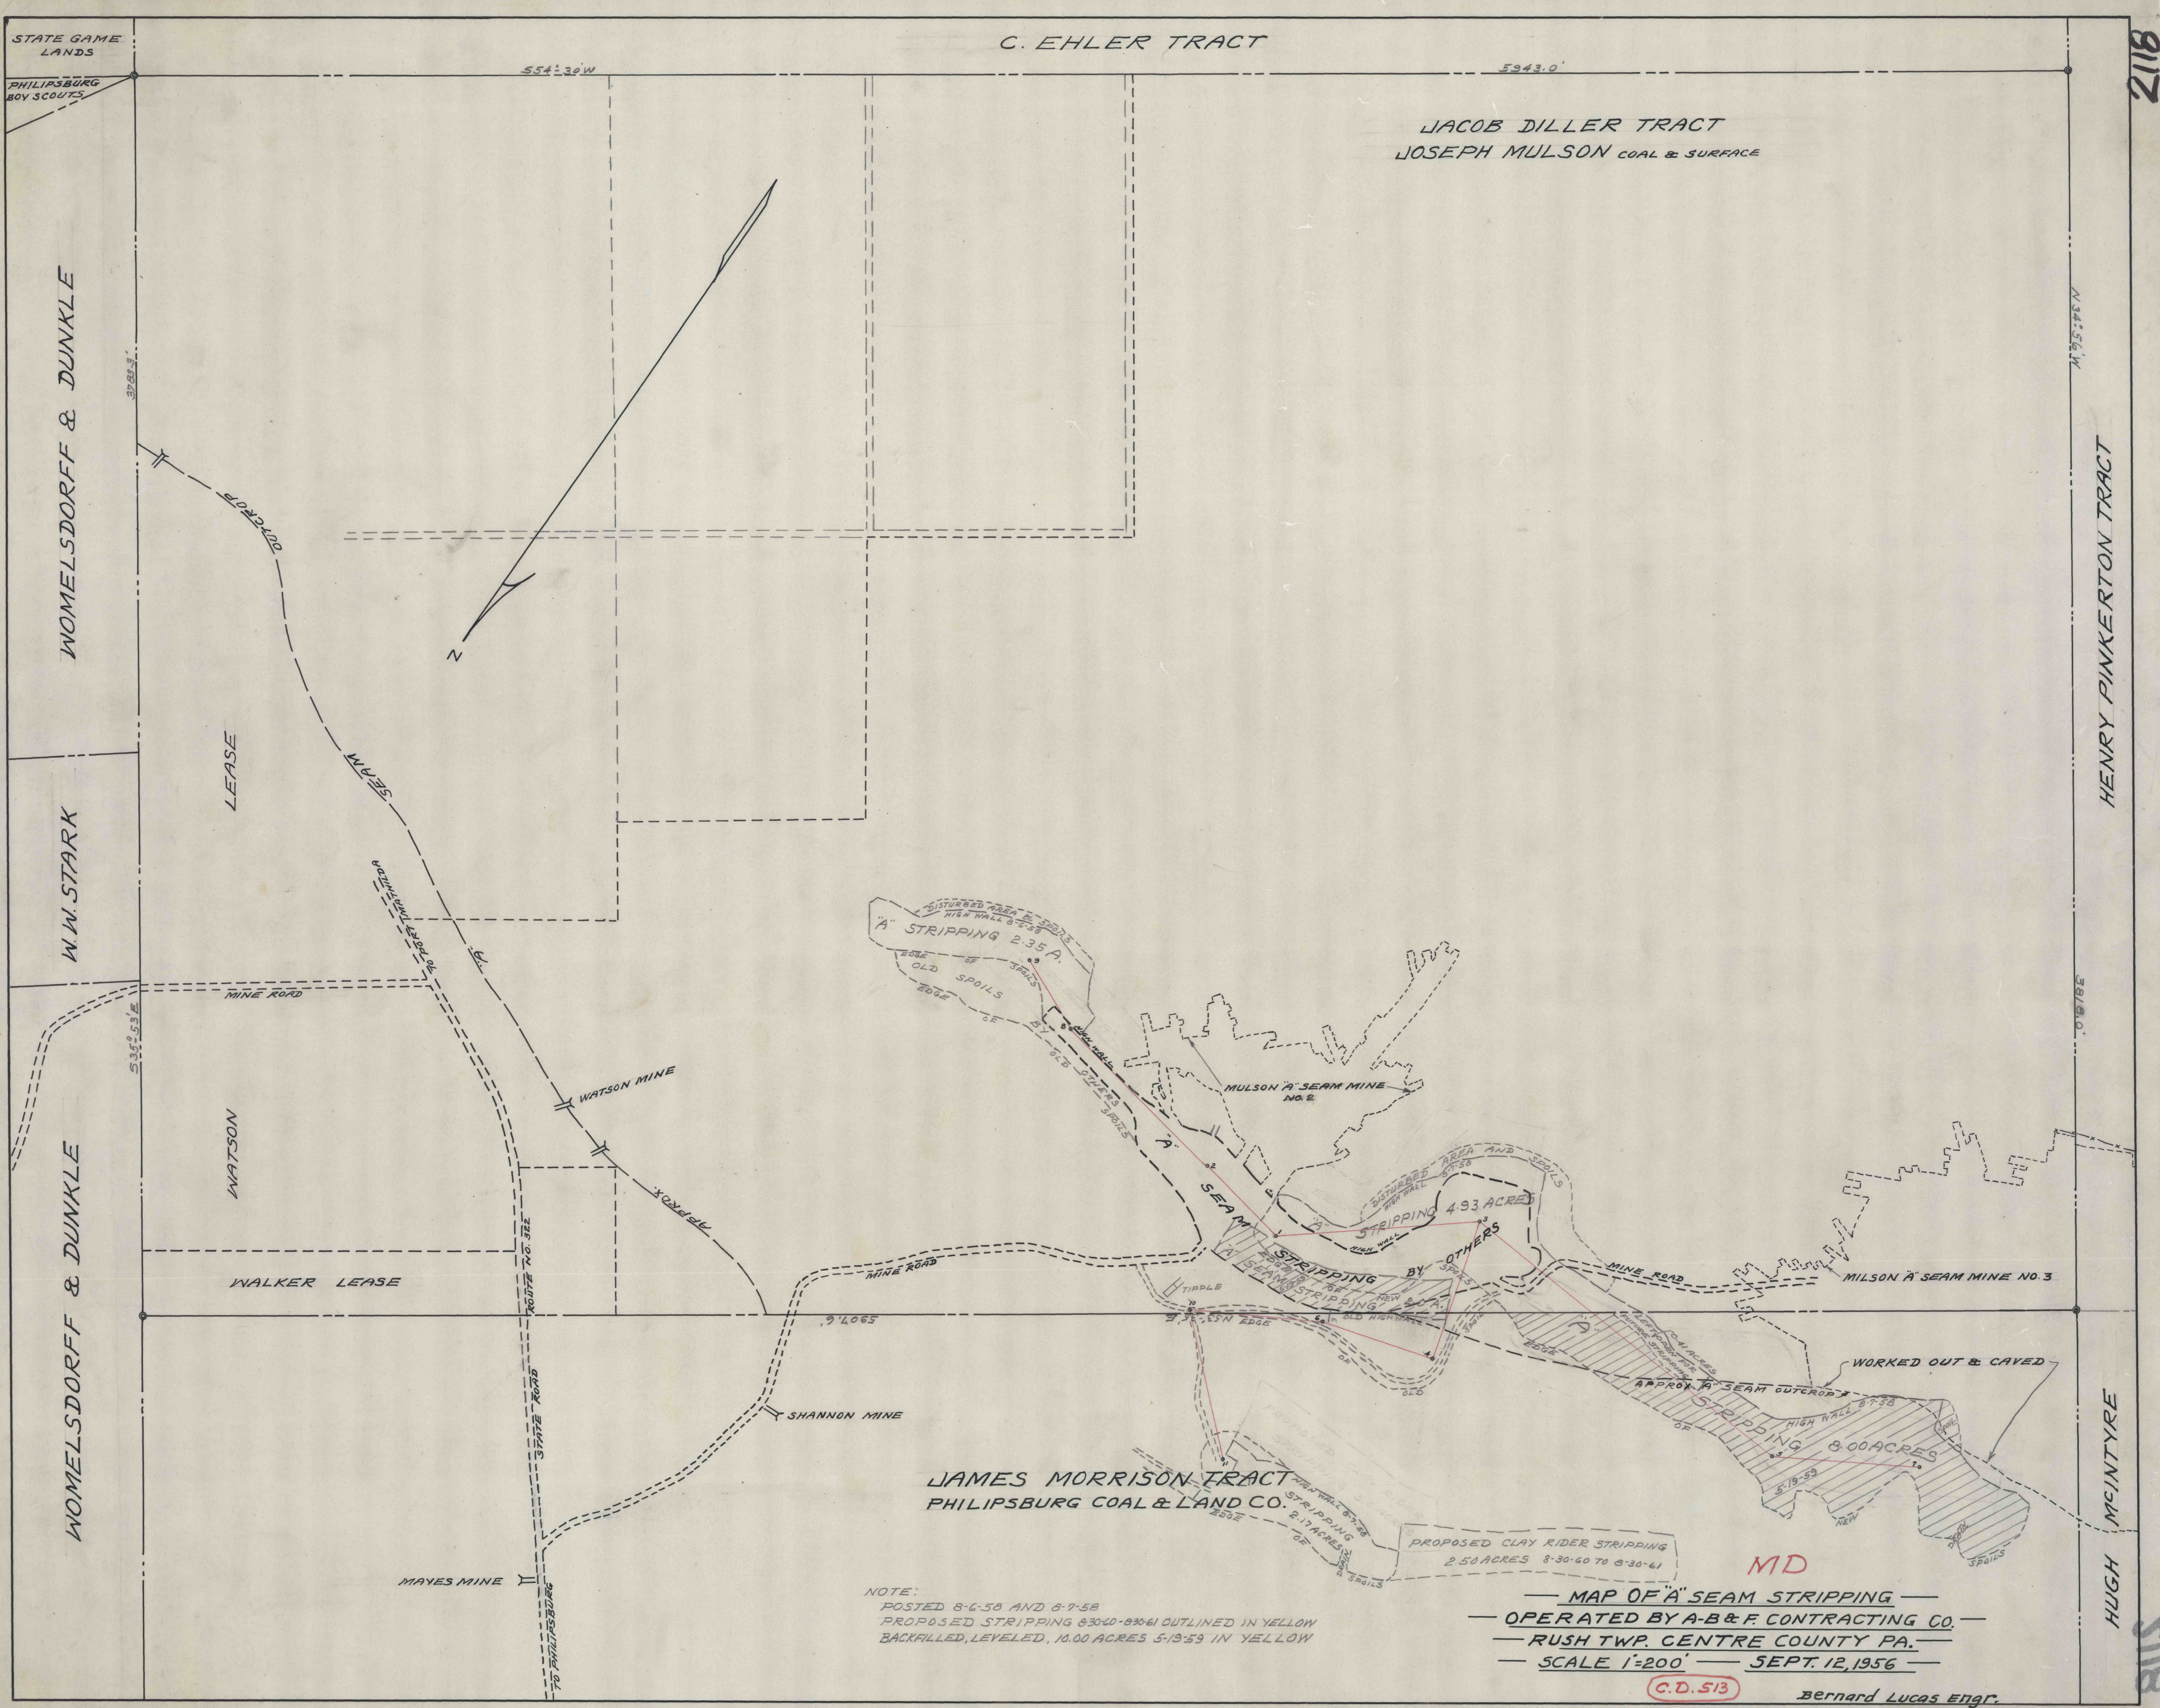

NOTE:  
 POSTED 8-6-58 AND 8-9-58  
 PROPOSED STRIPPING 8-30-60-8-30-61 OUTLINED IN YELLOW  
 BACKFILLED, LEVELED, 10.00 ACRES 5-13-59 IN YELLOW

— MAP OF A SEAM STRIPPING —  
 — OPERATED BY A-B & F CONTRACTING CO. —  
 — RUSH TWP. CENTRE COUNTY PA. —  
 — SCALE 1"=200' — SEPT. 12, 1956

C.D. 513

Bernard Lucas ENGR.