

181

2137

A. J. FRY
147.59 ACRES

DOROTHY SEARLS



MILES DAVIS

A. P. DAVIS TRACT
104 ACRES

JACOB MATTHEWS

JOHN E. HERDMAN
207 ACRES

D.K. RAMEY ESTATE

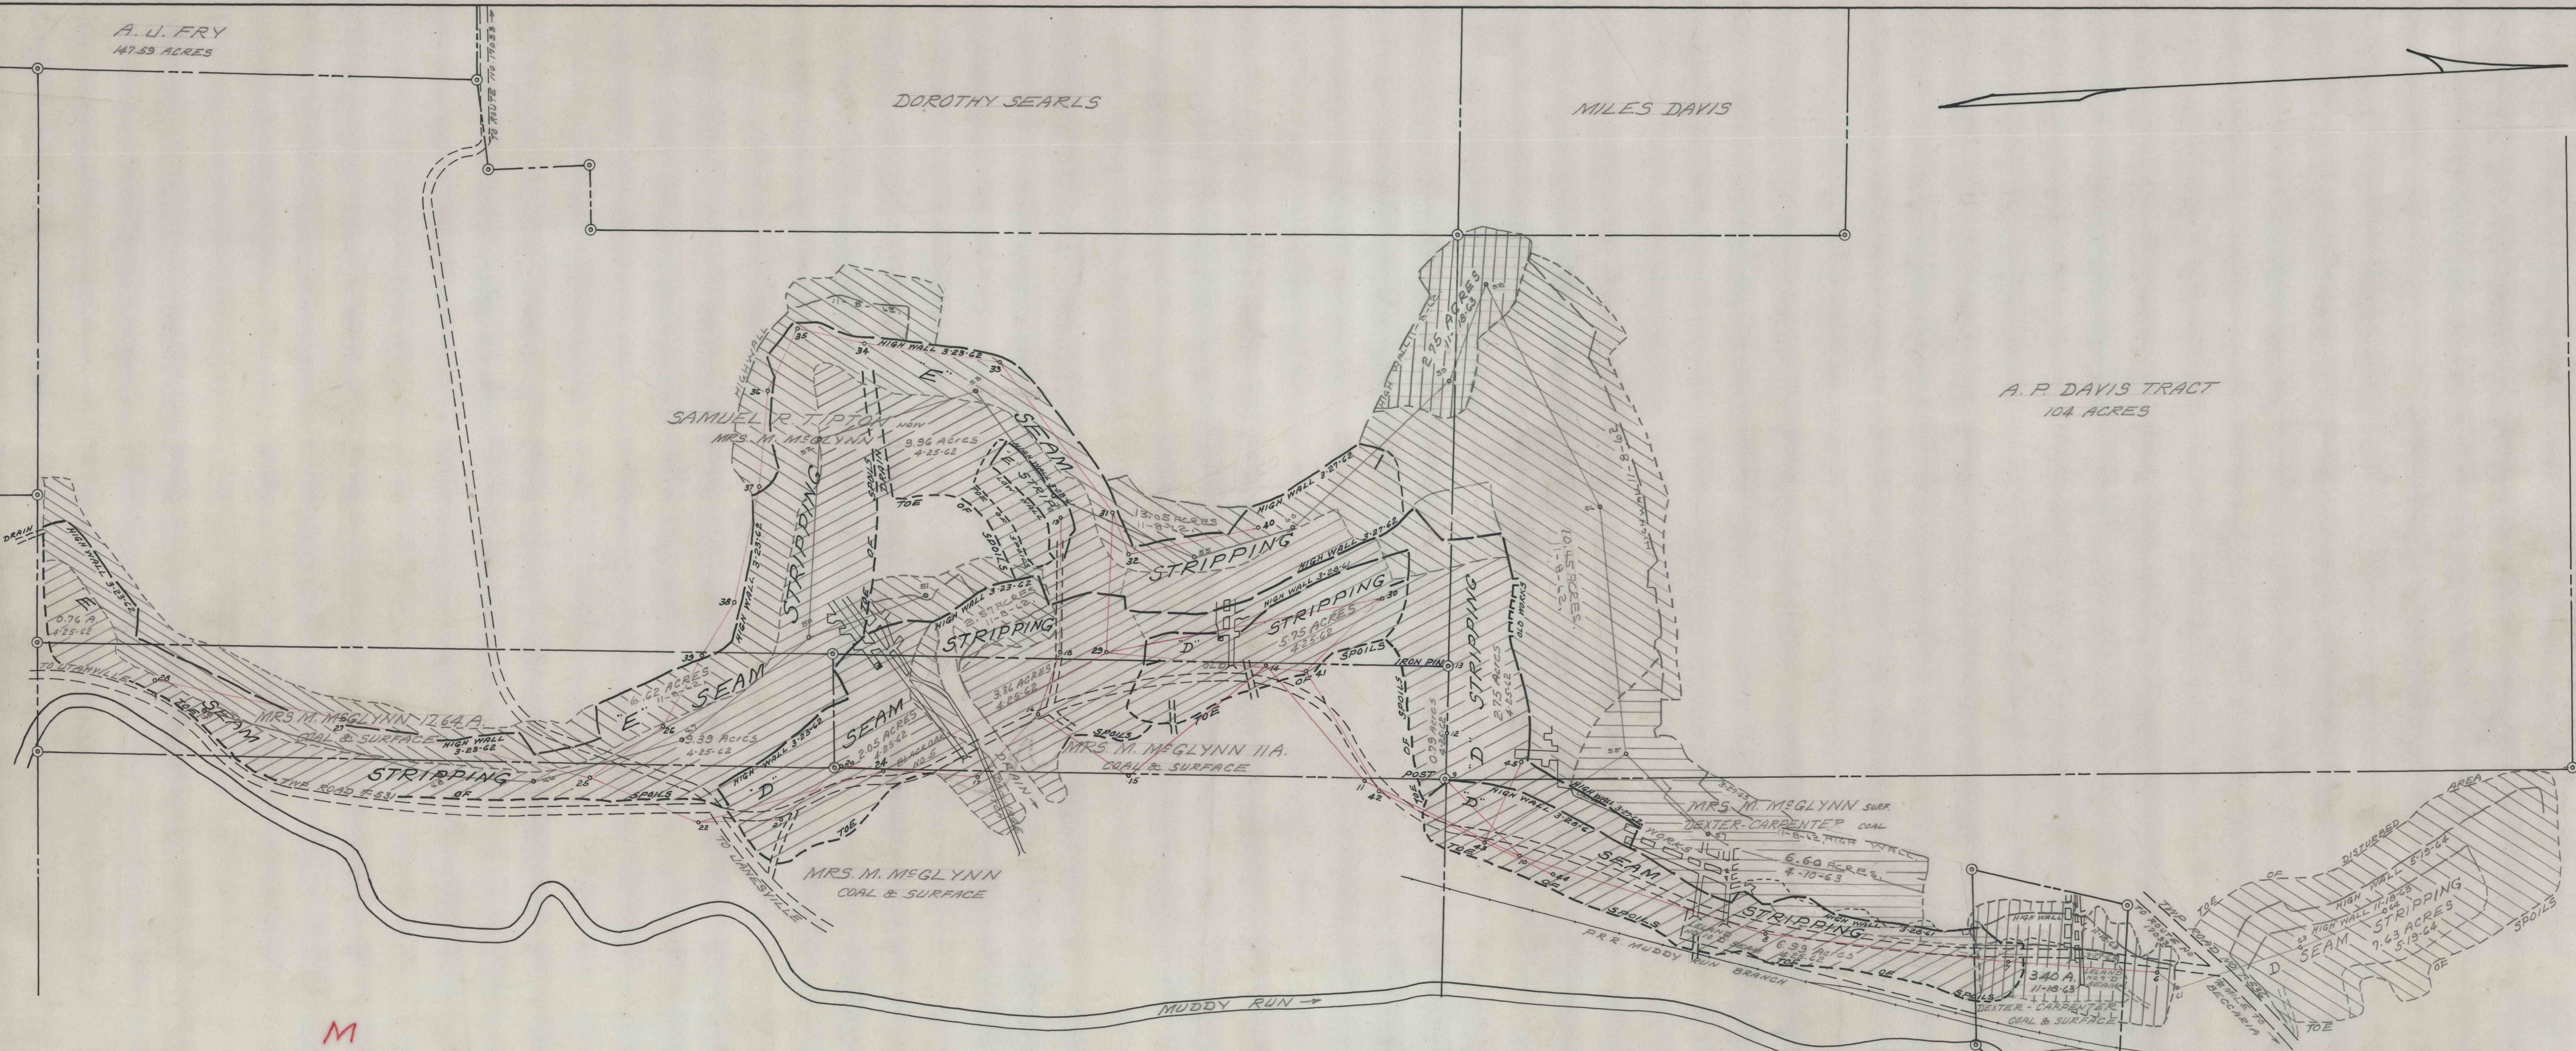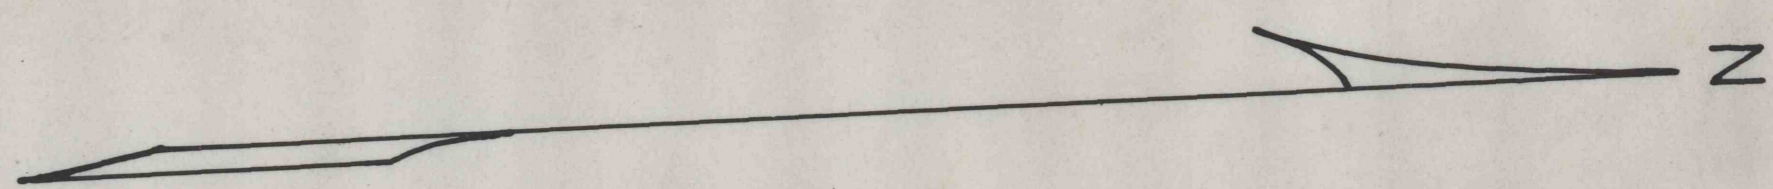

M
— MAP SHOWING "D" SEAM STRIPPING —
— OPERATED BY S.R. HANSEL COAL MINING COMPANY —
— BECCARIA TWP CLEARFIELD COUNTY PENNA. —
— SCALE 1" = 200' — FEB. 15, 1961 —
— BERNARD LUCAS ASSOCIATES —

NOTE:
4-25-62 BACKFILLED AND LEVELED 42.30 ACRES
11-8-62 " " " 32.69 ACRES
4-10-63 BACKFILLED AND LEVELED 6.60 ACRES
11-18-63 BACKFILLED LEVELED & PLANTED 6.15 ACRES
5-19-64 BACKFILLED LEVELED & PLANTED 7.63 ACRES OLD LAW.

C.D. 581