


5115

GENERAL REFRACTORIES CO.

MILES MEASE

C. KRAUSE

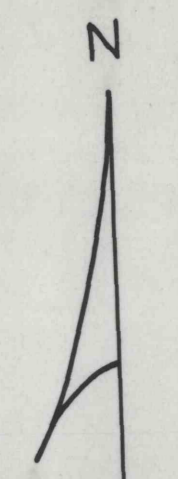

JOHN PINTO
32 ACRES SURF.

JOSEPH
SEAM

PINTO SURF.

G.W. KEPHART

RAY P. SMITH

HERMAN KEPHART

RAY P. SMITH

JOSEPH PINTO SURF.

4.05
ACRES
8-29-62

8.83 ACRES
5-17-63

19.56 ACRES
10-15-62

2.04 ACRES
10-15-62

RAY P. SMITH

ISAIAH KEPHART

RAY P. SMITH

5.48 ACRES
4-3-62

9.51 ACRES
4-3-62

JESSE YARGER
30 ACRES SURF.

TO JEFFRIES

RAY P. SMITH

NEW CASTLE U.B. CHURCH
ROAD NO. 54

K.O. KEPHART

NEVLING ESTATE

M. WALKER

I. WINTERS

ASHLAND

NOTE:

9-13-60 STRIPPINGS BY THOMPSON AND PHILLIPS OUTLINED IN RED	
4-3-62 BACKFILLED & LEVELED	26.10 ACRES
8-23-62 BACKFILLED & LEVELED	22.29 ACRES
10-15-62 BACKFILLED & LEVELED	21.60 ACRES
5-17-63 BACKFILLED & LEVELED	8.83 ACRES
4-5-67 BACKFILLED & LEVELED	7.14 ACRES

M

MAP SHOWING STRIPPING OPERATIONS OF
THOMPSON & PHILLIPS COAL AND CLAY COMPANY INC.
DECATUR TWP. CLEARFIELD COUNTY PENNA.
SCALE 1/2" = 200' FEB. 5, 1960
BERNARD LUCAS ASSOC.

C.D. 599

2174