


1815

2181

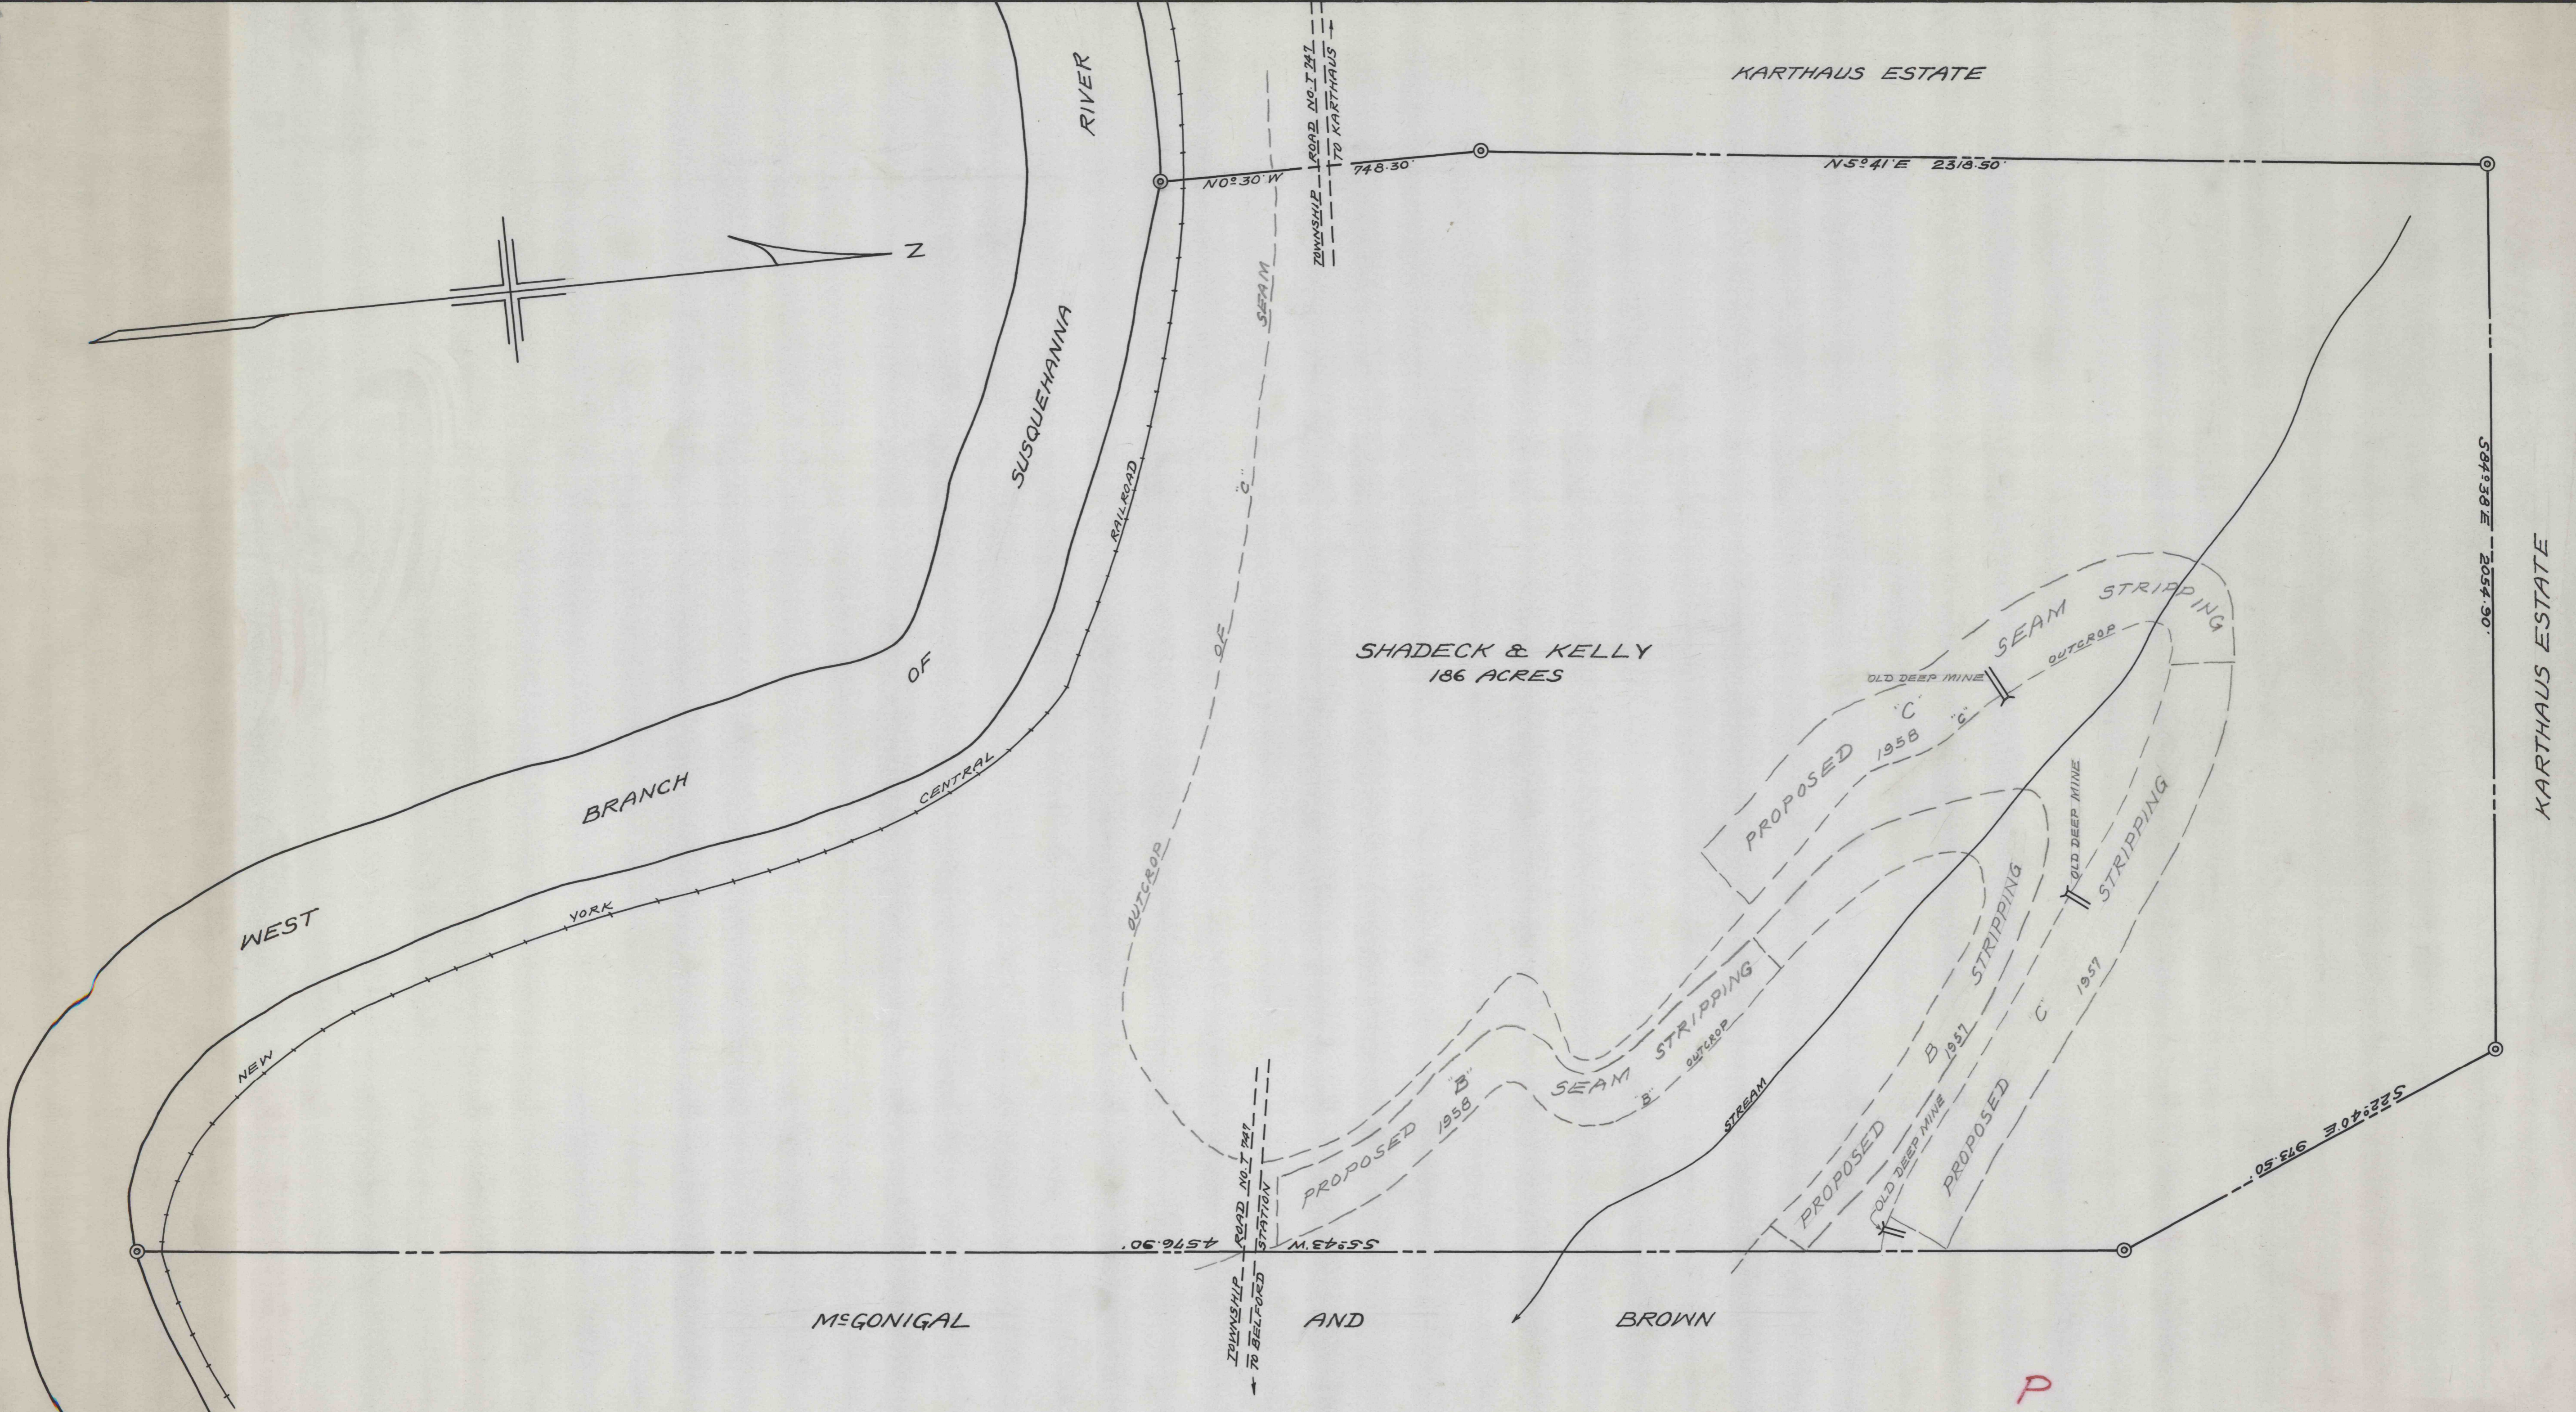

— MAP SHOWING "B" & "C" SEAM STRIPPINGS —
 — OPERATED BY SEPRISH & URBANICK COAL COMPANY —
 — KARTHAUS TWP. CLEARFIELD COUNTY PENNA. —
 — SCALE 1" = 200' — FEB. 6, 1957 —
 — BERNARD LUCAS ASSOC. — **C.D. 535**

P