


C.B.C. COMPANY

C.B.C. COMPANY

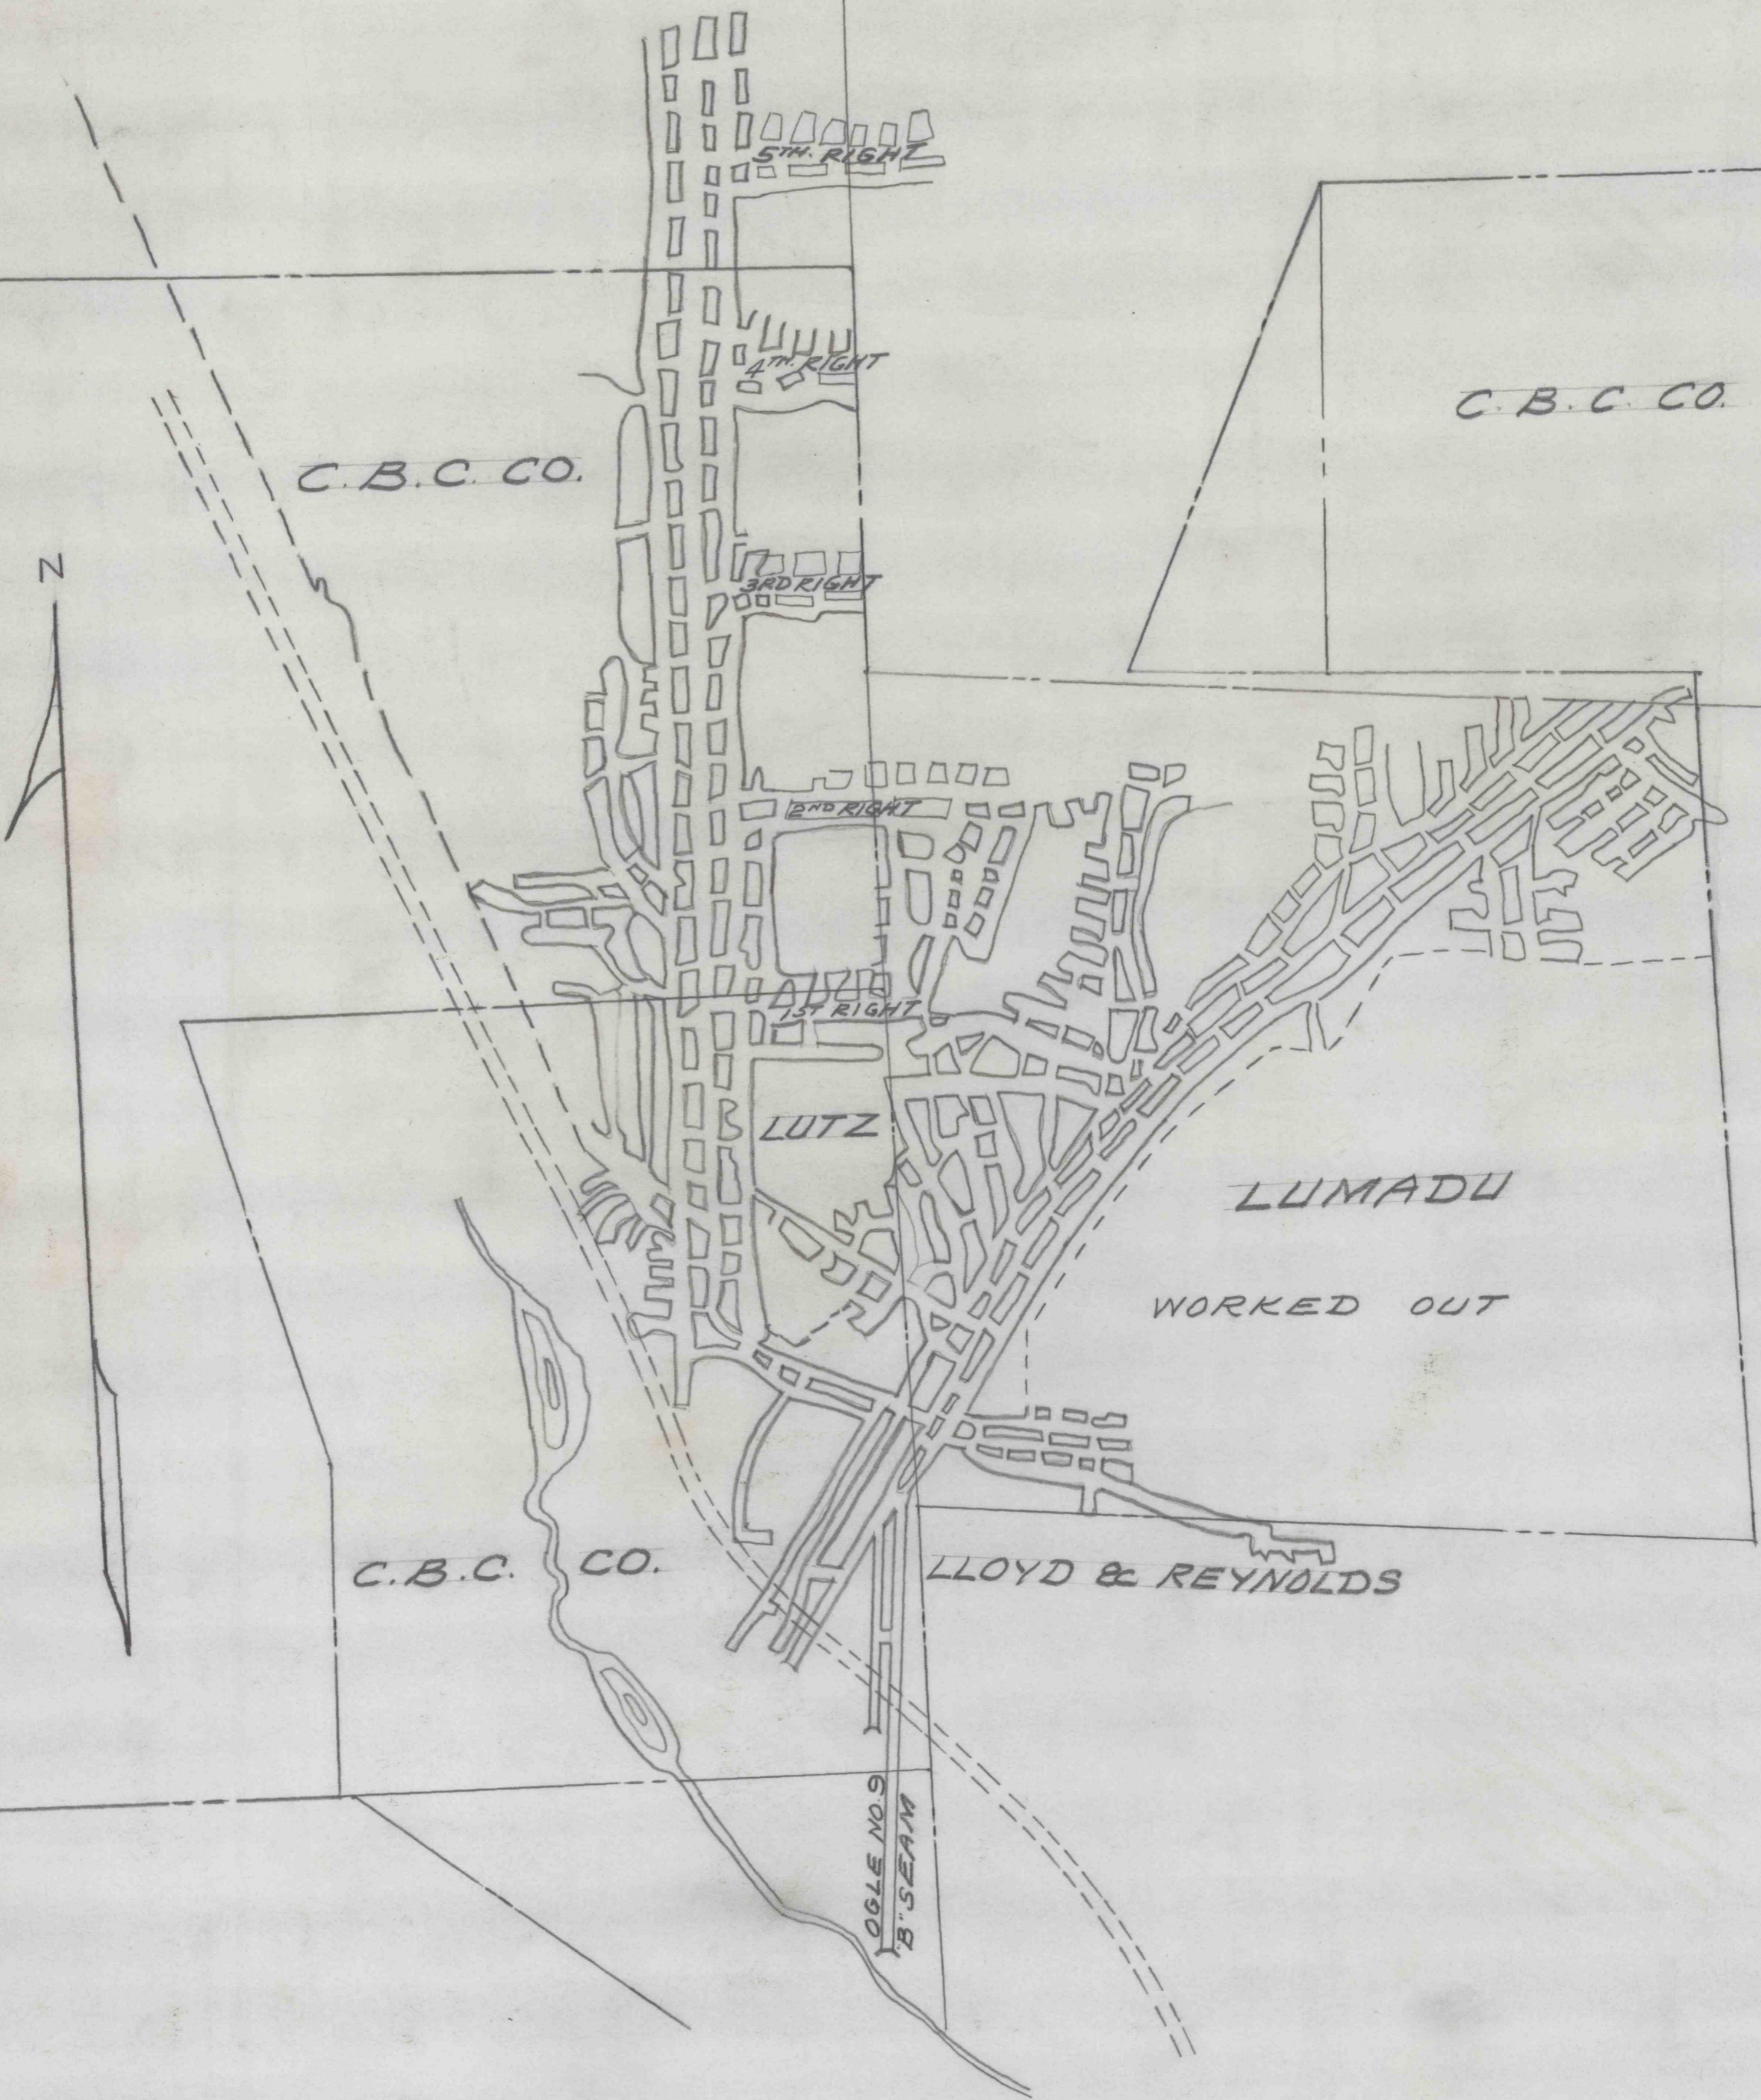

D

— MAP SHOWING PORTION OF OGLE NO. 9 MINE —  
 — OPERATED BY K. & R. COAL COMPANY —  
 — COOPER TWP CLEARFIELD COUNTY PENNA —  
 — SCALE 1" = 200' — — OCT. 3, 1957 —  
 — BERNARD LUCAS ASSOC. —

C.D. 501

2185

2186