


1815

2187

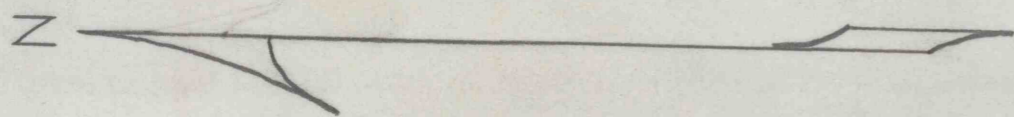

TO ROLLING STONE

STATE HIGHWAY ROUTE NO. 17067 TO KYLERTOWN

JACKSON HOOVER

ANDERSON LUTZ


OLD WORKS

STRIPPING

B HIGHWAY

FAULTY

0-70

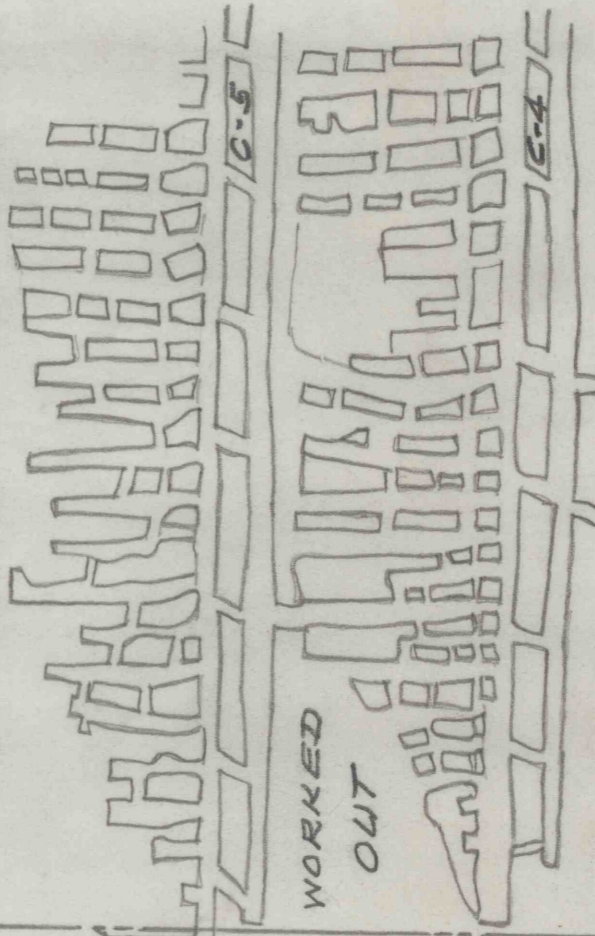

WORKS

OLD

FRED MOORE

NEW 'B' DRIFT

D

— MAP SHOWING PORTION OF OGLE NO. 9 MINE —  
 — OPERATED BY L. & E. COAL COMPANY —  
 — COOPER TWP. CLEARFIELD COUNTY PENNA. —  
 — SCALE 1" = 200' — — OCT. 3 1957 —  
 — BERNARD LUCAS ASSOC. —

C.D. 501