

1052

2251

JOSEPH GOSS


EDMUND WARING

WALTER B. & JOSEPHINE H. GRAY NOW LEROY THOMPSON

W. D. LITTLE SHAW

W. I. THOMPSON NOW LEROY THOMPSON

JOHN MASON

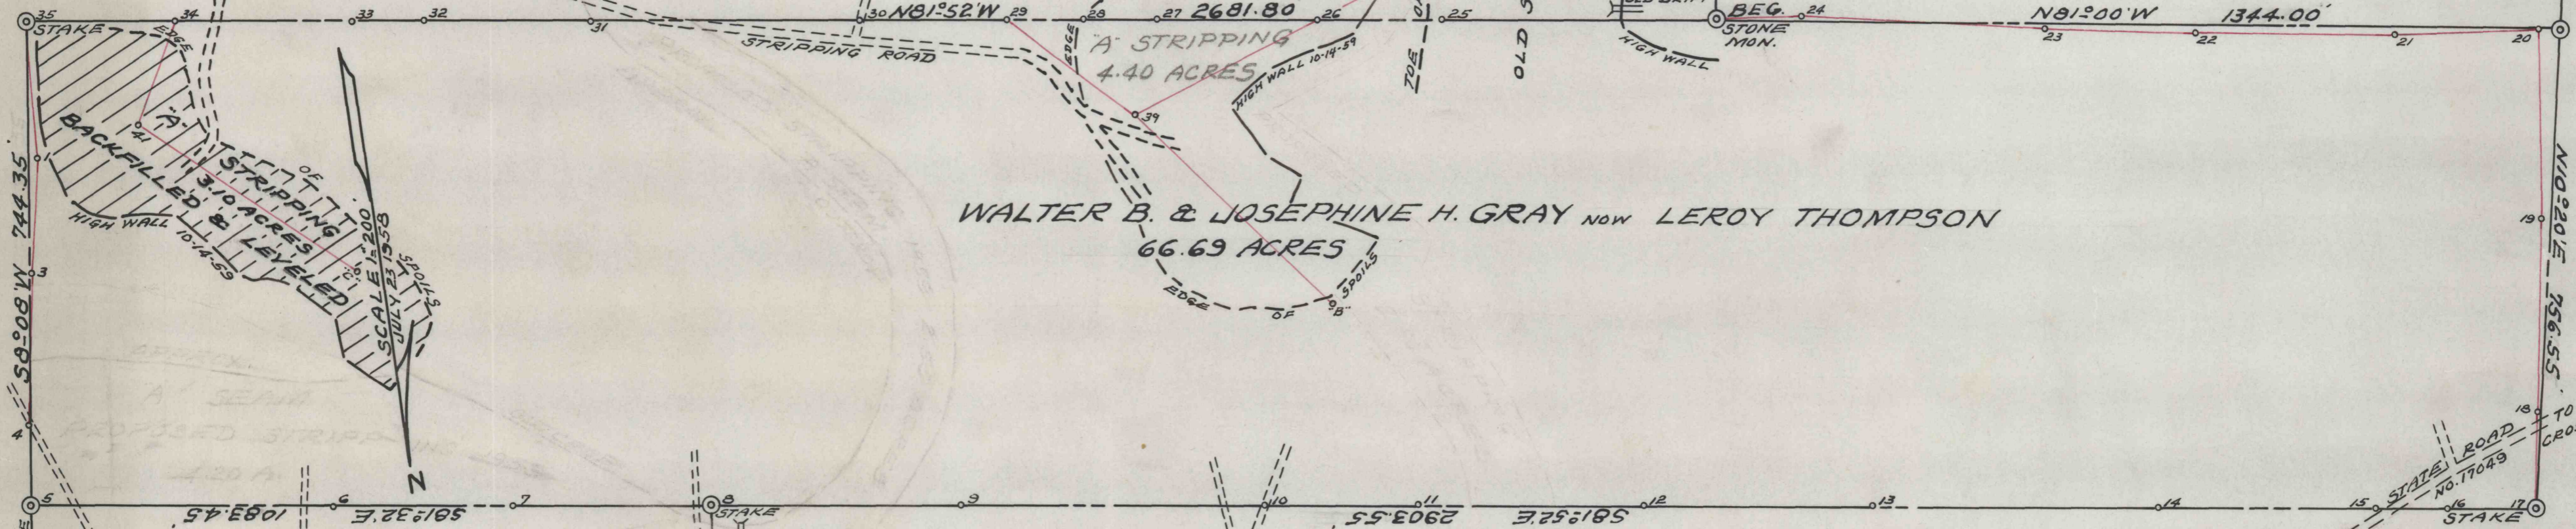

— MAP SHOWING "A" SEAM STRIPPING OPERATION —  
 — OF THE THOMPSON COAL COMPANY —  
 — DECATUR TOWNSHIP CLEARFIELD COUNTY PENNA —  
 — SCALE 1" = 200' — — OCT. 28, 1958 —

Bernard Lucas Assoc.