


8185

2313

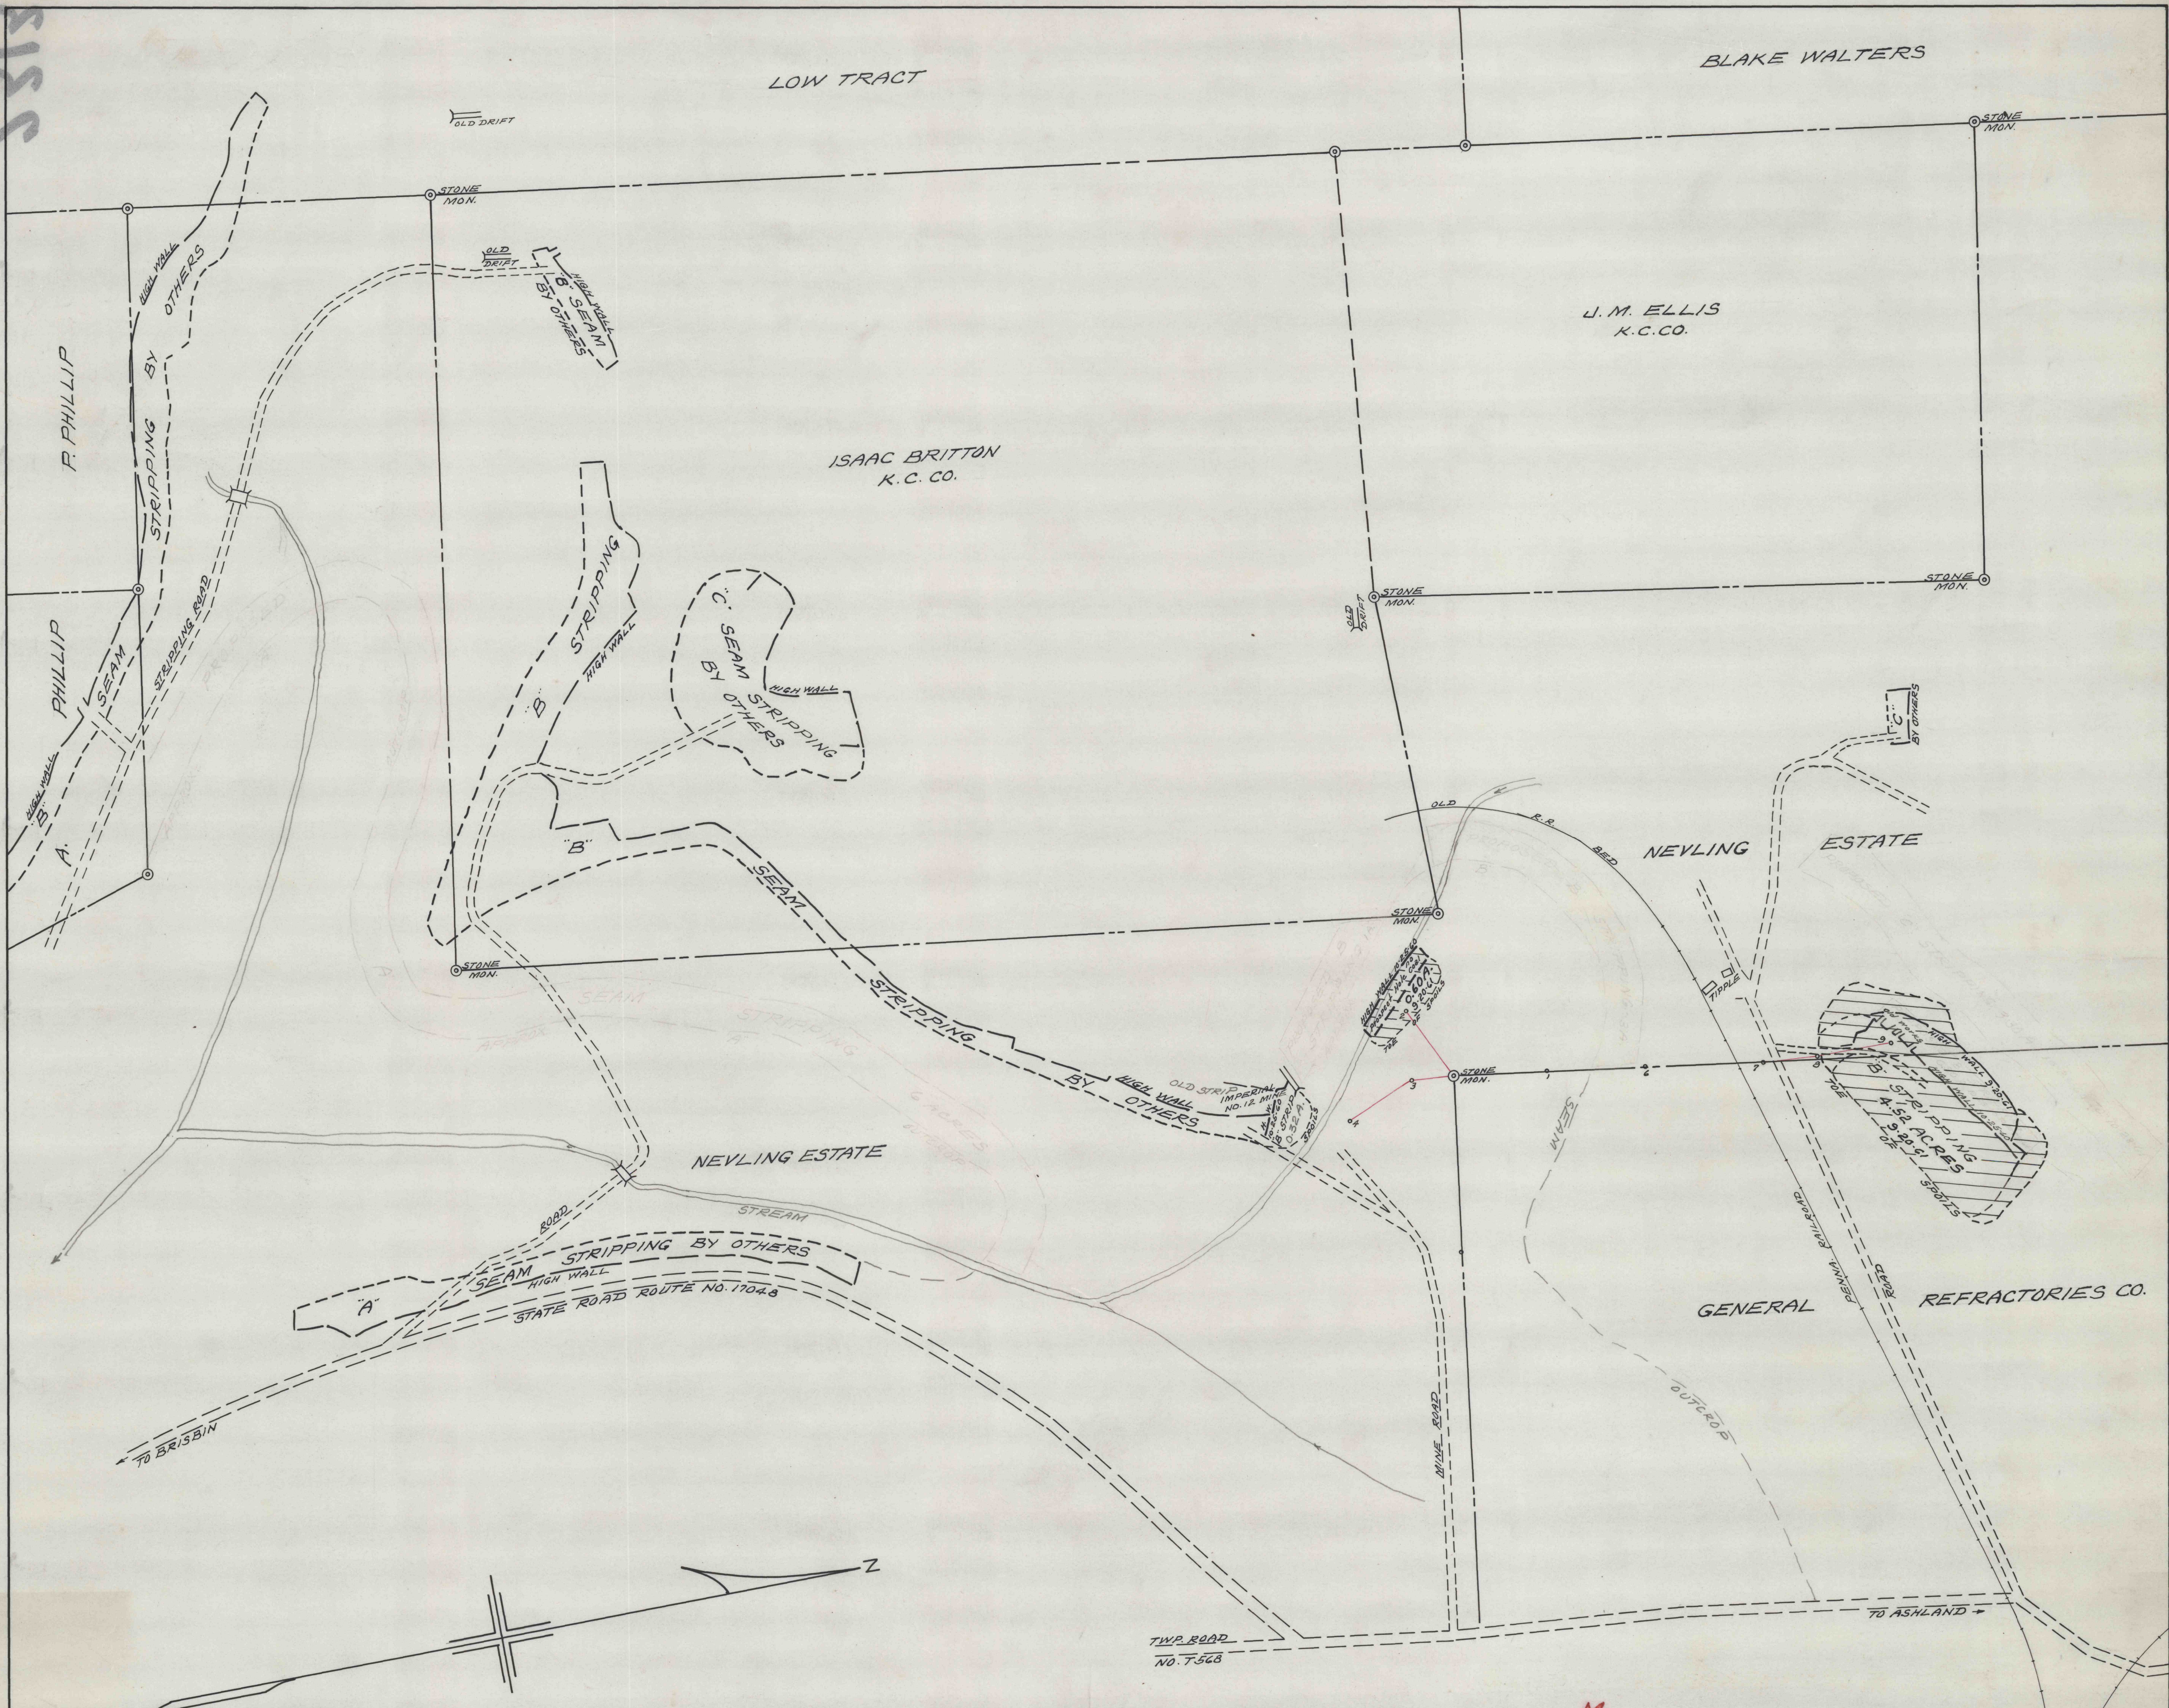

NOTE:  
 3-20-61 BACKFILLED & LEVELED 5.12 ACRES

**M**

— MAP SHOWING "A" AND "B" SEAM STRIPPINGS —  
 — OPERATED BY WILKS BROS. STRIPPING CO. —  
 — DECATUR TWP. CLEARFIELD COUNTY PENNA. —  
 — SCALE 1" = 200' — JUNE 12, 1959 —  
 — BERNARD LUCAS ASSOC. —  
 (C.D. 224)