
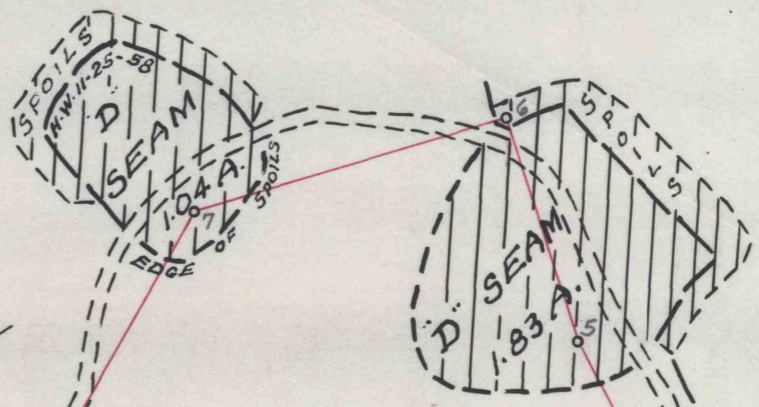


HUGH RALSTON TRACT

BERWIN WHITE COAL CO.

KITTANING COAL COMPANY

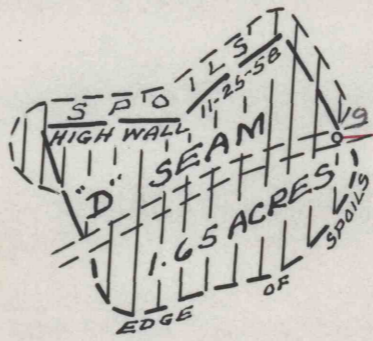

NOTE:
BACKFILLED & LEVELED 4.52 ACRES

NEVLING BROS.
GENERAL REFACTORIES

STONE MON.

STONE MON.

STONE MON.

NEVLING BROS.

TIPPLE

IMPERIAL NO. 12 MINE

STONE MON.

GENERAL REFACTORIES

— MAP SHOWING 'D' SEAM STRIPPING —
 — OPERATED BY JOSEPH A. PADISAK —
 — DECATUR TWP. CLEARFIELD COUNTY PA. —
 — SCALE 1"=200' — NOV. 28, 1958 —
 — BERNARD LUCAS ASSOC. —

C.D. 224

MINE ROAD

STATE ROAD ROUTE NO. TO BRISBIN TO ASHLAND

PENNA. RR. ROAD

PIES

2319