


2347

BIGLER



APPROXIMATE LOCATION:
LATITUDE = 41° 00'
LONGITUDE = 78° 17'

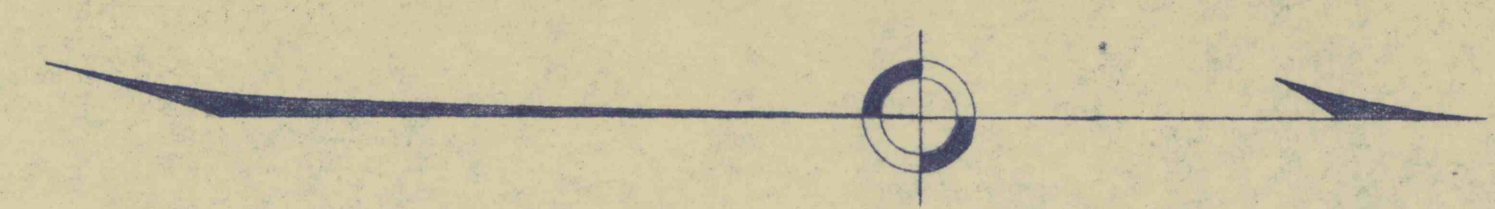

NOTE:-

1. TOTAL AFFECTED AREA = 1.4 + 70.5 + 1.6 + 5.6 + 9.3 + 12 + 3.5 + 2.0 = 23.4 A (UNDER ACT).
2. UPPER VEIN = MIDDLE KITTINGING, 'C' COAL.
3. LOWER VEIN = LOWER KITTINGING, 'B' COAL.
4. OPERATION BEGAN FEB. 1945.
5. COMPLETE SOIL BANK SHOWN. TOTAL AREA OF SOIL = 57 ACRES.
6. CROSS-HATCHED AREA SHOWS AREA FROM WHICH COAL WAS REMOVED.
7. OUTSIDE SPOIL AND INSIDE SPOIL LINES ARE SHOWN DOTTED AND NOTED.
8. DOUBLE CROSS-HATCHED AREAS WERE STRIPPED BEFORE THE ACT.
9. TOTAL ACREAGE OF COAL REMOVED = 23.4 + 1.11 + 1.8 + 2.0 + 9.1 + 3.6 + 9 = 32.1 ACRES.

PM

BRADFORD COAL CO.
BIGLER, PA.

C.D. 548

COMPLETION MAP SHOWING STRIP MINE OPERATIONS IN BRADFORD TOWNSHIP, CLIFD. COUNTY, ON PROPERTIES NOTED ABOVE.

SCALE = 1" = 200' DATE = 1-20-49
DRAWN BY: C.M. & B.P.M. APPROVED: NO. 1007