


SIMS

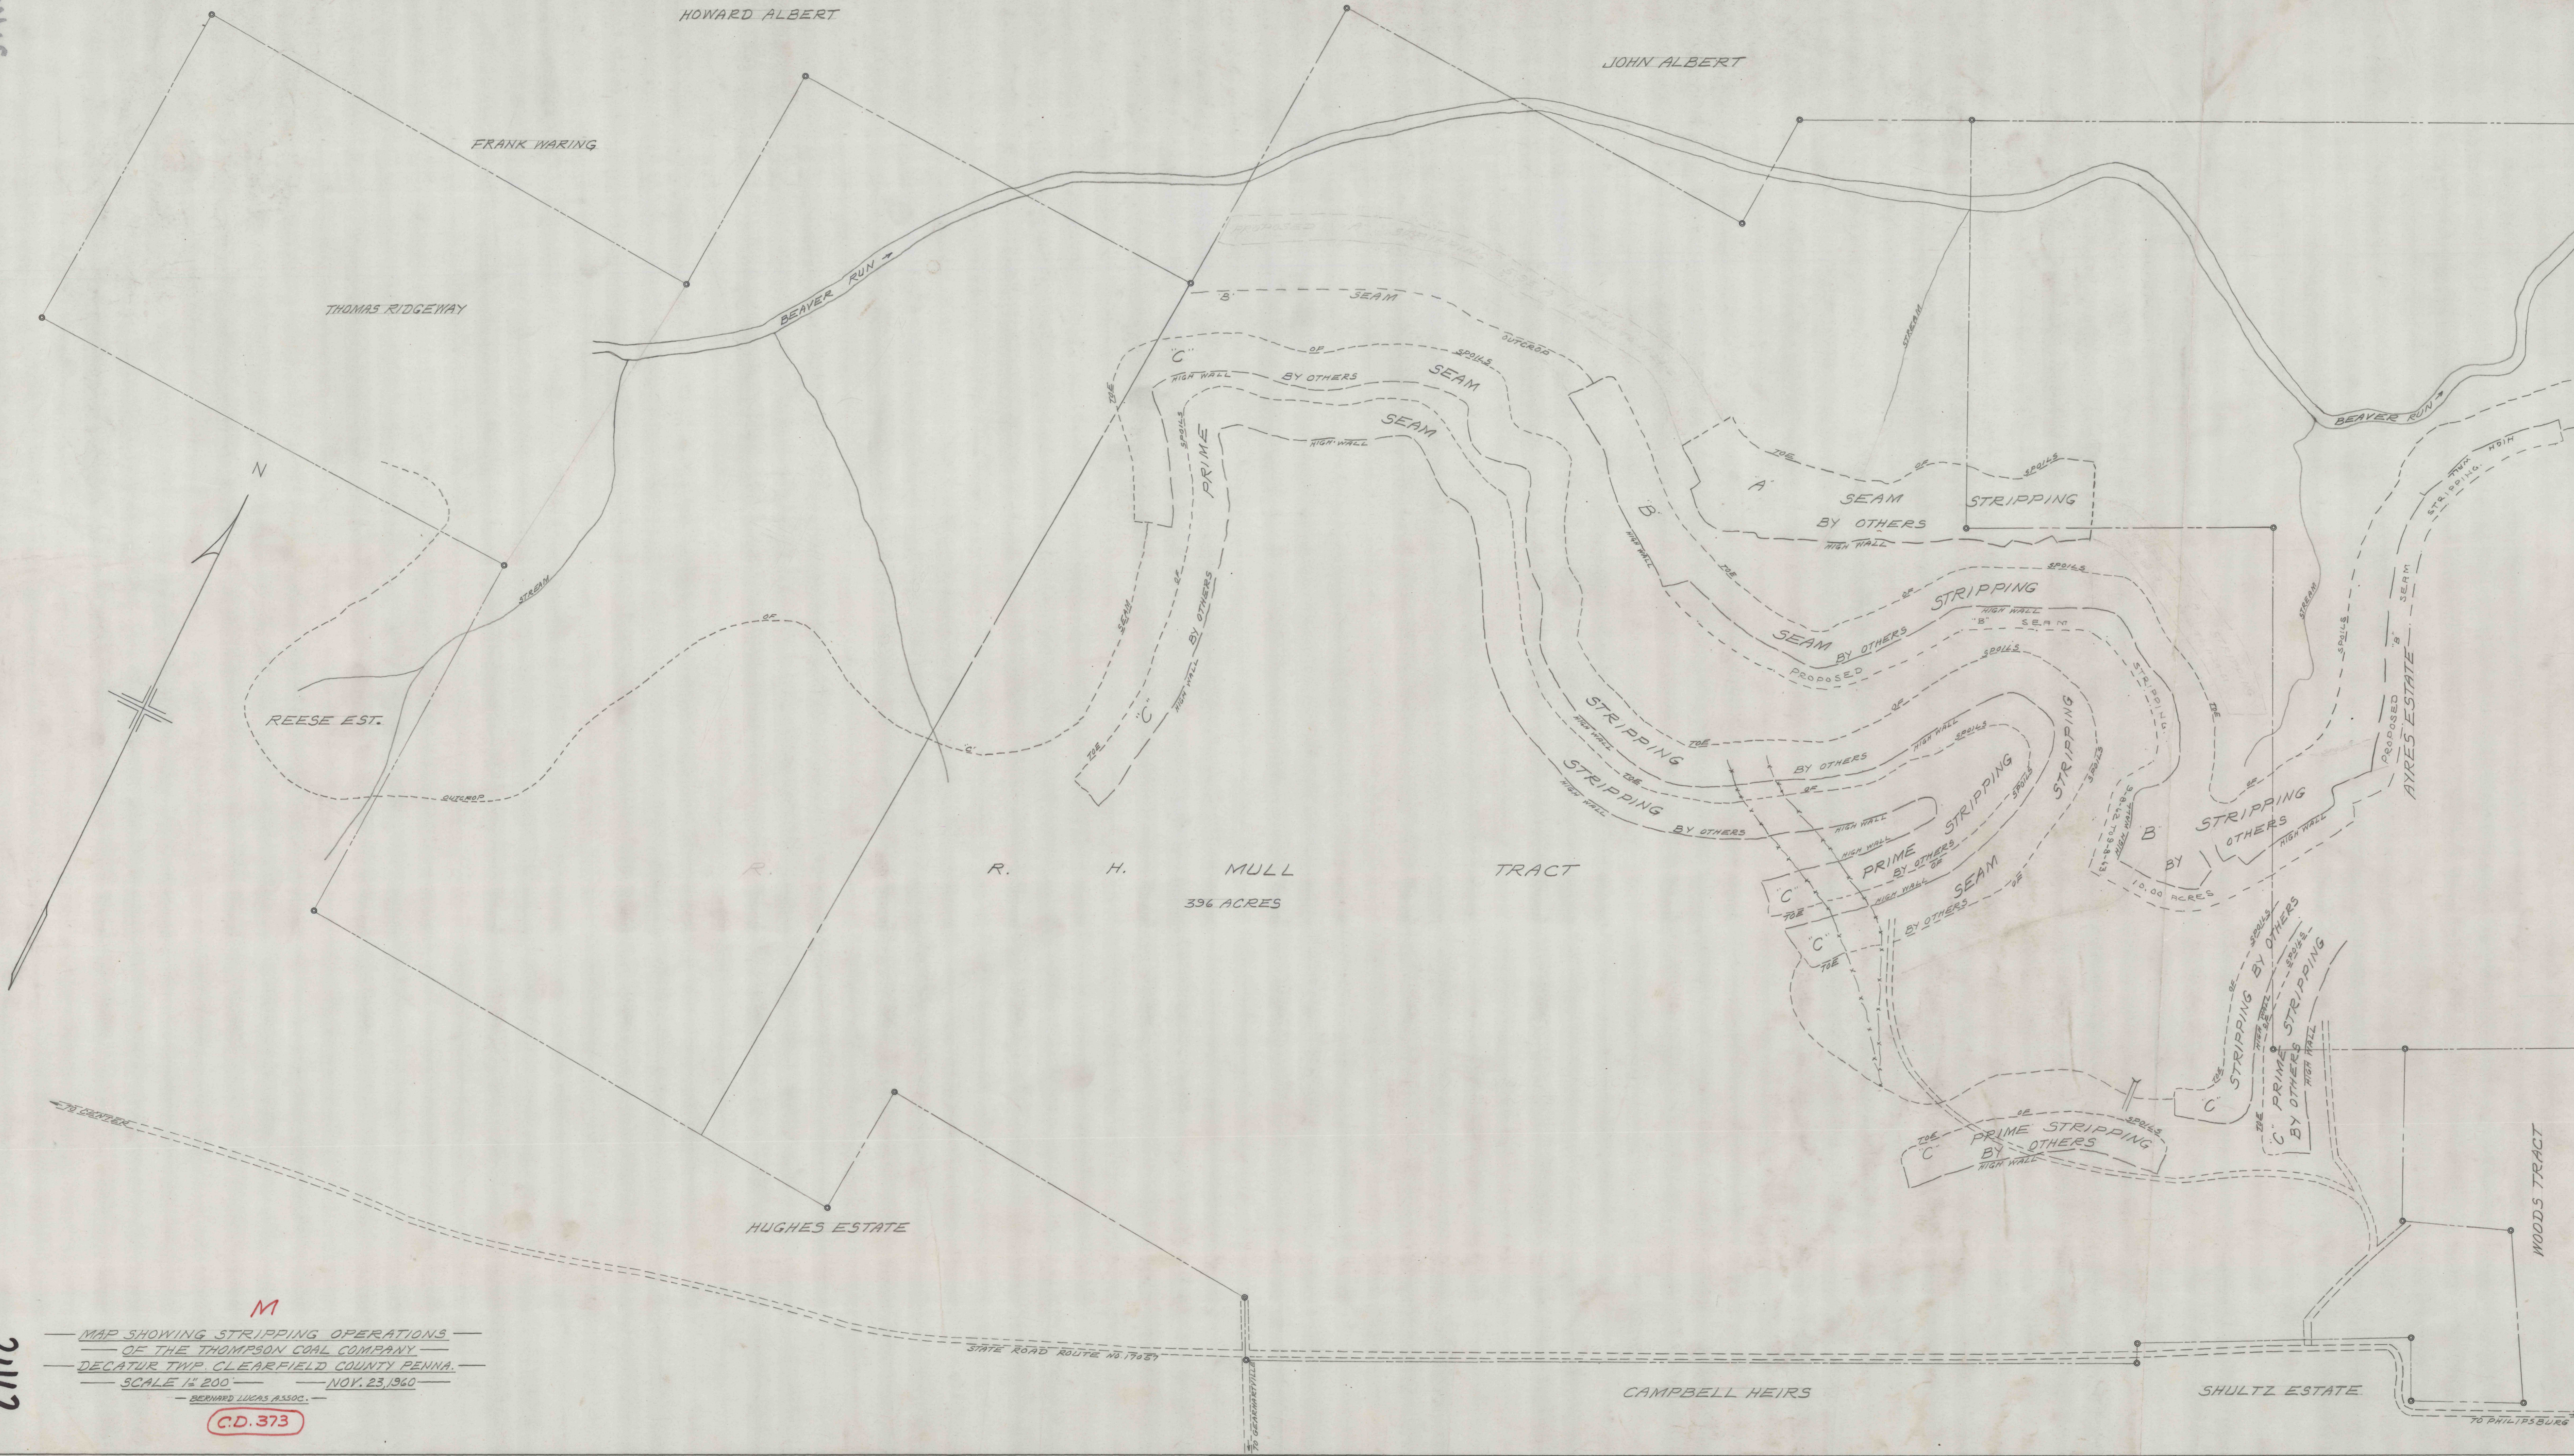

M

MAP SHOWING STRIPPING OPERATIONS
 OF THE THOMPSON COAL COMPANY
 DECATUR TWP. CLEARFIELD COUNTY PENNA.
 SCALE 1" = 200' NOV. 23, 1960

BERNARD LUCAS & ASSOC.
 C.D. 373

2412