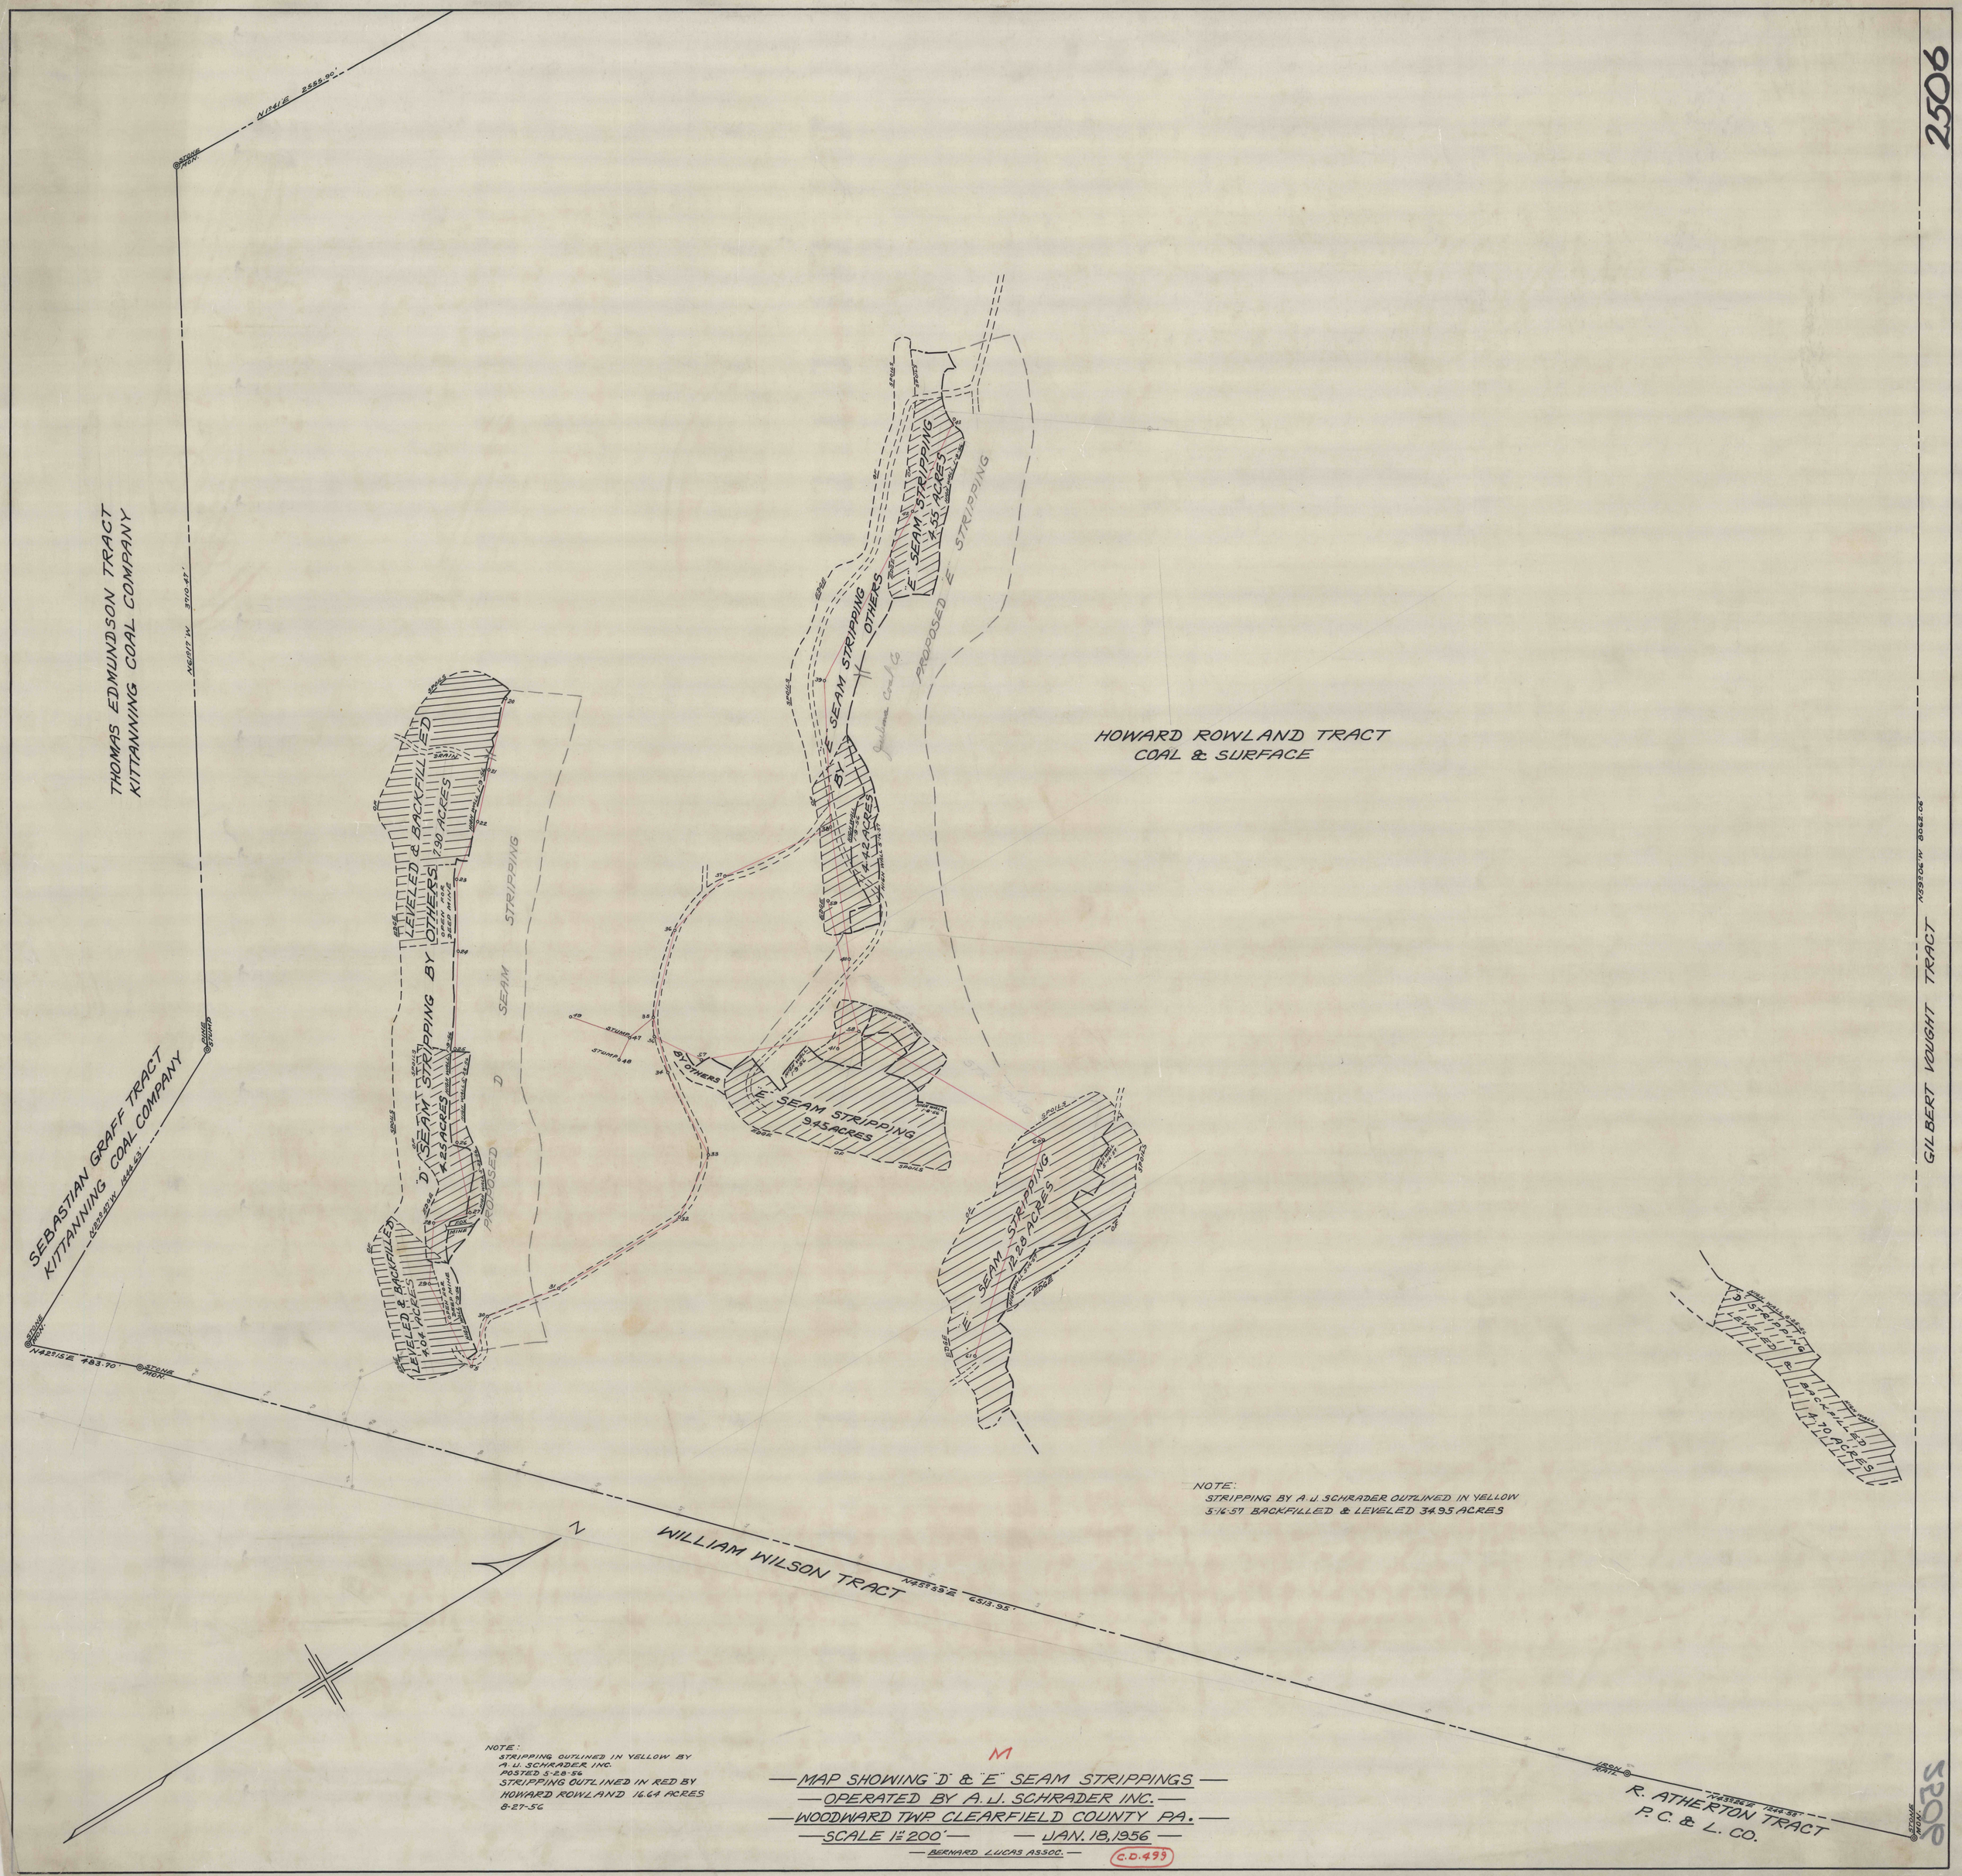
THOMAS EDMUNDSON TRACT
KITTANNING COAL COMPANY
SEBASTIAN GRAFF TRACT
KITTANNING COAL COMPANY
HOWARD ROWLAND TRACT
COAL & SURFACE
GILBERT VOUGHT TRACT
WILLIAM WILSON TRACT
R. ATHERTON TRACT
P. C. & L. CO.
LEVELED & BACKFILLED
7.90 ACRES
BY OTHERS
"D" SEAM STRIPPING
4.25 ACRES
PROPOSED "D" SEAM STRIPPING
"E" SEAM STRIPPING
4.55 ACRES
PROPOSED "E" STRIPPING
"E" SEAM STRIPPING
4.42 ACRES
"E" SEAM STRIPPING
9.45 ACRES
"E" SEAM STRIPPING
12.28 ACRES
LEVELED & BACKFILLED
4.04 ACRES
"D" STRIPPING
LEVELED & BACKFILLED
4.70 ACRES
N
NOTE:
STRIPPING BY A. J. SCHRADER OUTLINED IN YELLOW
5-16-57 BACKFILLED & LEVELED 34.95 ACRES
NOTE:
STRIPPING OUTLINED IN YELLOW BY
A. J. SCHRADER INC.
POSTED 5-28-56
STRIPPING OUTLINED IN RED BY
HOWARD ROWLAND 16.64 ACRES
8-27-56
M
MAP SHOWING "D" & "E" SEAM STRIPPINGS
OPERATED BY A. J. SCHRADER INC.
WOODWARD TWP. CLEARFIELD COUNTY PA.
SCALE 1" = 200'
JAN. 18, 1956
BERNARD LUCAS ASSOC.
C.D. 499
2506