


MS
AULDEY ESTATE

FREDERICK BERG TRACT

SAMUEL MERYDETH TRACT

C. B. C. CO.

GEORGE CLYMER TRACT

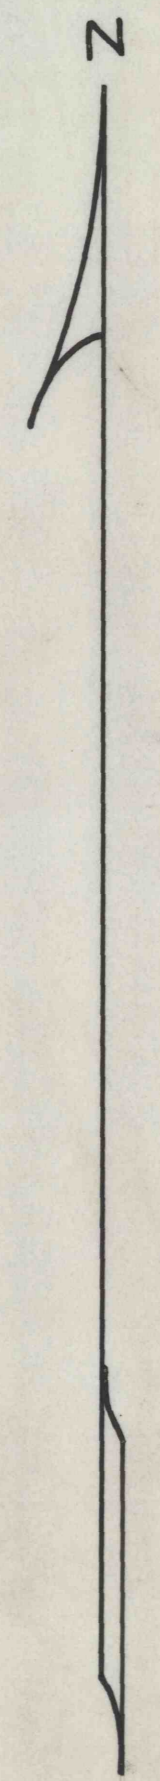

OLD DRIFT
CLEANING PLANT

SEAM

HIGH WALL
10-12-57

STRIPPING
12.31 ACRES

MINE HIGH WALL
10-14-57
WORKINGS

3.31 ACRES

NOTE:
[Hatched pattern] LEVELED & BACKFILLED 15.62 ACRES 10-14-57

M

— MAP SHOWING "B" SEAM STRIPPING —
— OPERATED BY COMFORT RUN COAL COMPANY —
— COOPER TWP. CLEARFIELD COUNTY PENNA. —
— SCALE 1" = 200' — — OCT. 21, 1957 —
— BERNARD LUCAS ASSOC. —

C.D. 313

2514