


SAMUEL MERYDETH

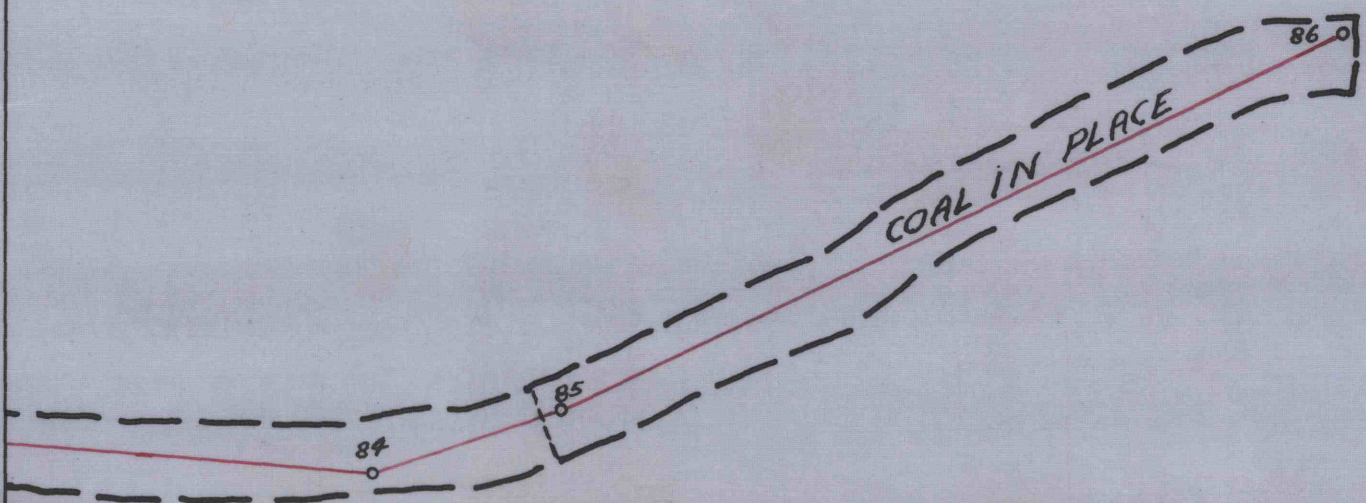

d/23

M
C.D. 313

2516