




WILLIAM DOTTTS JR.

Township Road

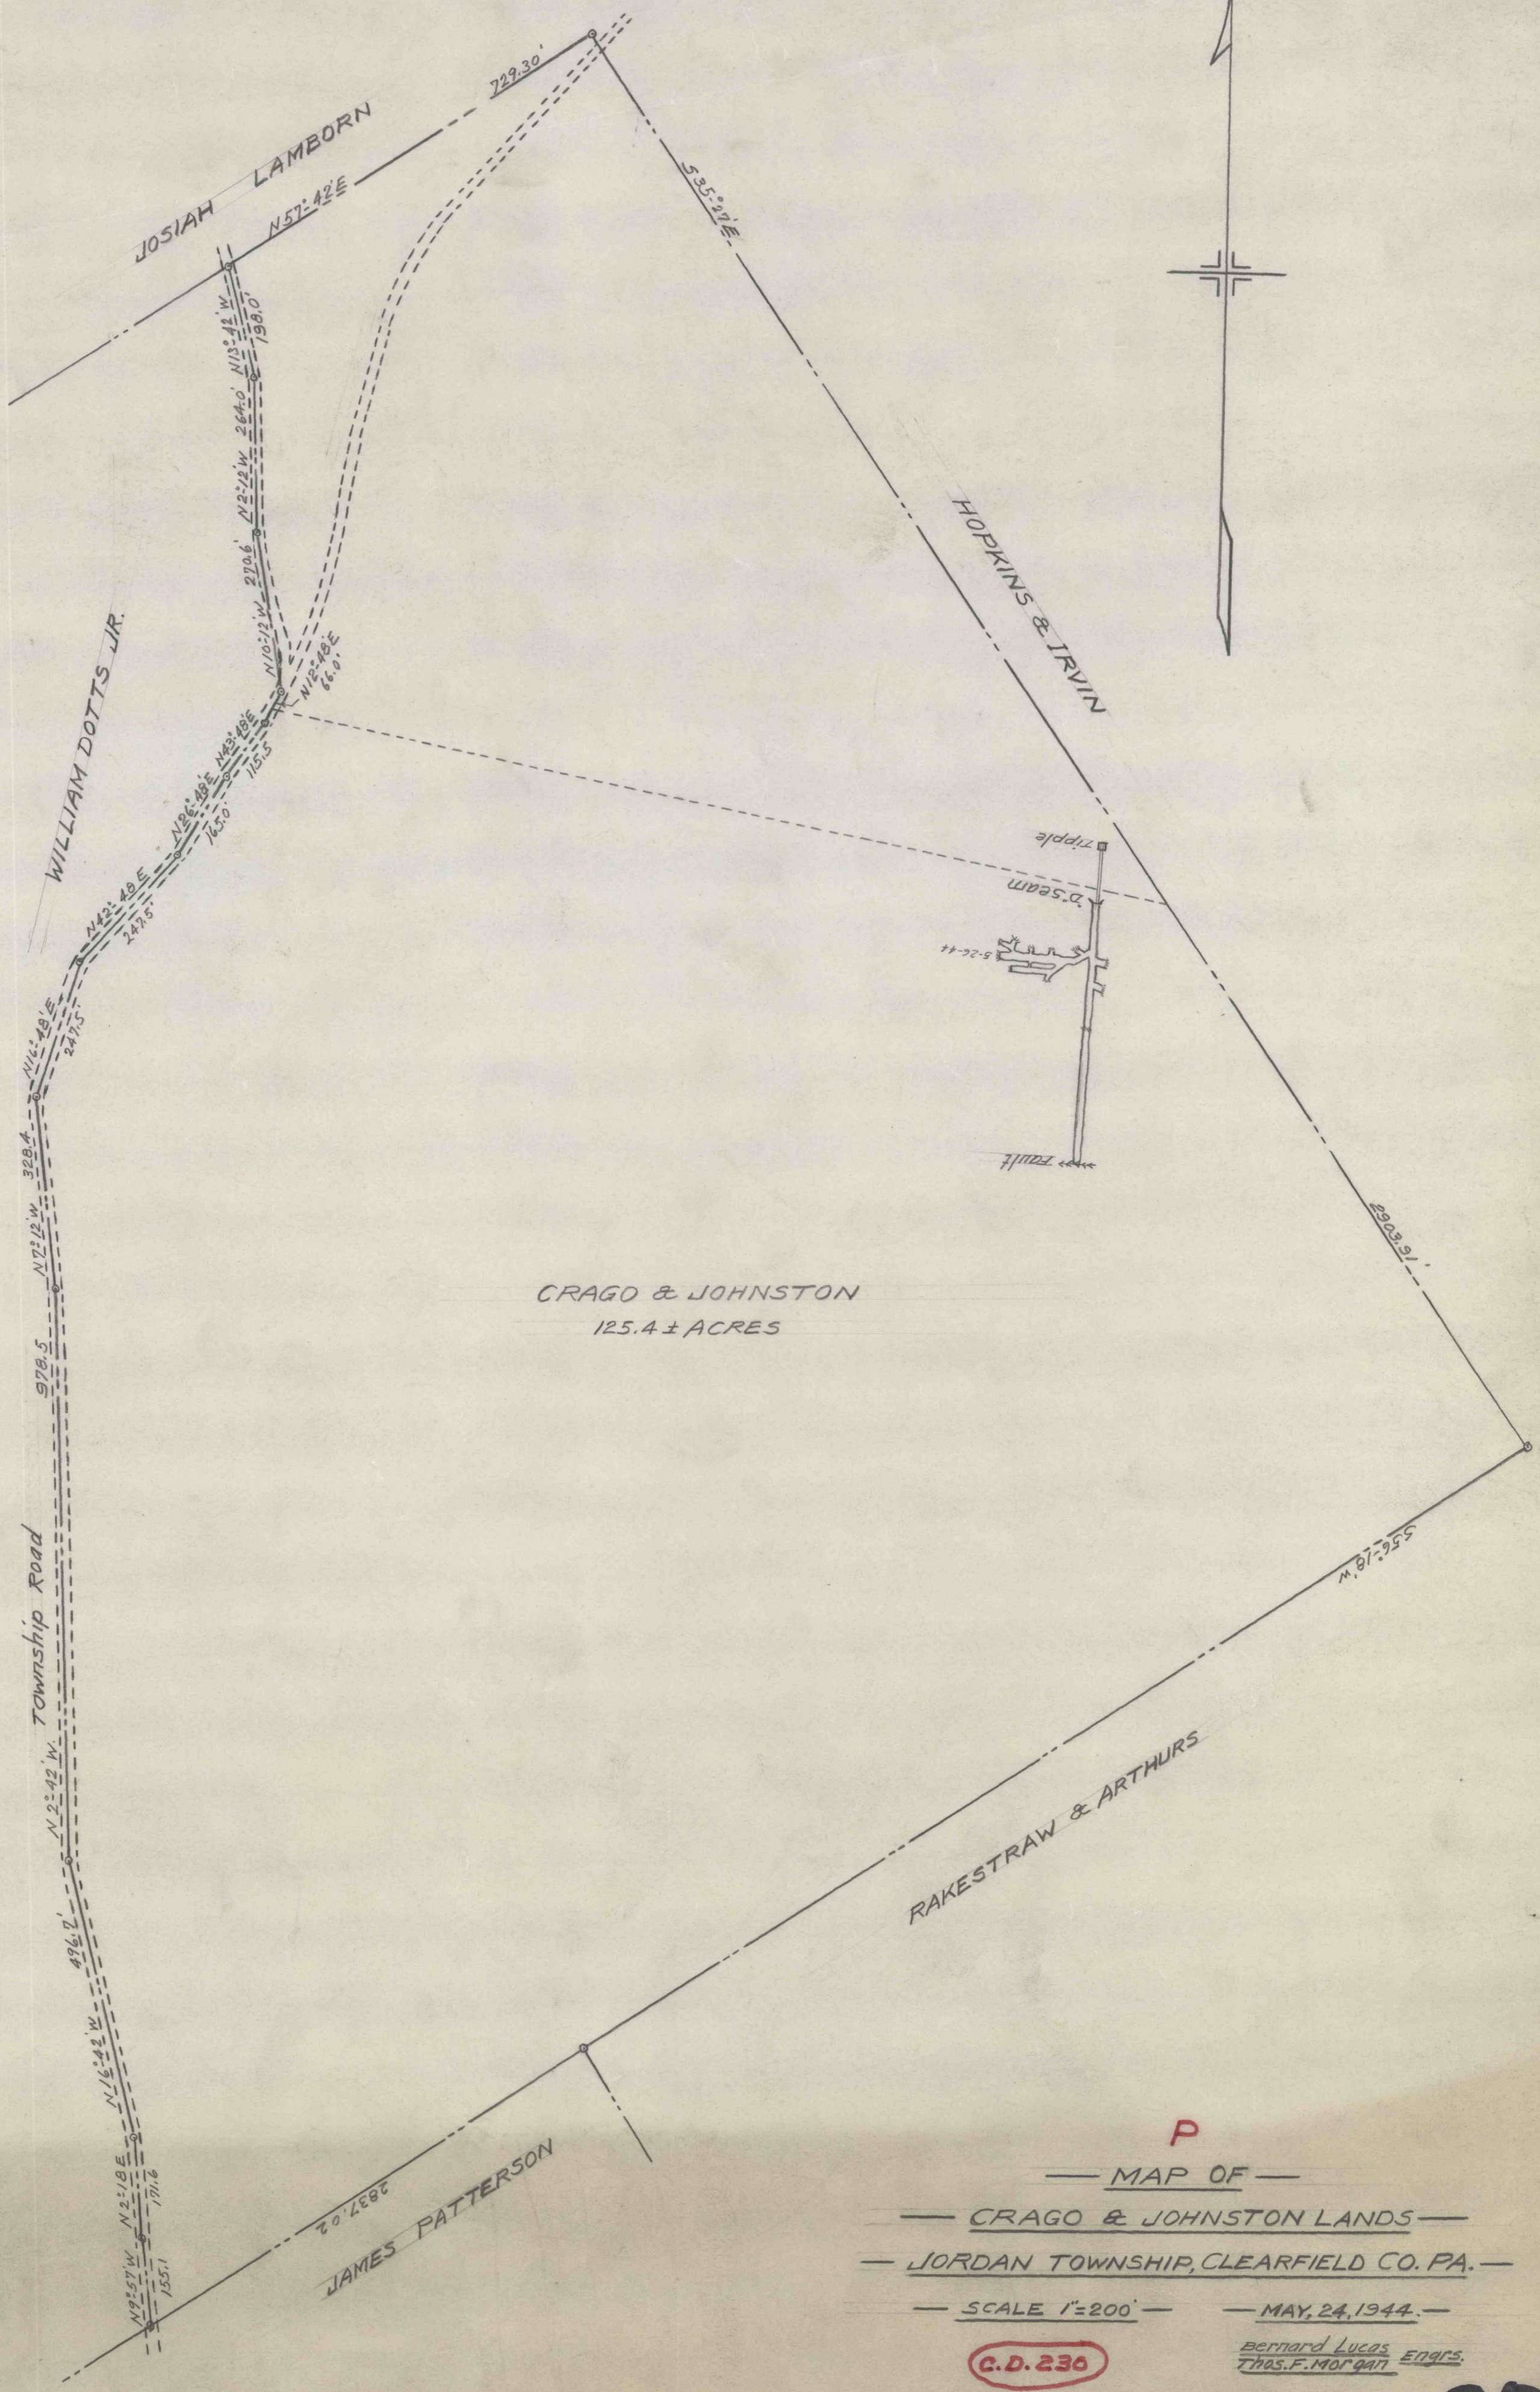

CRAGO & JOHNSTON  
125.4 ± ACRES

RAKESTRAW & ARTHURS

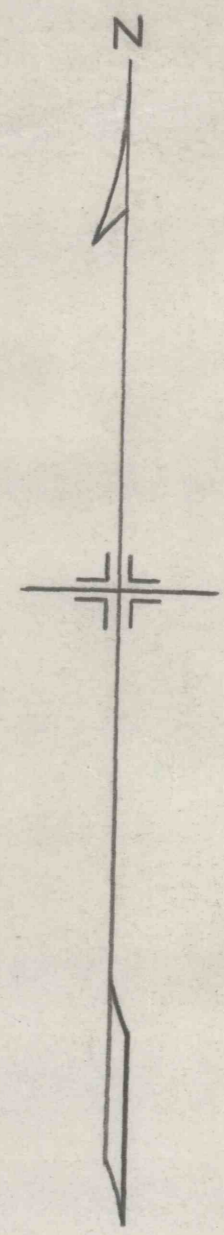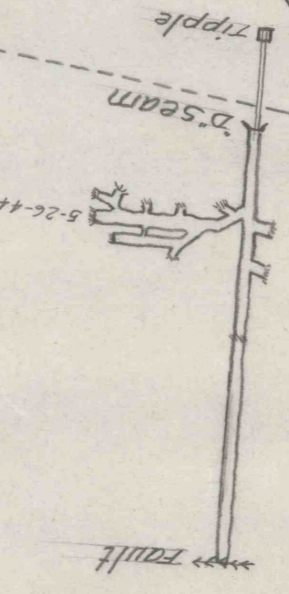

P  
— MAP OF —

— CRAGO & JOHNSTON LANDS —

— JORDAN TOWNSHIP, CLEARFIELD CO. PA. —

— SCALE 1"=200' —

— MAY, 24, 1944. —

G.D. 230

Bernard Lucas  
THAS. F. MORGAN ENGINEERS

2630

523