


SAMUEL HAMBLETON TRACT
K.C.CO.

JOHN B. McENELLY EST.

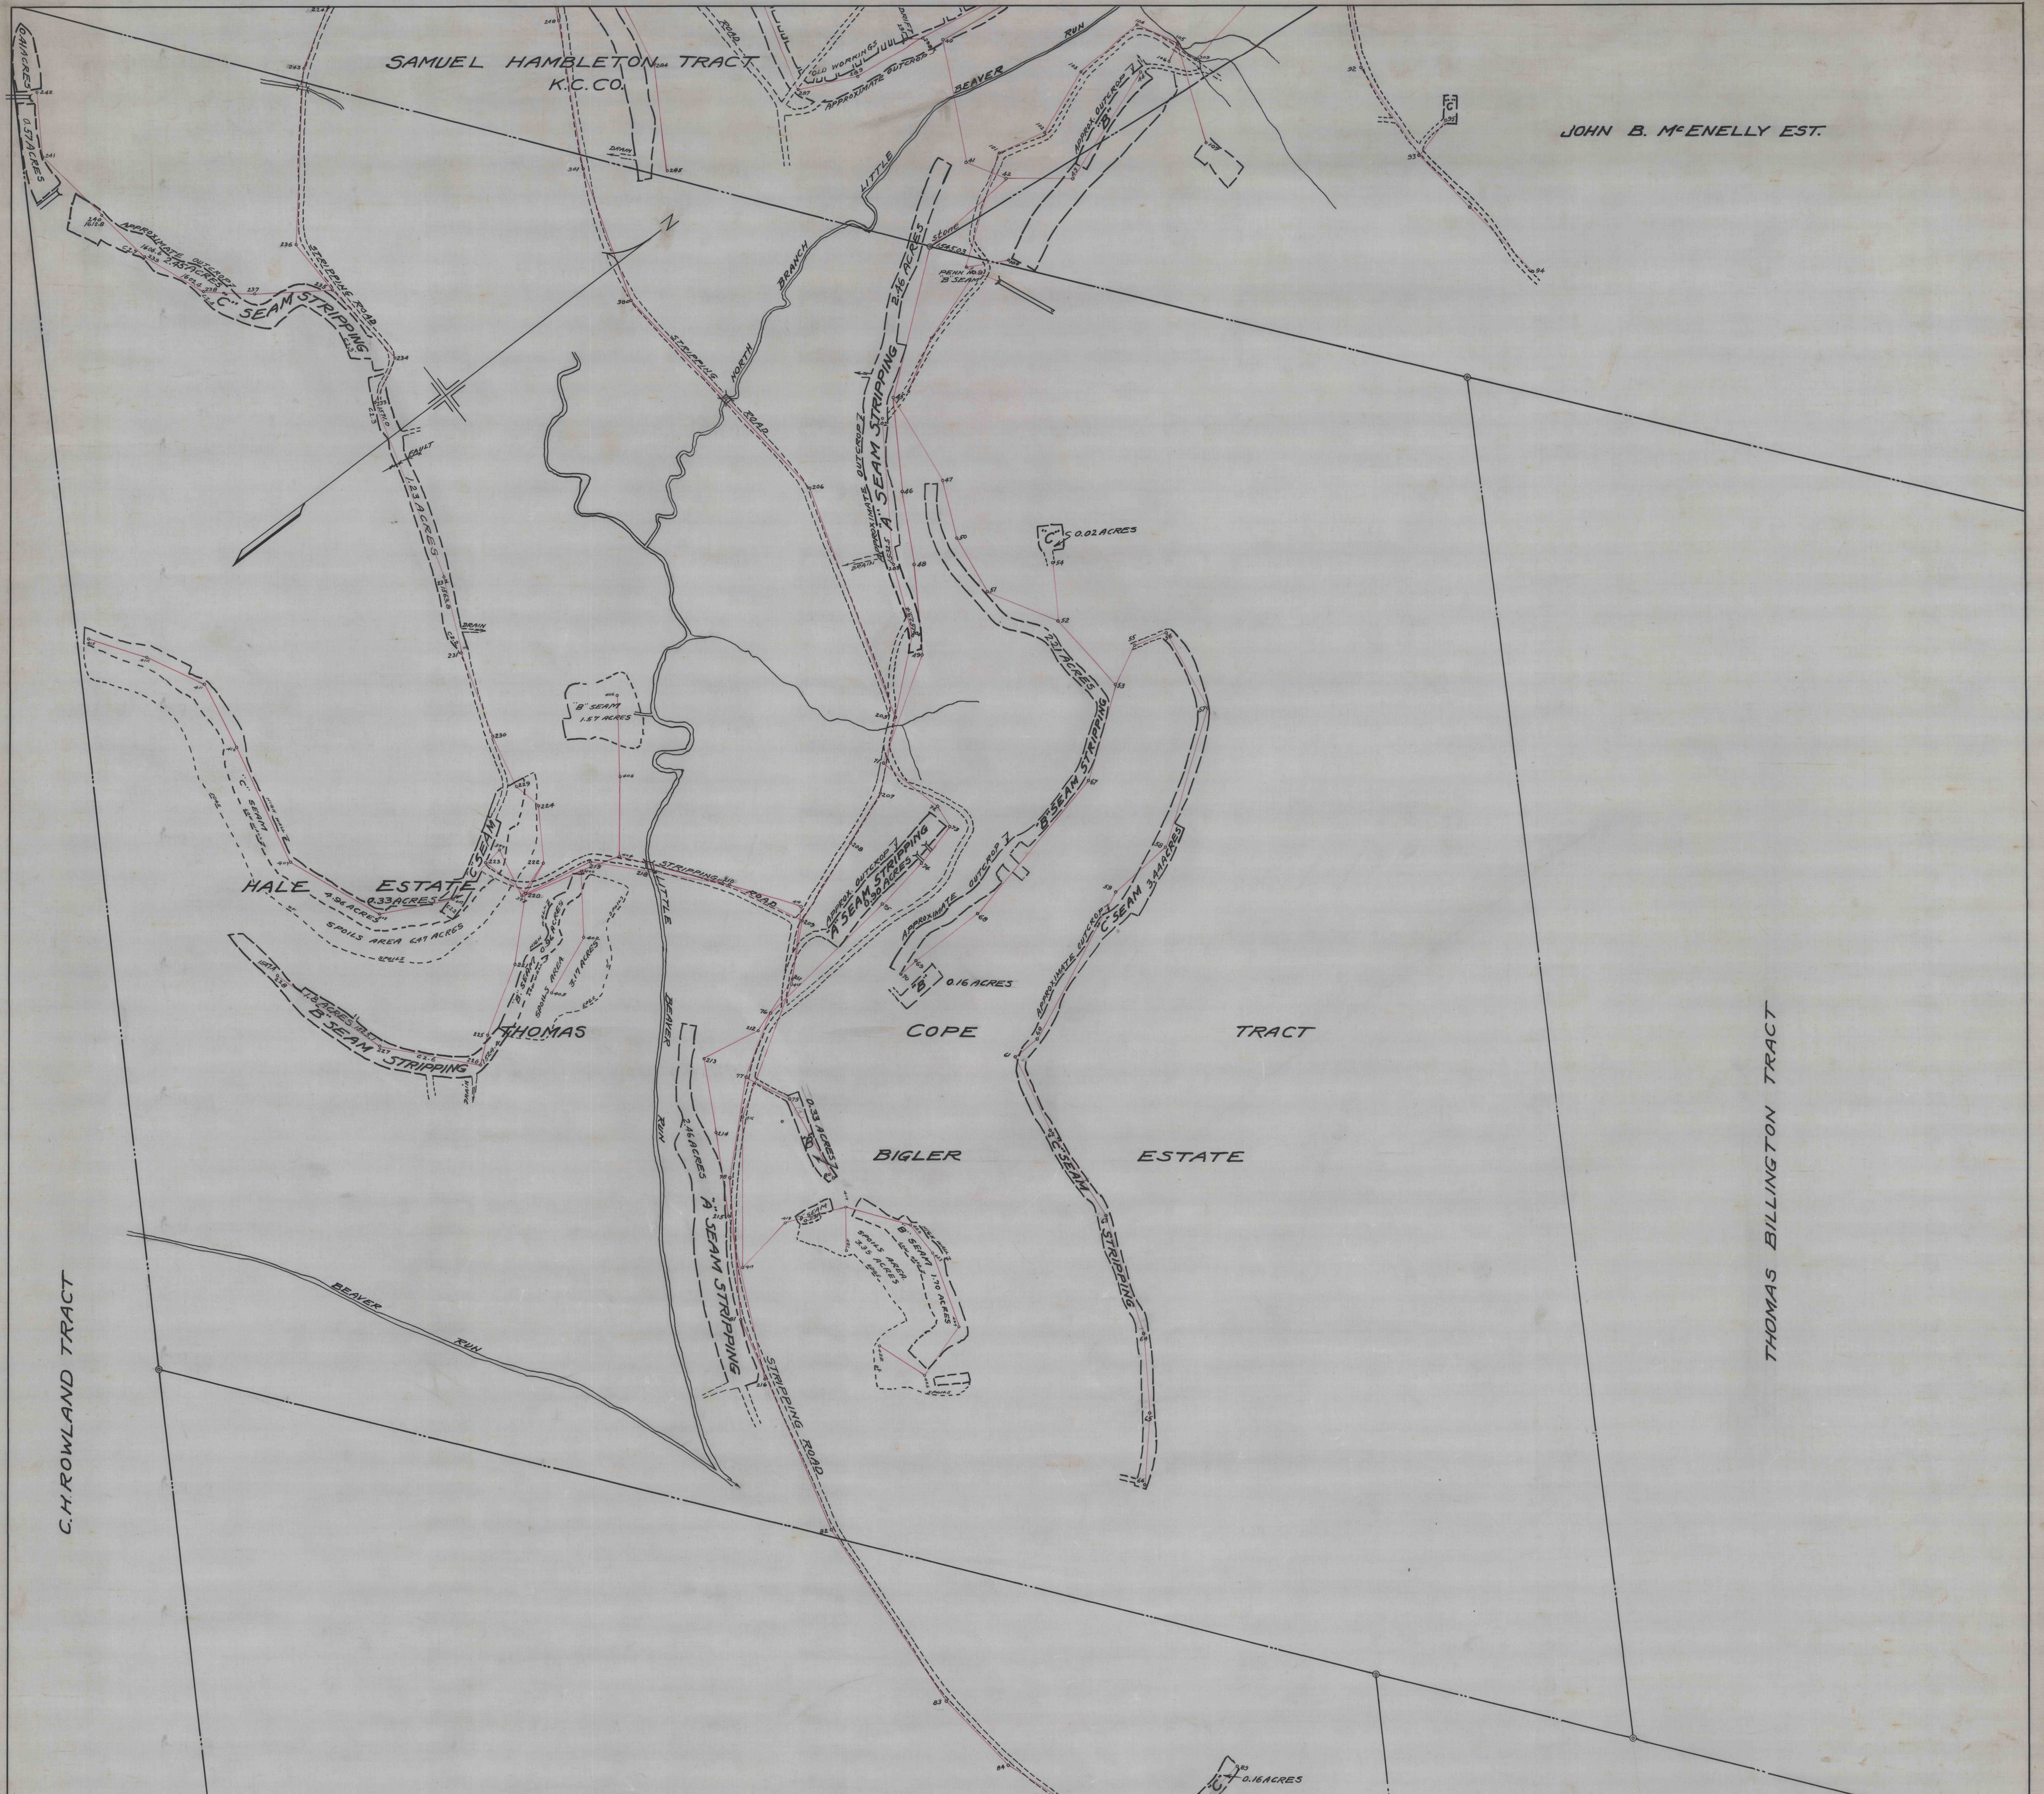

C.H. ROWLAND TRACT

THOMAS BILLINGTON TRACT

JOSEPH HARRISON TRACT
K.C.CO.

JOHN HARRISON TRACT

Slide
Slide

POSTED TO MAY 18, 1948
 TOTAL AREA AFFECTED SHEETS 1 & 2 - 60.78 ACRES

M

— MAP OF A-B & C SEAMS STRIPPINGS —
 — DECATUR TWP. CLEARFIELD COUNTY PA. —
 — OPERATED BY ELLIOT COAL MINING CO. —
 — SCALE 1" = 200' —

— JAN. 11, 1946 —

shect. no. 1

bernard lucas
thomas george
engr's

2795 2796