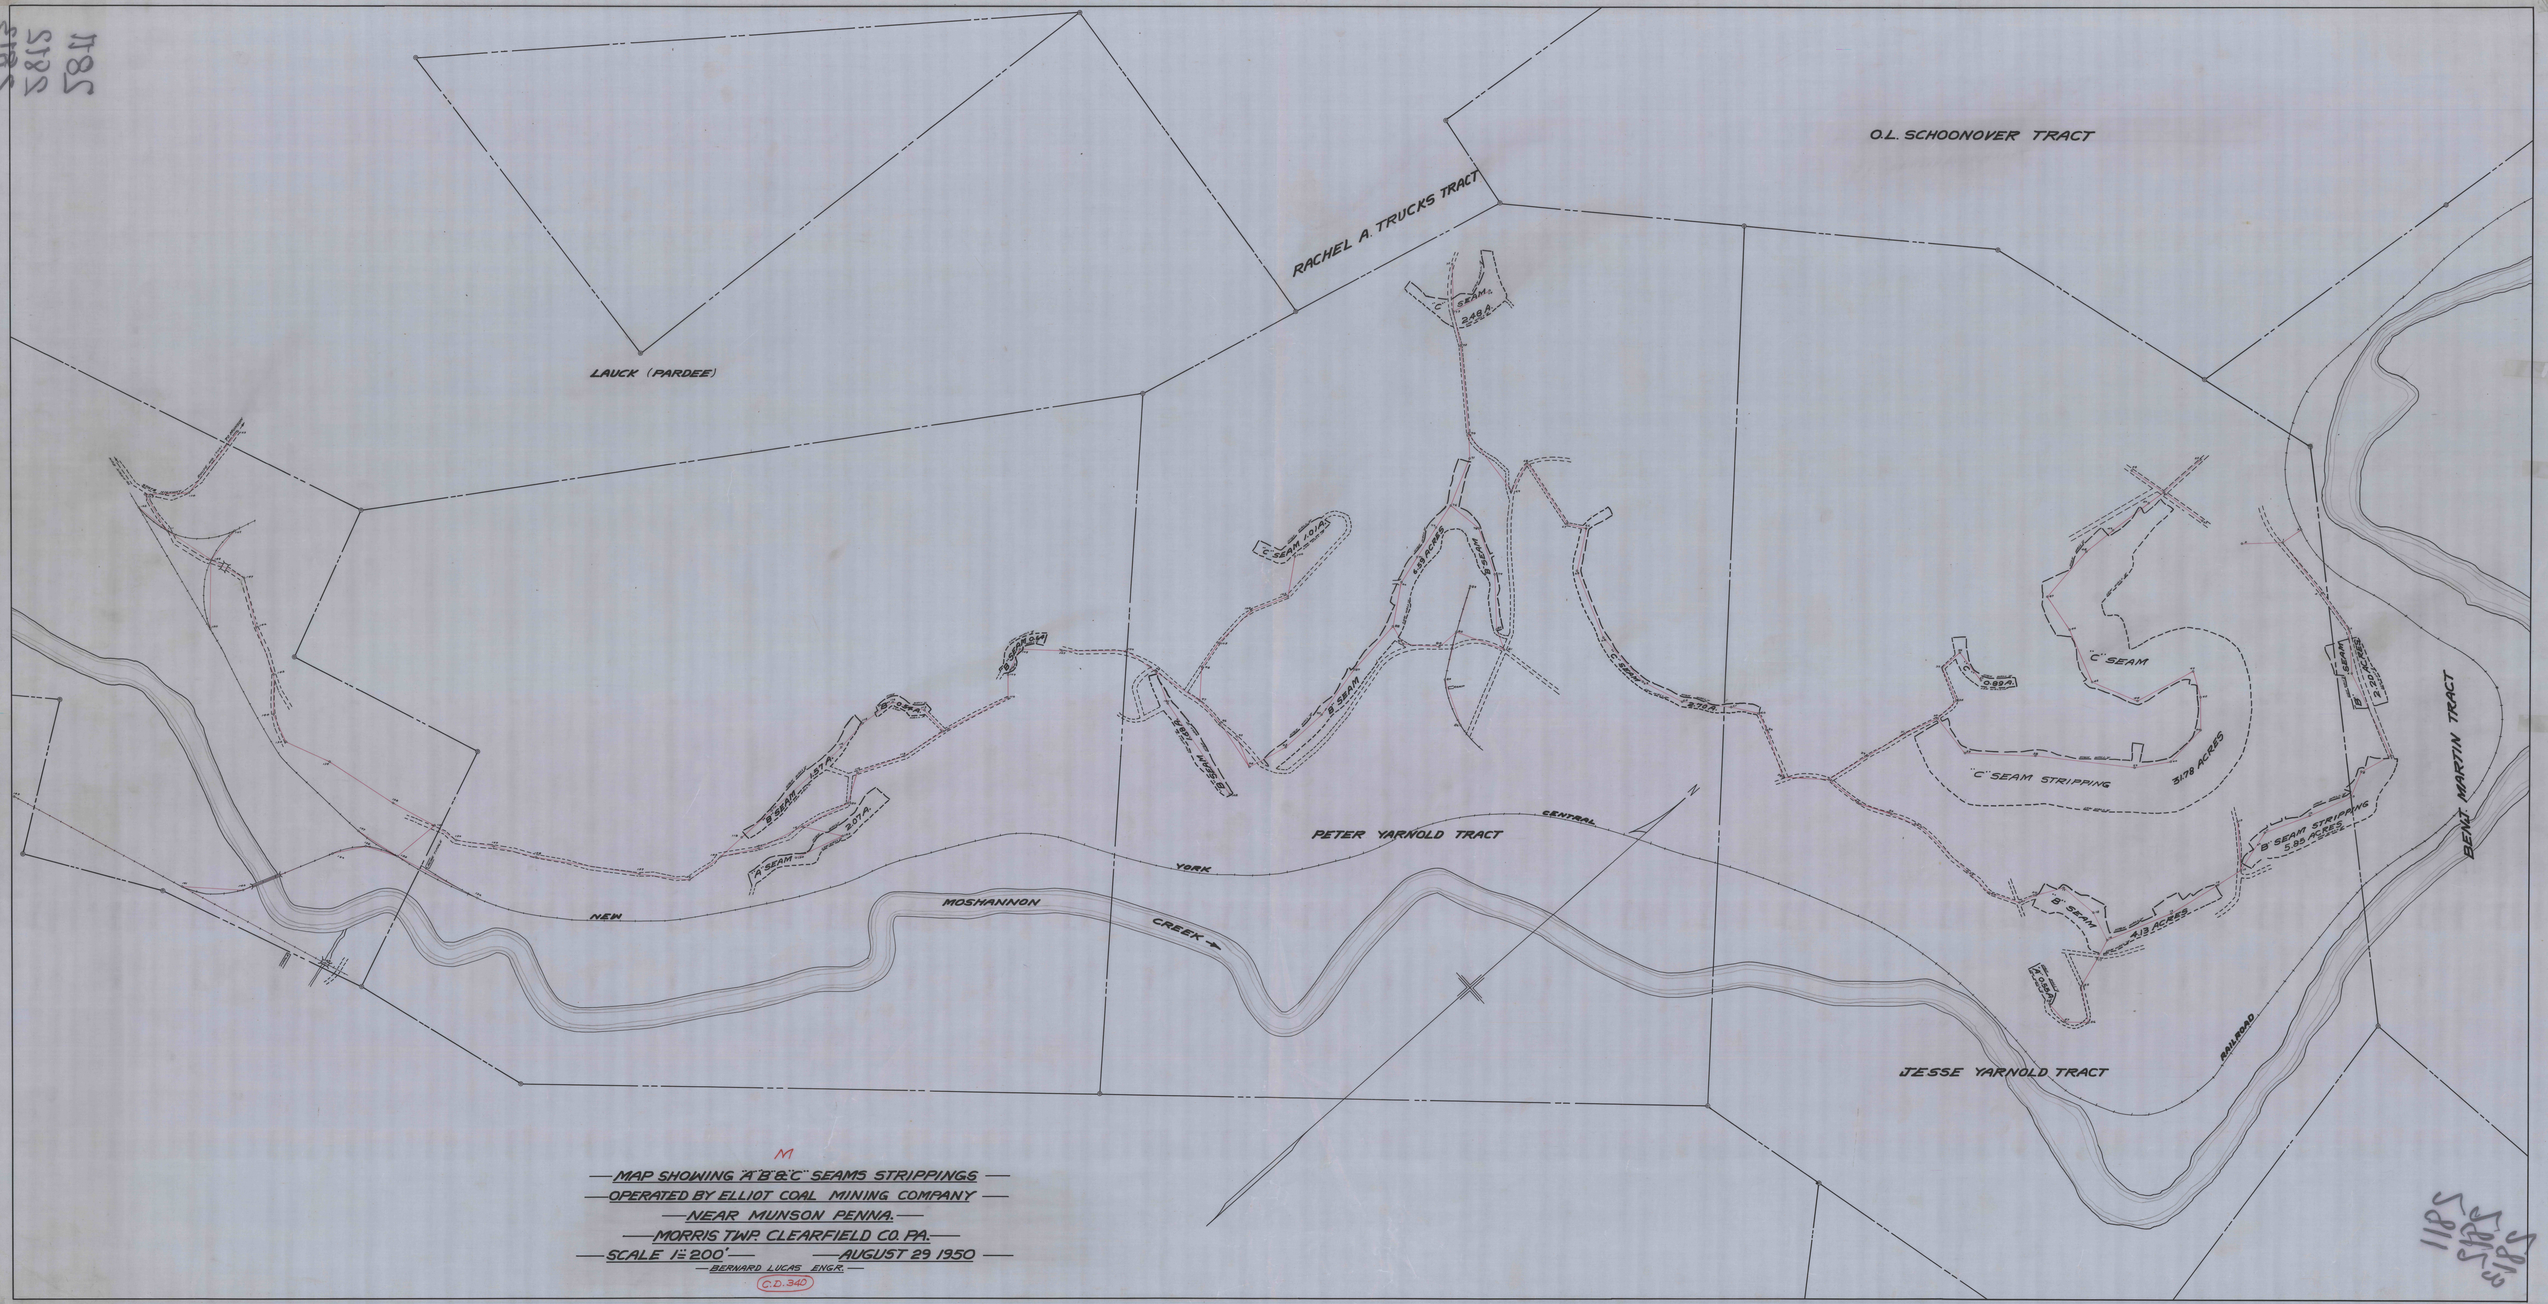

MAP SHOWING "A" "B" & "C" SEAMS STRIPPINGS
OPERATED BY ELLIOT COAL MINING COMPANY
NEAR MUNSON PENNA.
MORRIS TWP. CLEARFIELD CO. PA.
SCALE 1" = 200' — AUGUST 29 1950
BERNARD LUCAS ENGR.

C.D. 340