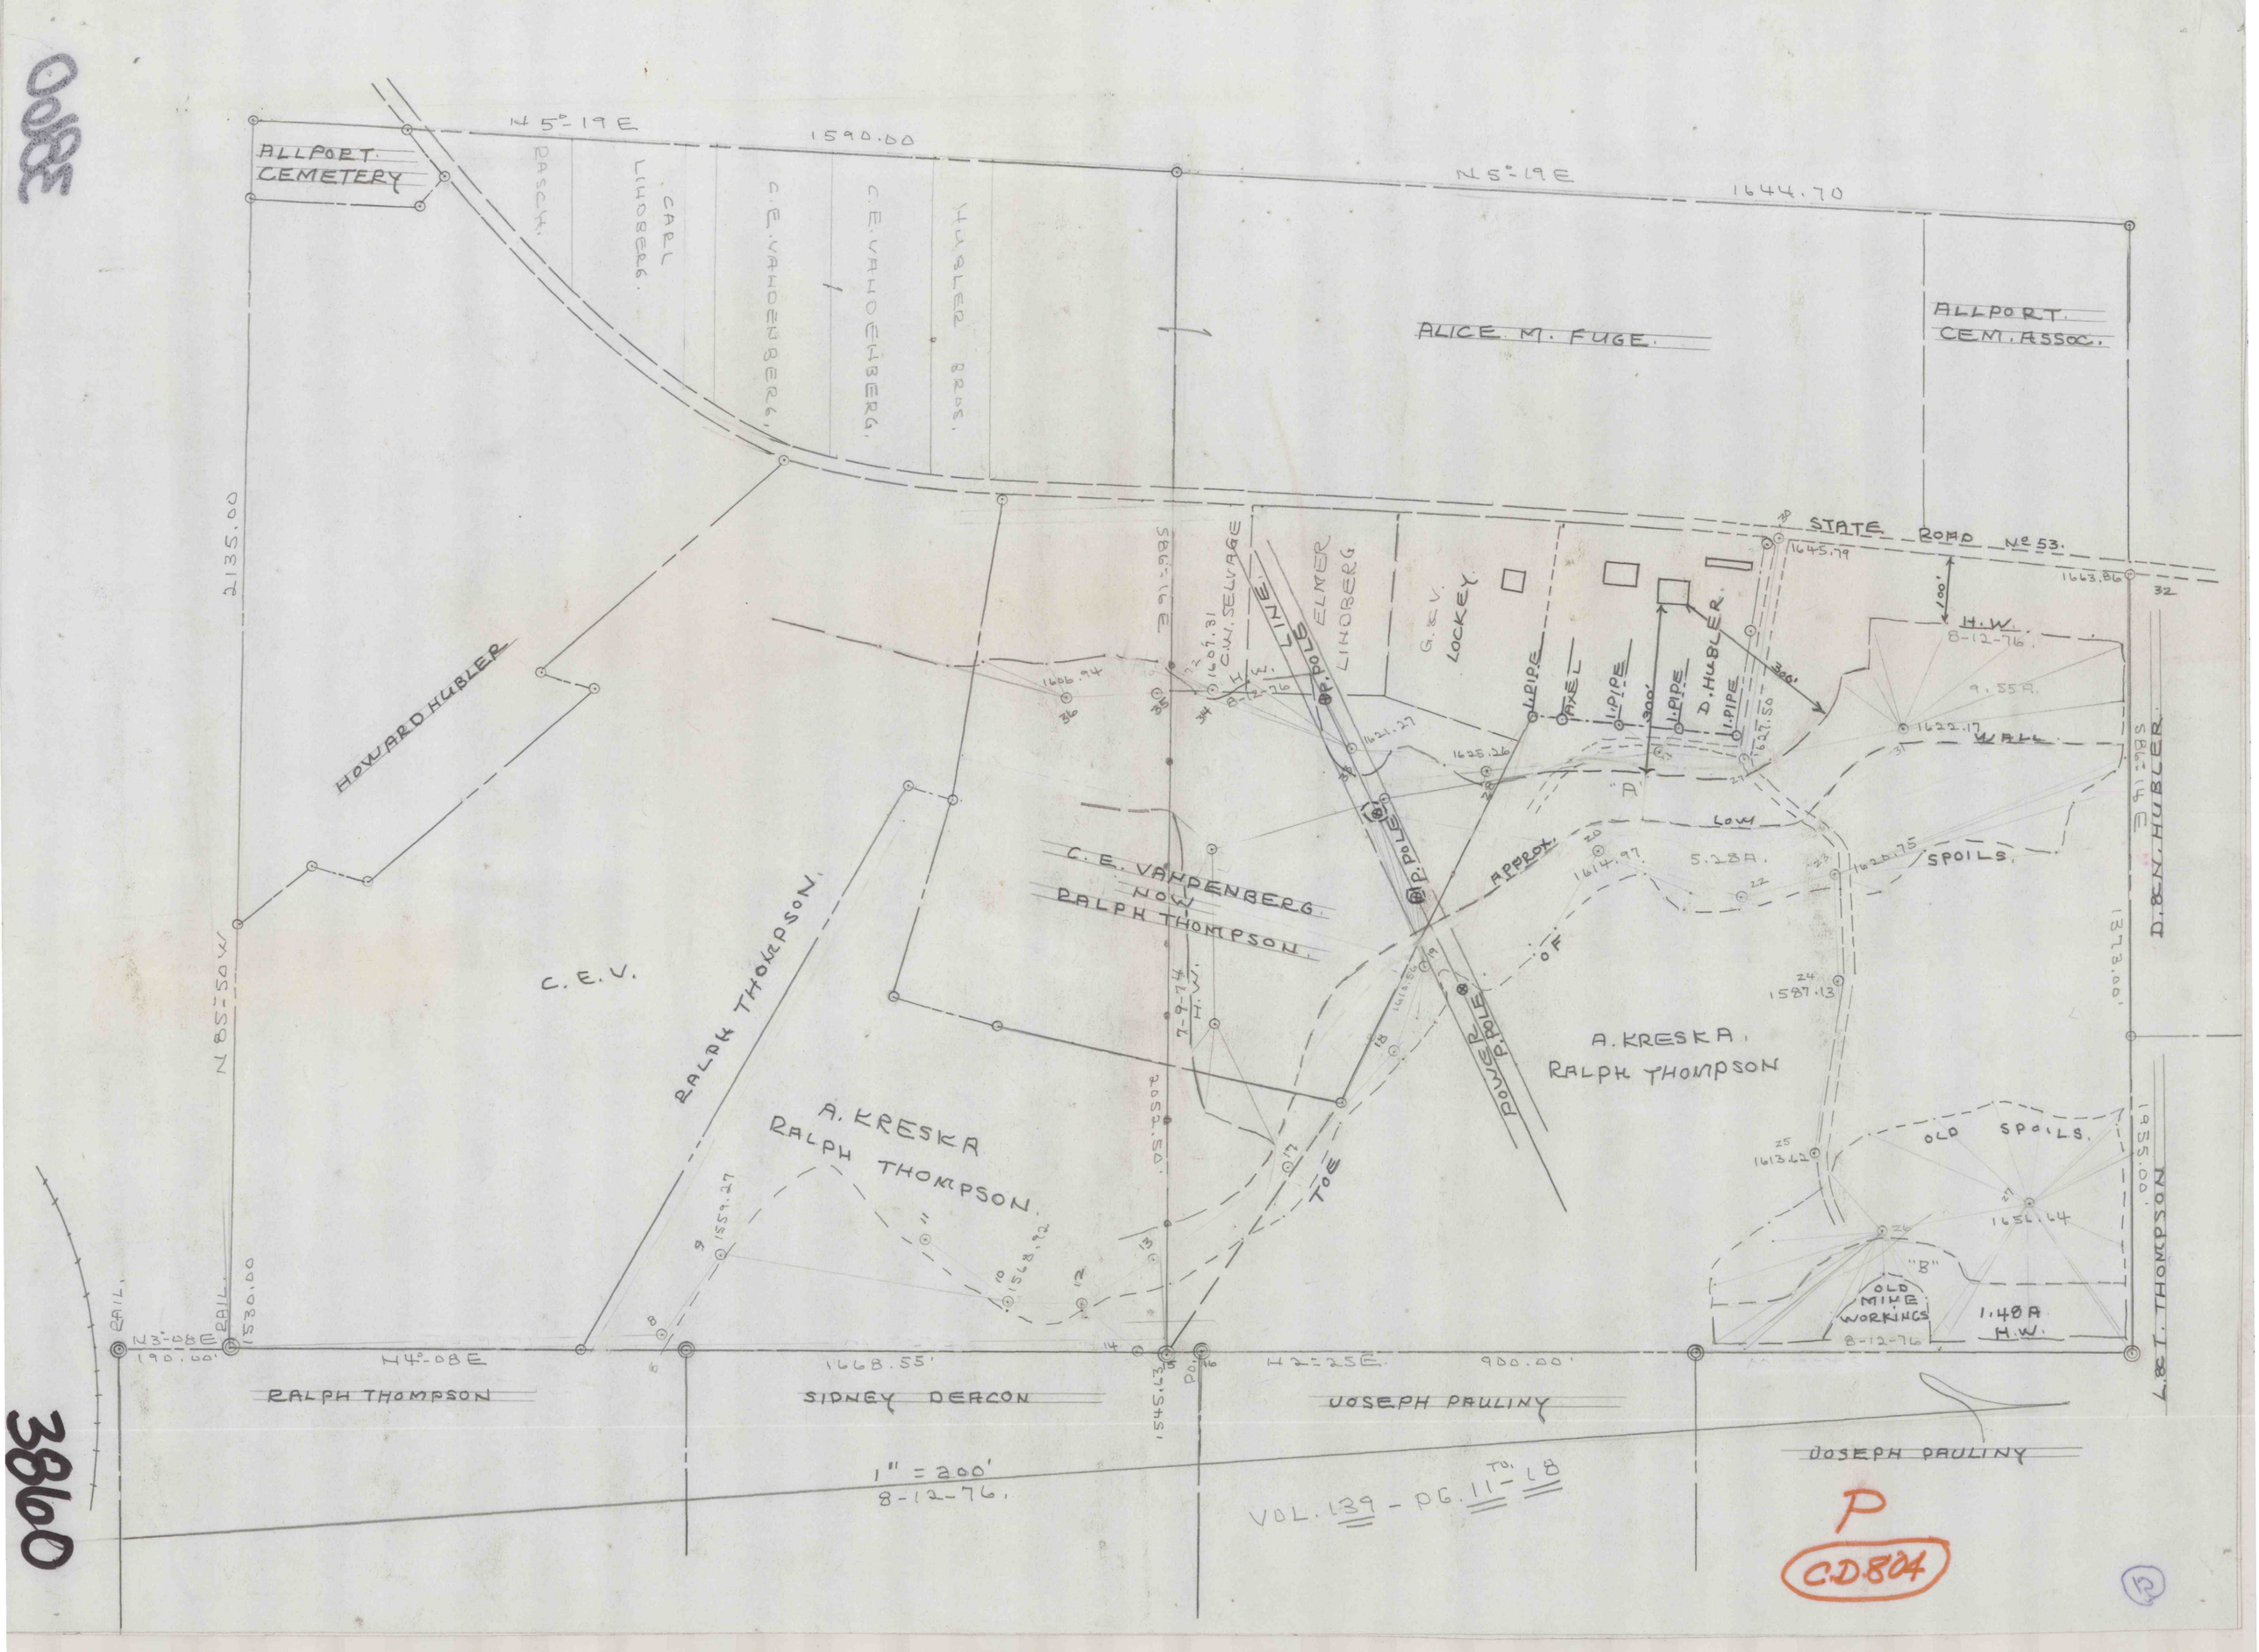

ALLPORT CEMETERY
N 5°-19 E
1590.00
N 5°-19 E
1644.70
RASCH.
CARL LINDBERG.
C.E. VANDENBERG.
C.E. VANDENBERG.
HUBLER BROS.
ALICE M. FUGE.
ALLPORT CEM. ASSOC.
STATE ROAD No 53.
2135.00
HOWARD HUBLER
C.E.V.
RALPH THOMPSON.
A. KRESKA
RALPH THOMPSON.
C.E. VANDENBERG
NOW
RALPH THOMPSON.
ELMER LINDBERG
G.&V. LOCKEY
D. HUBLER
H.W.
8-12-76
9.55A.
WALL
LOW
SPOILS.
5.28A.
APPROX.
A. KRESKA.
RALPH THOMPSON
OLD SPOILS.
OLD MINE WORKINGS
1.48A
H.W.
8-12-76
TOE
OF
POWER P. POLE
N 85°-50 W
N 3°-08 E
190.00'
N 4°-08 E
1668.55'
N 2°-25 E
900.00'
RALPH THOMPSON
SIDNEY DEACON
JOSEPH PAULINY
JOSEPH PAULINY
1" = 200'
8-12-76.
VOL. 139 - PG. 11 TO 18
P
C.D. 804

3860