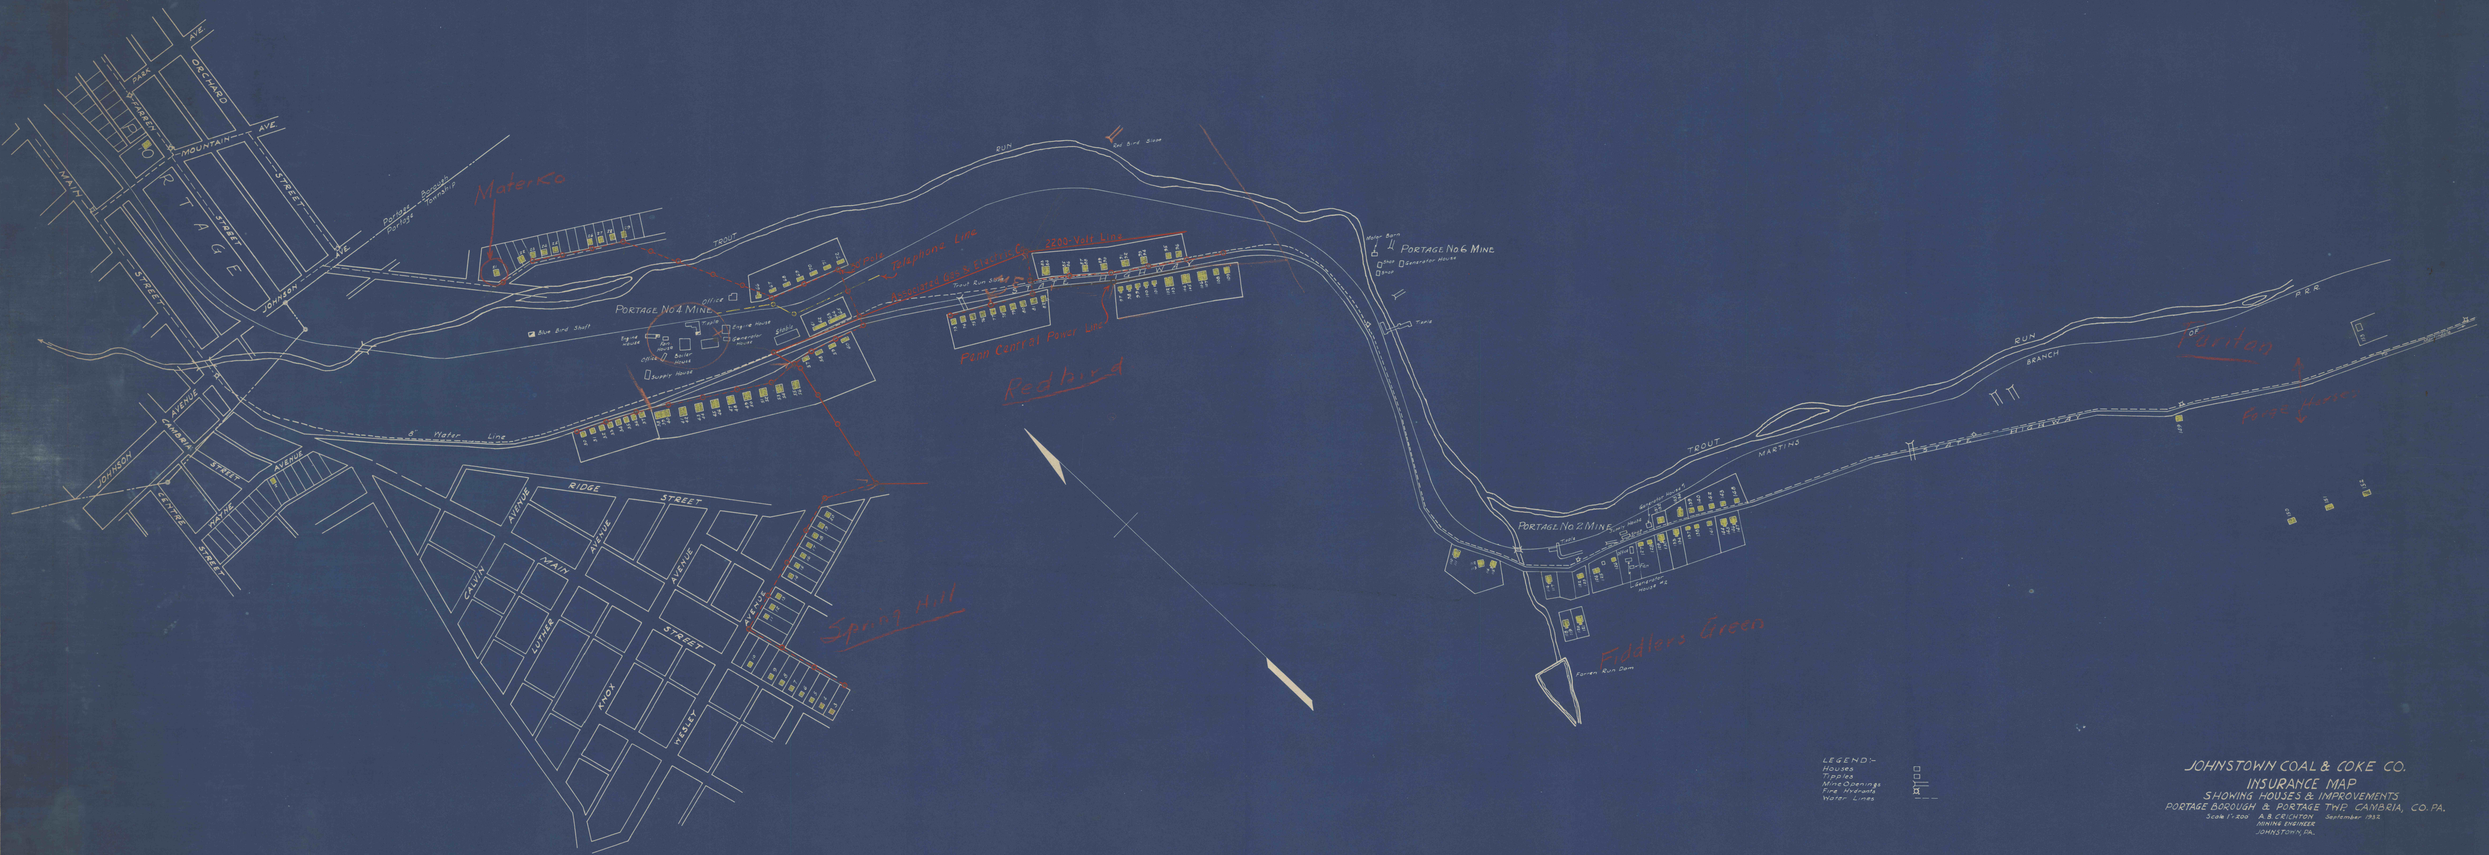

LEGEND:-
Houses
Tipples
Mine Openings
Fire Hydrants
Water Lines

JOHNSTOWN COAL & COKE CO.

INSURANCE MAP

SHOWING HOUSES & IMPROVEMENTS

PORTAGE BOROUGH & PORTAGE TWP. CAMBRIA, CO. PA.

Scale 1"=200' A.B. CRICHTON September 1932
MINING ENGINEER
JOHNSTOWN, PA.