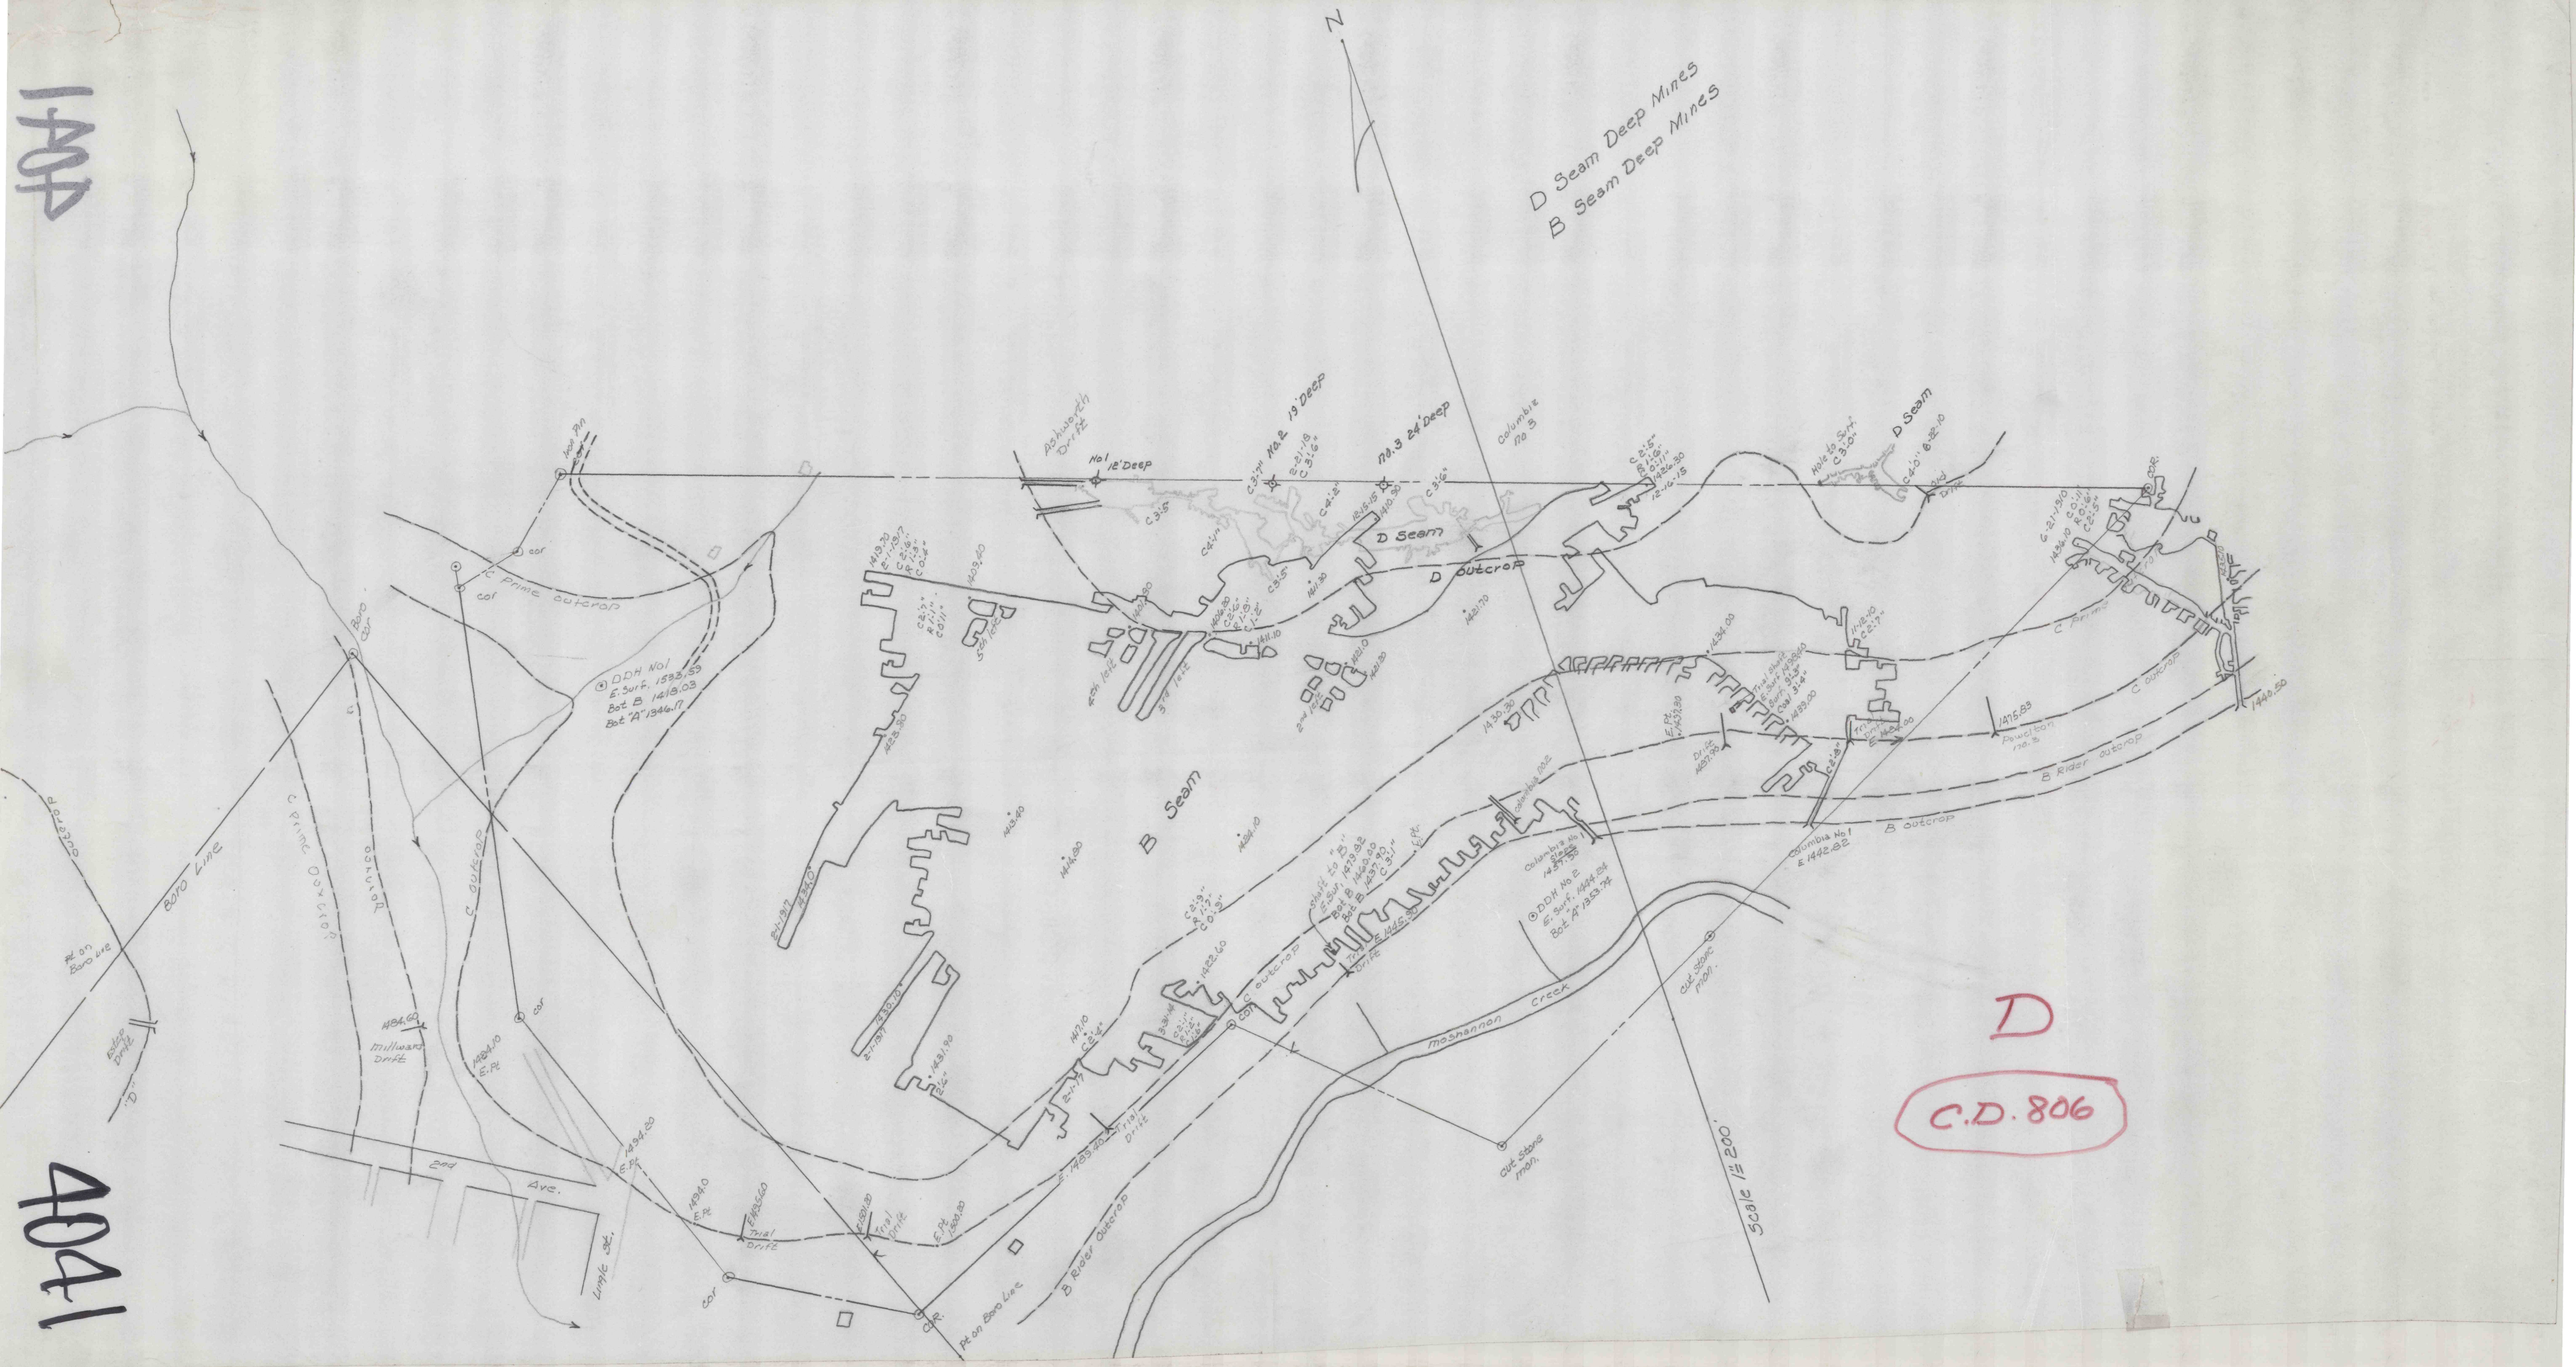

D Seam Deep Mines
B Seam Deep Mines
N
D Seam
D outcrop
B Seam
C Prime outcrop
C outcrop
B outcrop
B Rider outcrop
Boro Line
Millward Drift
2nd Ave.
Ashworth Drift
No 1 12' Deep
No 2 19' Deep
No 3 24' Deep
Columbia No 3
Columbia No 1
Columbia No 2
Powelton No 3
Trial Drift
Moshannon Creek
Cut Stone mon.
Scale 1" = 200'
D
C.D. 806

4041