NEW SHAWMUT MINING COMPANY
3000± ACRES IN FEE

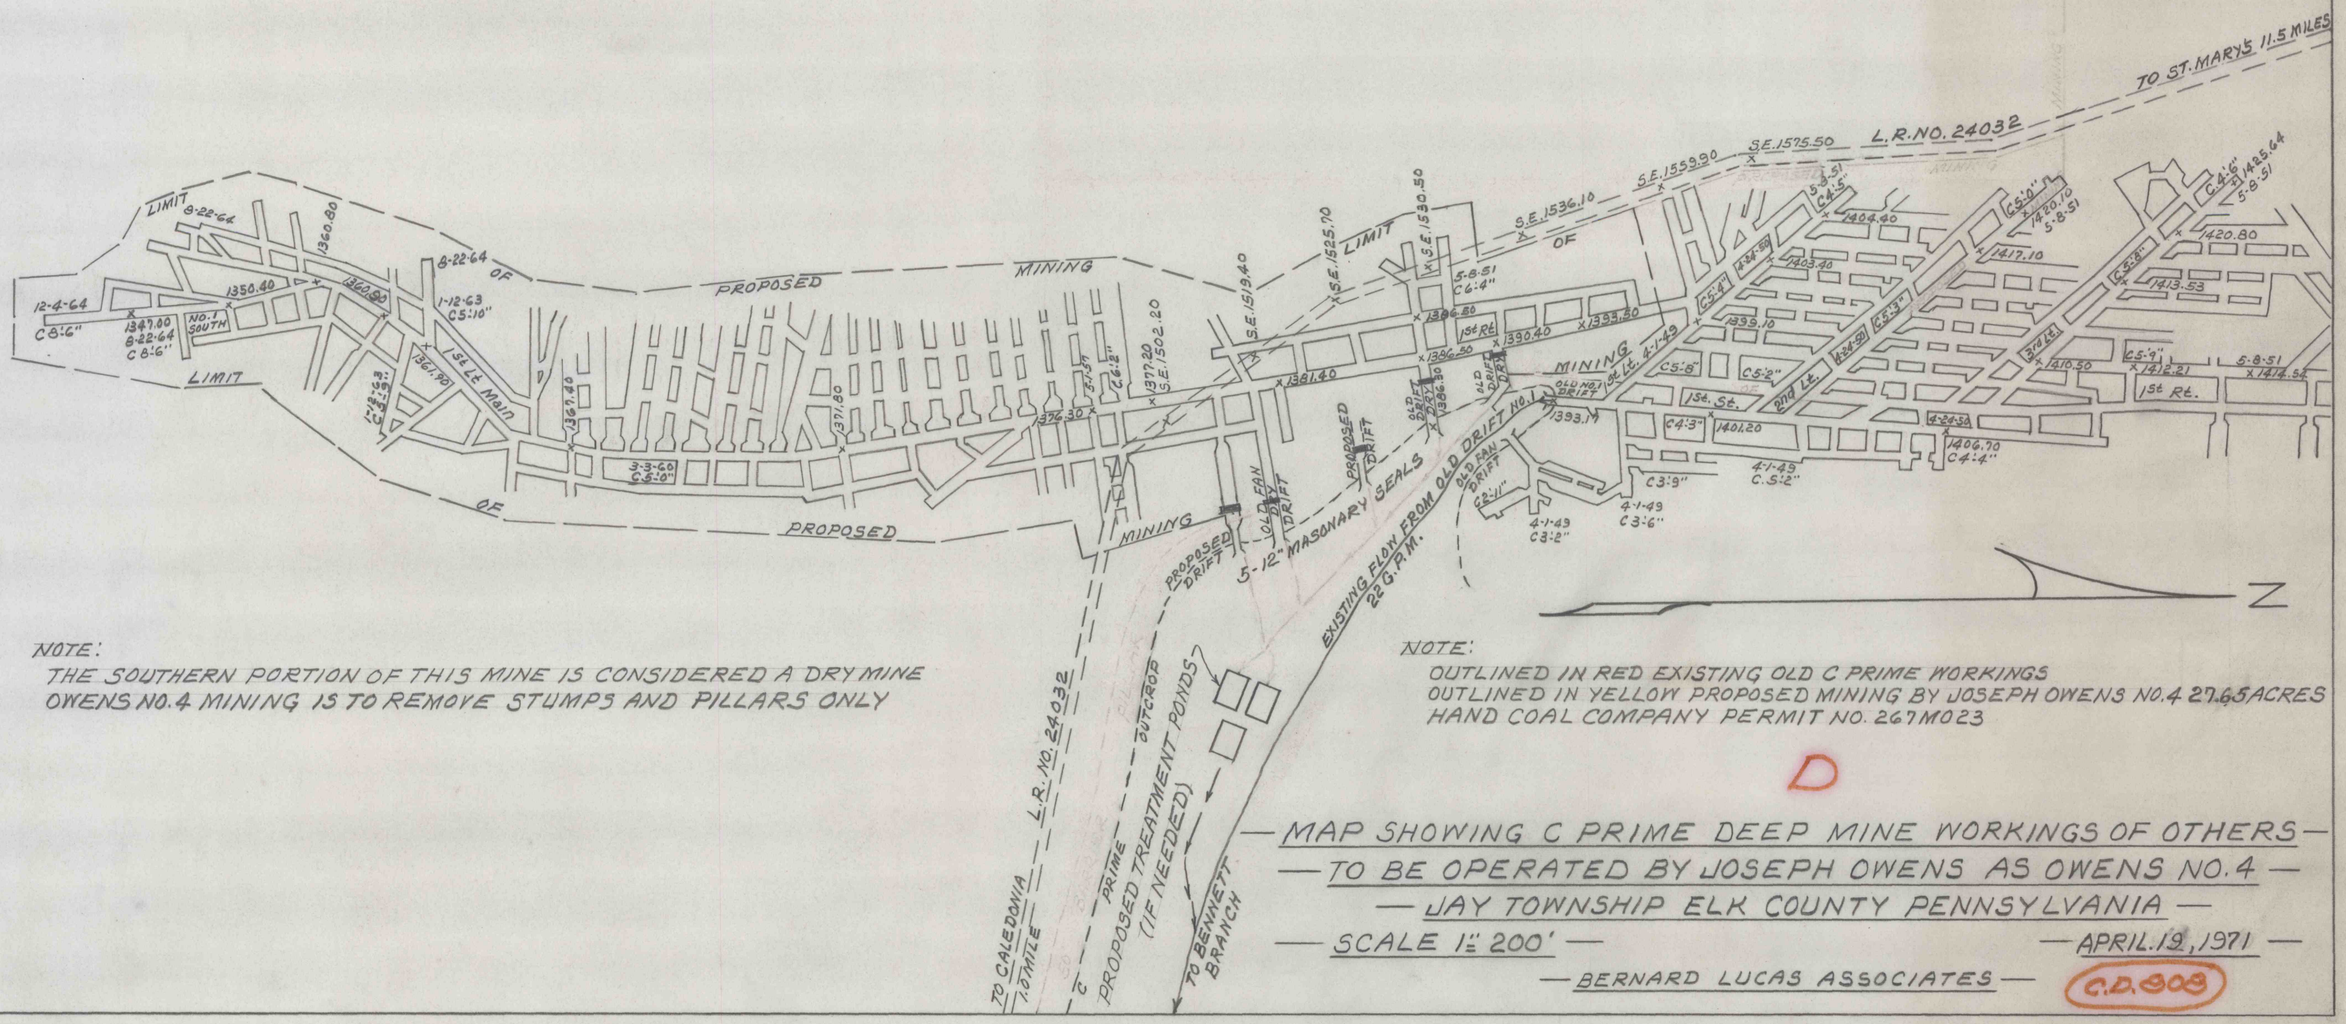

NOTE:
THE SOUTHERN PORTION OF THIS MINE IS CONSIDERED A DRY MINE
OWENS NO.4 MINING IS TO REMOVE STUMPS AND PILLARS ONLY

NOTE:
OUTLINED IN RED EXISTING OLD C PRIME WORKINGS
OUTLINED IN YELLOW PROPOSED MINING BY JOSEPH OWENS NO.4 27.65 ACRES
HAND COAL COMPANY PERMIT NO. 267M023

D

— MAP SHOWING C PRIME DEEP MINE WORKINGS OF OTHERS —
— TO BE OPERATED BY JOSEPH OWENS AS OWENS NO.4 —
— JAY TOWNSHIP ELK COUNTY PENNSYLVANIA —
— SCALE 1" = 200' — — APRIL 19, 1971 —
— BERNARD LUCAS ASSOCIATES —

C.D. 903

4079