


4009

4099

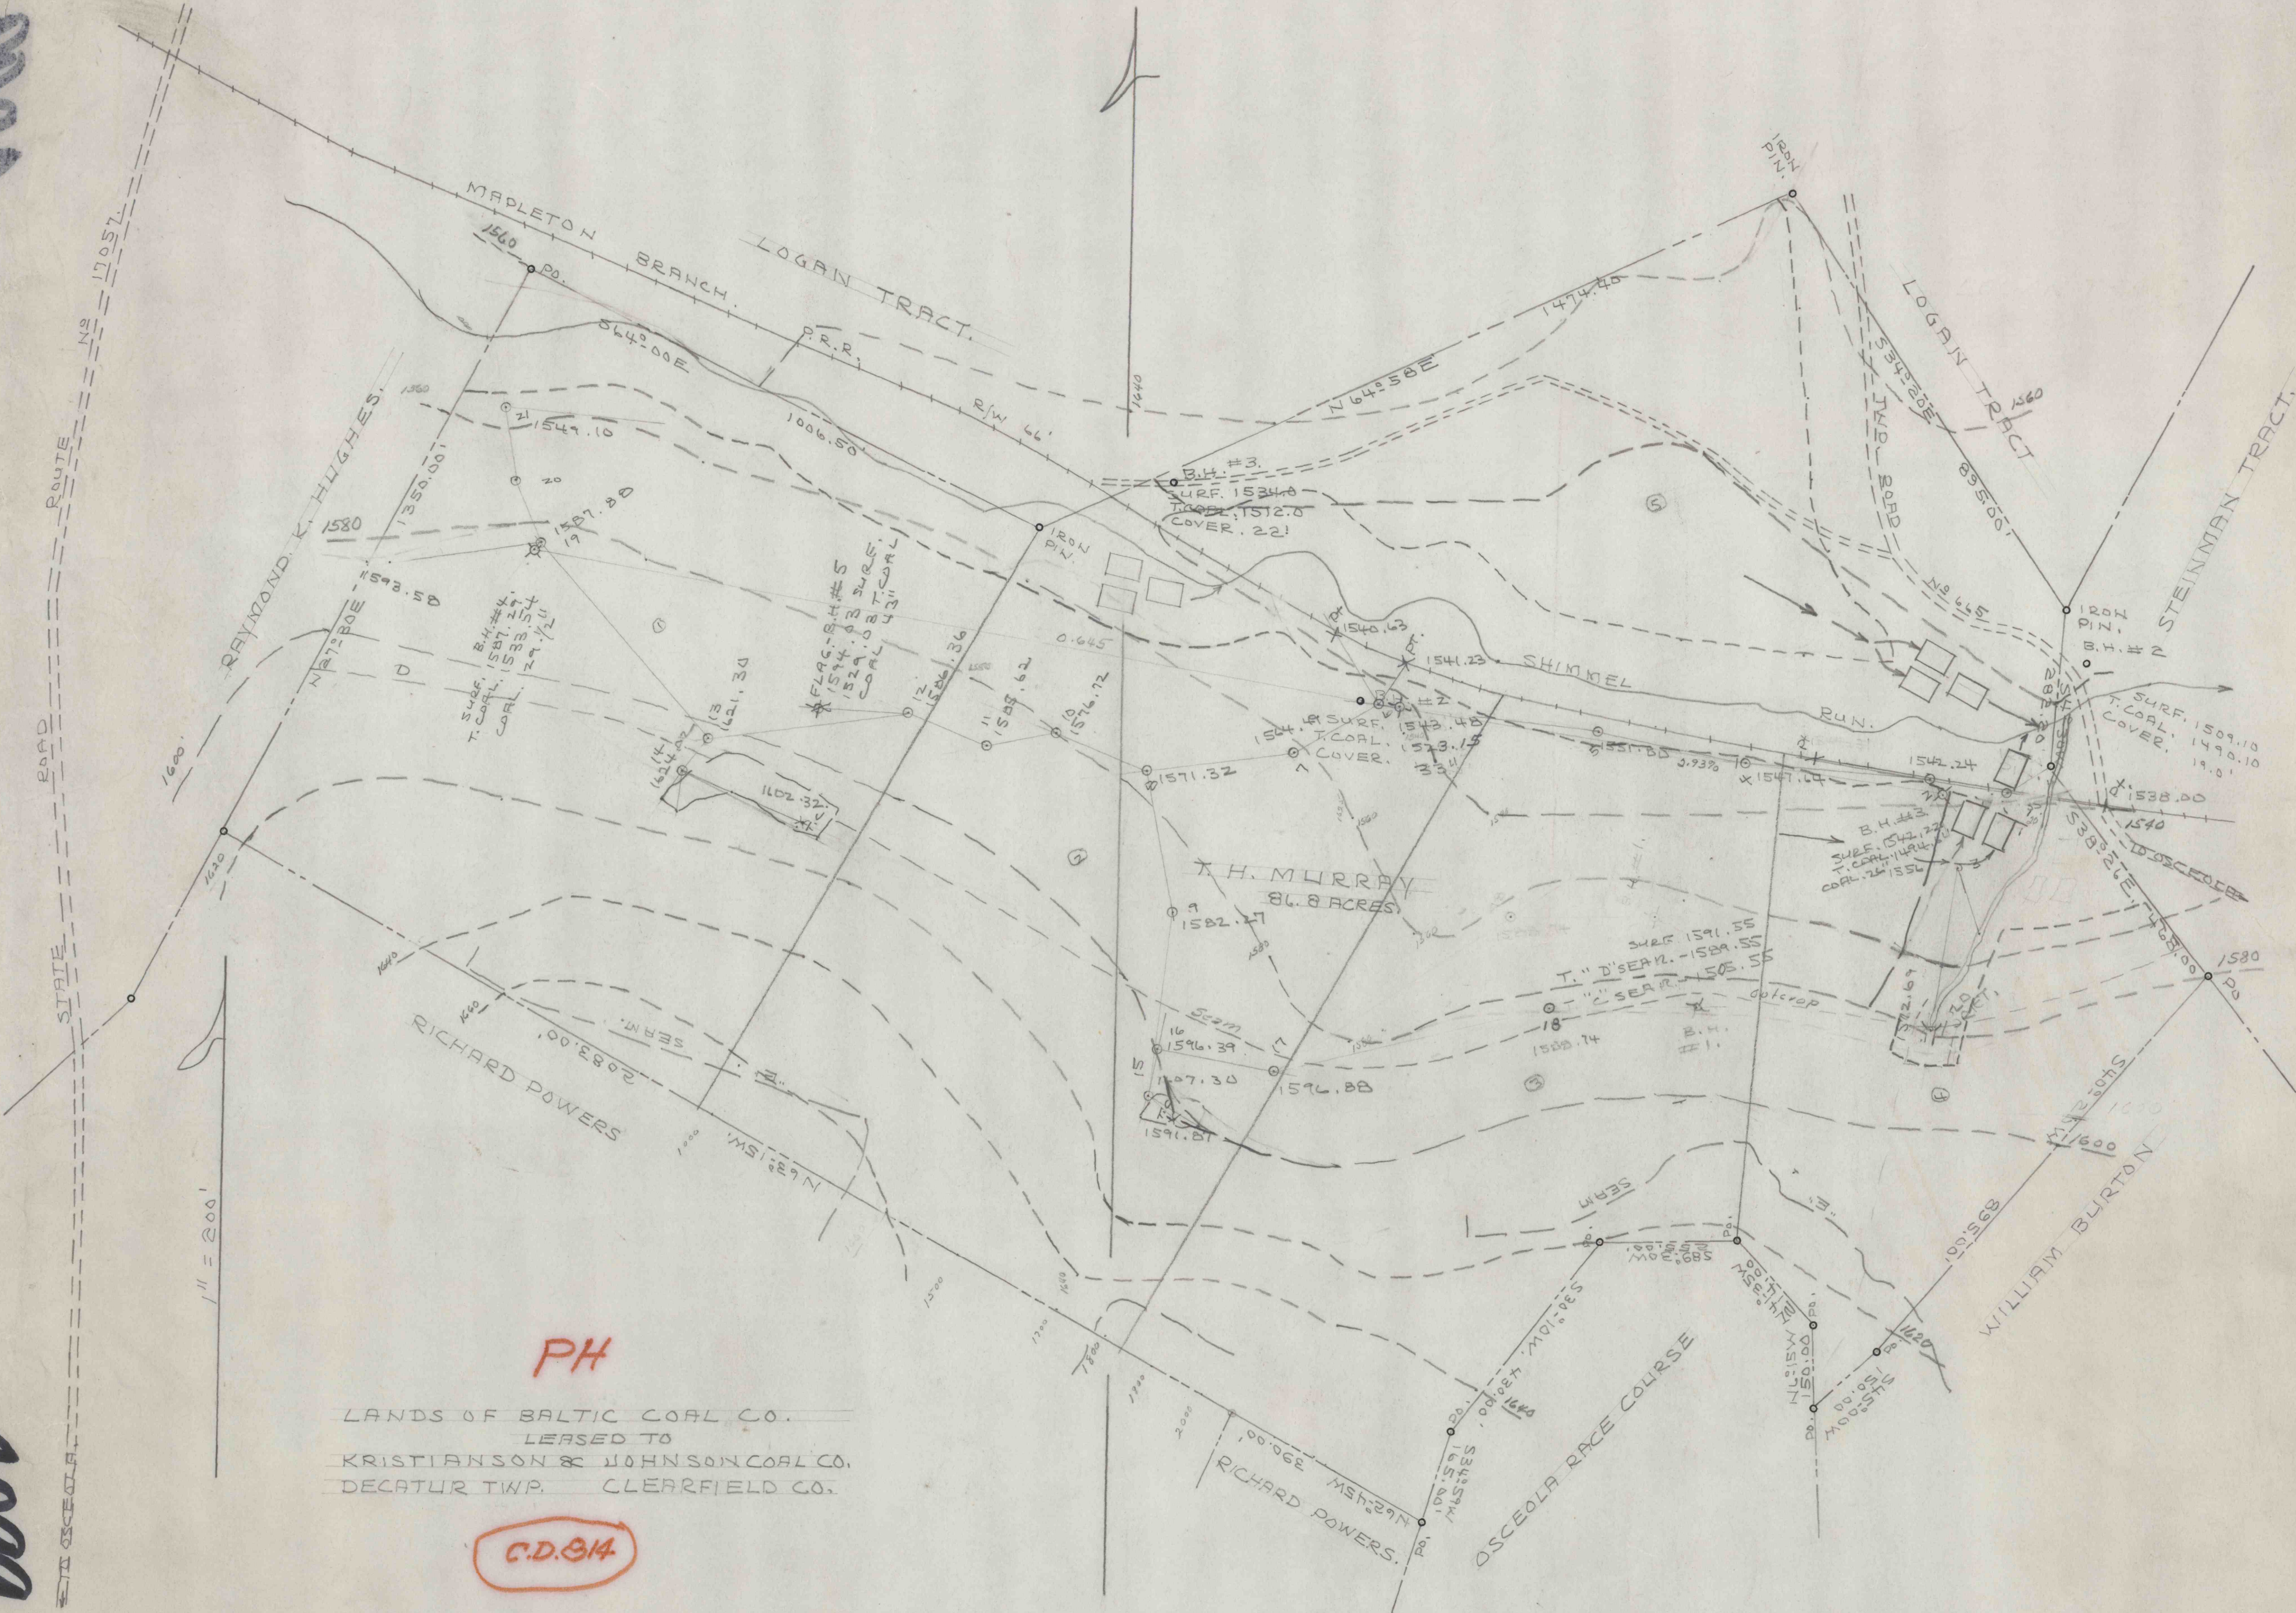

LANDS OF BALTIC COAL CO.
 LEASED TO
 KRISTIANSON & JOHNSON COAL CO.
 DECATUR TWP. CLEARFIELD CO.

PH
 C.D. 814