


4113

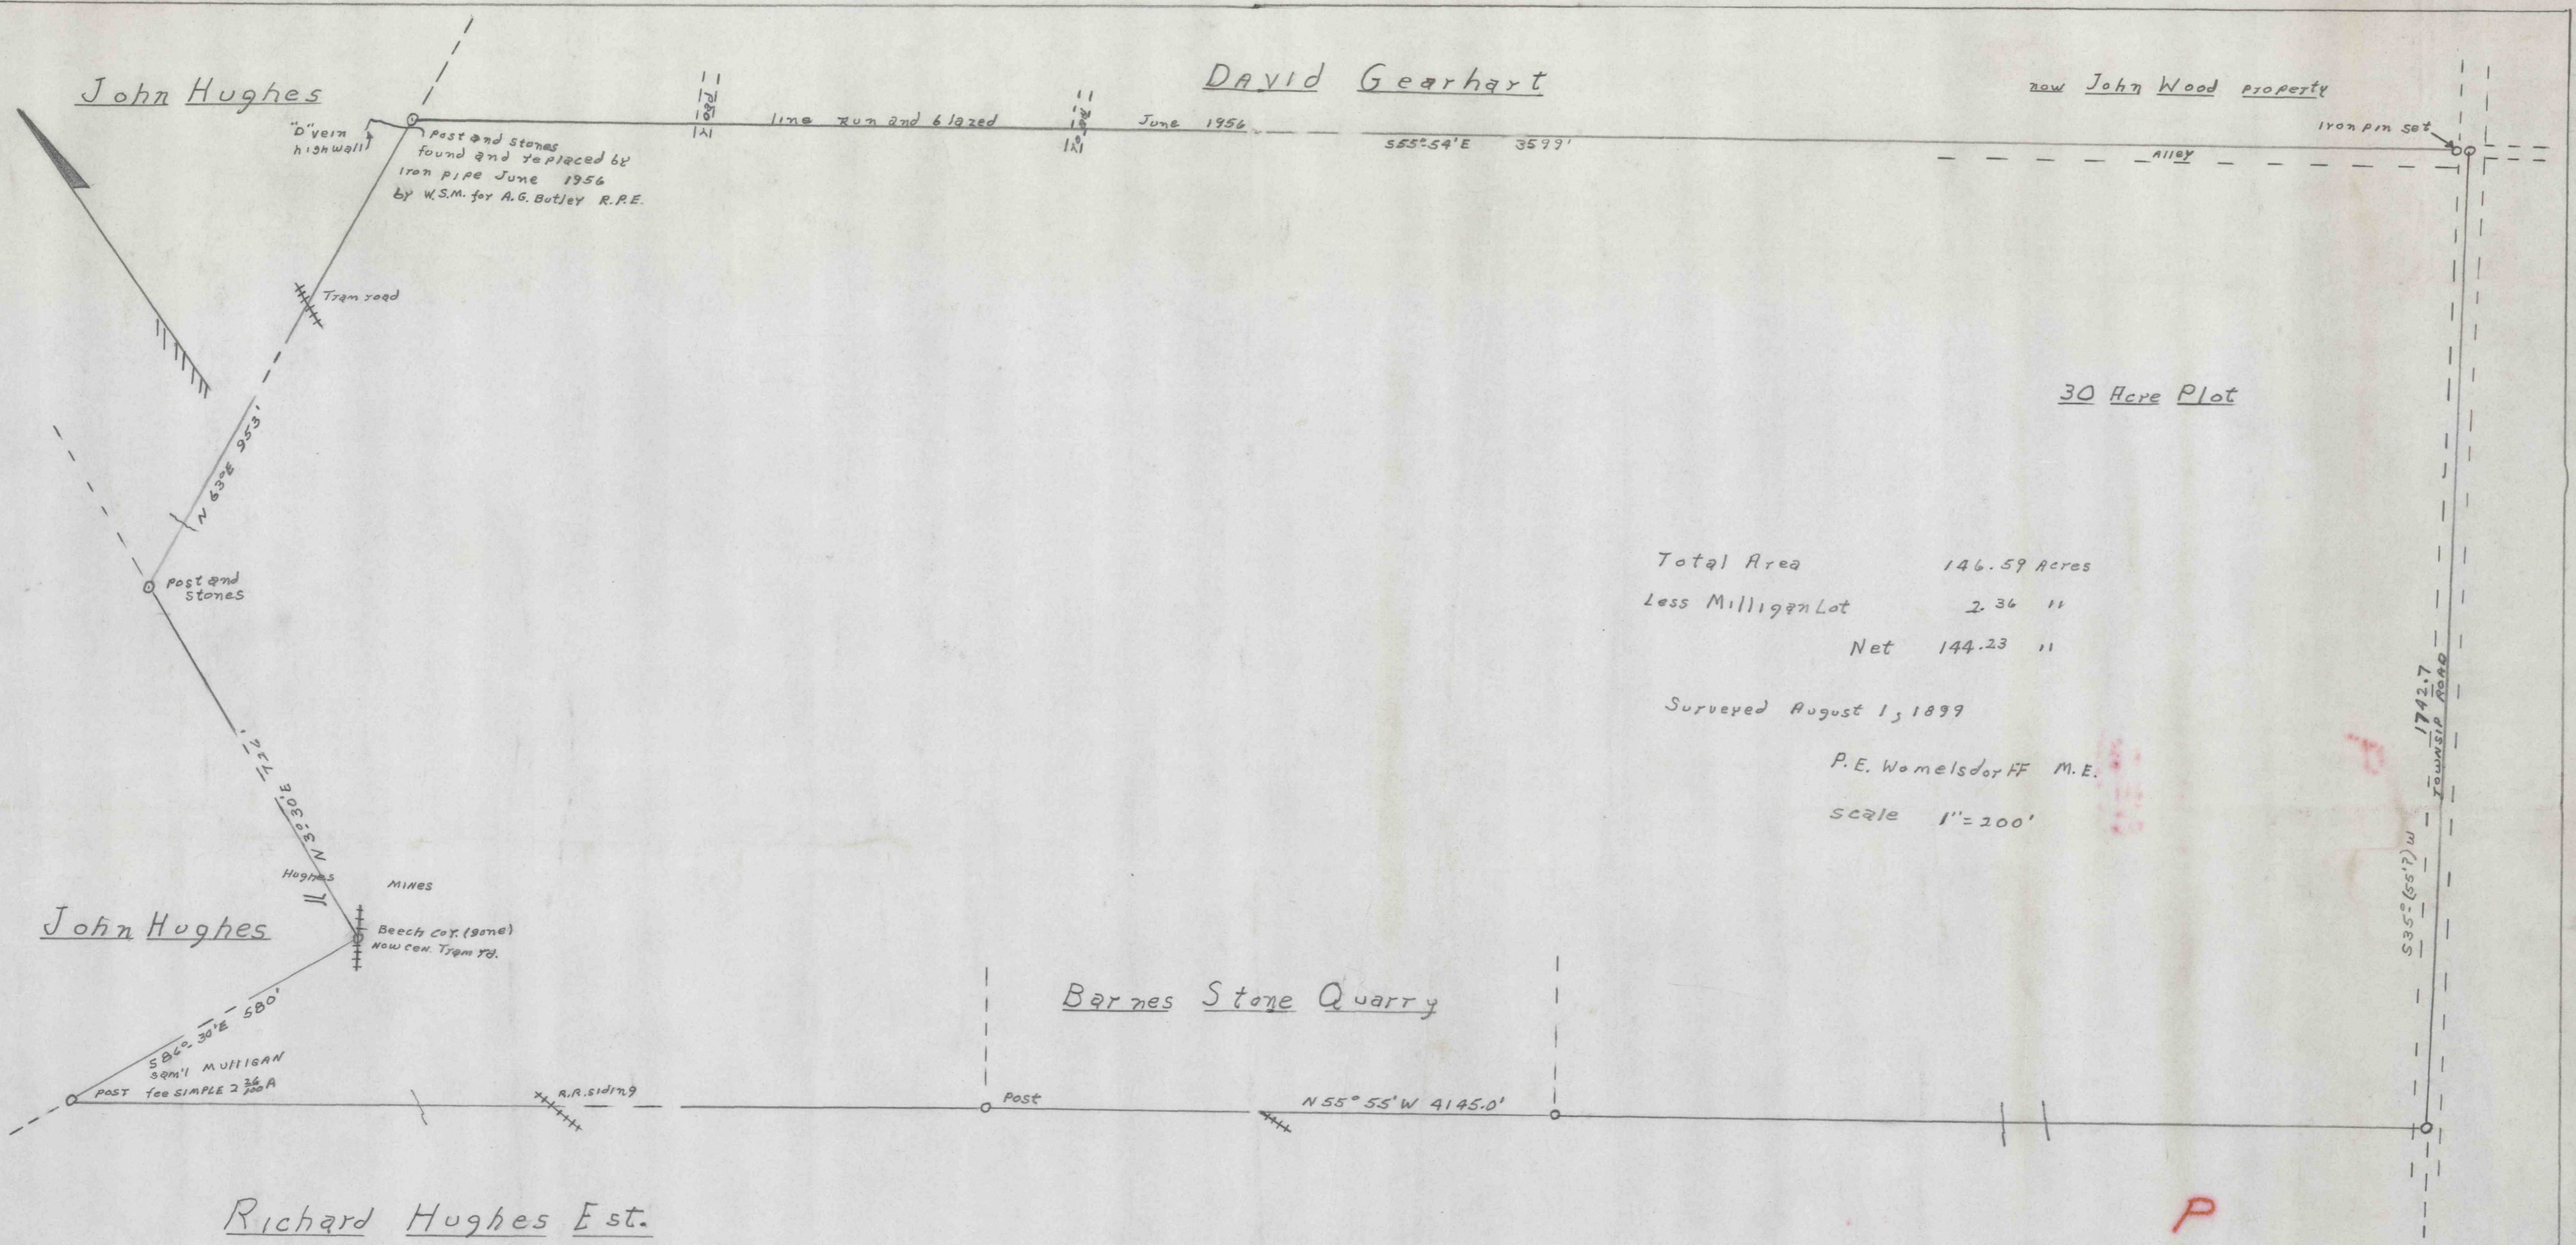

Total Area 146.59 Acres  
 Less Milligan Lot 2.36 "  
 Net 144.23 "

Surveyed August 1, 1899  
 P.E. Womelsdorff M.E.  
 scale 1"=200'

WILLIAM BUTTERWORTH  
 CHESTER HILL, PENNA.

Copy of old map by Womelsdorff  
 and Dunkle, Mining Engineers.

SCALE 1"=200' DATE 8-10-57 DRAWN BY W.S.M.

ALLEN G. BUTLER  
 PROFESSIONAL ENGINEER

NO. 40086

C.D. 319

4113