

CSM

SHANNON LAND & MINING COMPANY

J.H. & M. LASHER

TO BLOOMINGTON  
2.10 MILES

R.R. & B.M. KNEPP

TO LITTLE CLEARFIELD  
CREEK 1.45 MILES

NO. 17037

BIG RUN

TOWNSHIP ROAD NO. 7-450

LINE

LINE  
LINE

RALPH HENDERSON

J. AND M. LASHER

W.A. SNYDER


MAYNARD L. GOSS

T. AND N. GALLO

C.P. SNYDER

J.A. DAVIS

LAURA SNYDER

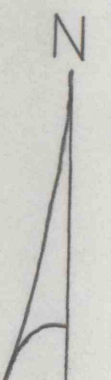

DAN. J. SPINGOLA

TOWNSHIP  
TOWNSHIP

STATE

PERMIT NO. 416-1

10.00 ACRES

8-30-67

1ST AMENDED

AREA

10.00 ACRES

1-22-68

5.00 ACRES

AREA

1-22-68

5.00 ACRES

AREA

OLD STRIPPING

SPILLS

AREA

10.75 ACRES

AREA

51.11 ACRES

AREA

3.16 ACRES






















TO NEW MILLPORT  
0.85 MILES

DAN. J. SPINGOLA

FERGUSON  
PIKE

D. M. BRESSLER

W. H. & G. NORRIS

ROBERT RISHEL

B.H. NO. 3 S.E. 1625.40  
E. COAL 1407.39  
D. COAL 1557.32

SNYDER  
CEMETERY

BLANCHE ROWLES

A.H. BLOOM EST.

NOTE:  
EXISTING WATER PERMIT NO. 3265 B.S.M. 21  
IN BROWN 'D' & 'E' SPOILS AREA 3.16 ACRES  
IN RED PROPOSED 'D' SEAM STRIPPING 10.75 ACRES  
IN YELLOW PROPOSED 'E' SEAM STRIPPING 51.11 ACRES

NOTE:  
8-30-67 BACKFILLED & LEVELED 15.00 ACRES  
1-22-68 BACKFILLED & LEVELED 5.00 ACRES

NOTE:  
ORIGINAL PERMIT NO. 416-1 10.00 ACRES  
1ST AMENDED AREA 10.00 ACRES IN RED

PM

MAP SHOWING 'D' & 'E' SEAM STRIPPINGS  
OPERATED BY DOMINICK ORLANDO  
PIKE TOWNSHIP CLEARFIELD COUNTY PA.  
SCALE 1" = 200' NOV. 1, 1966  
BERNARD LUCAS ASSOCIATES

C.D. 757

4133  
4135