


WALLACETON BOROUGH

H. DUNLAY ESTATE

GOSS ESTATE

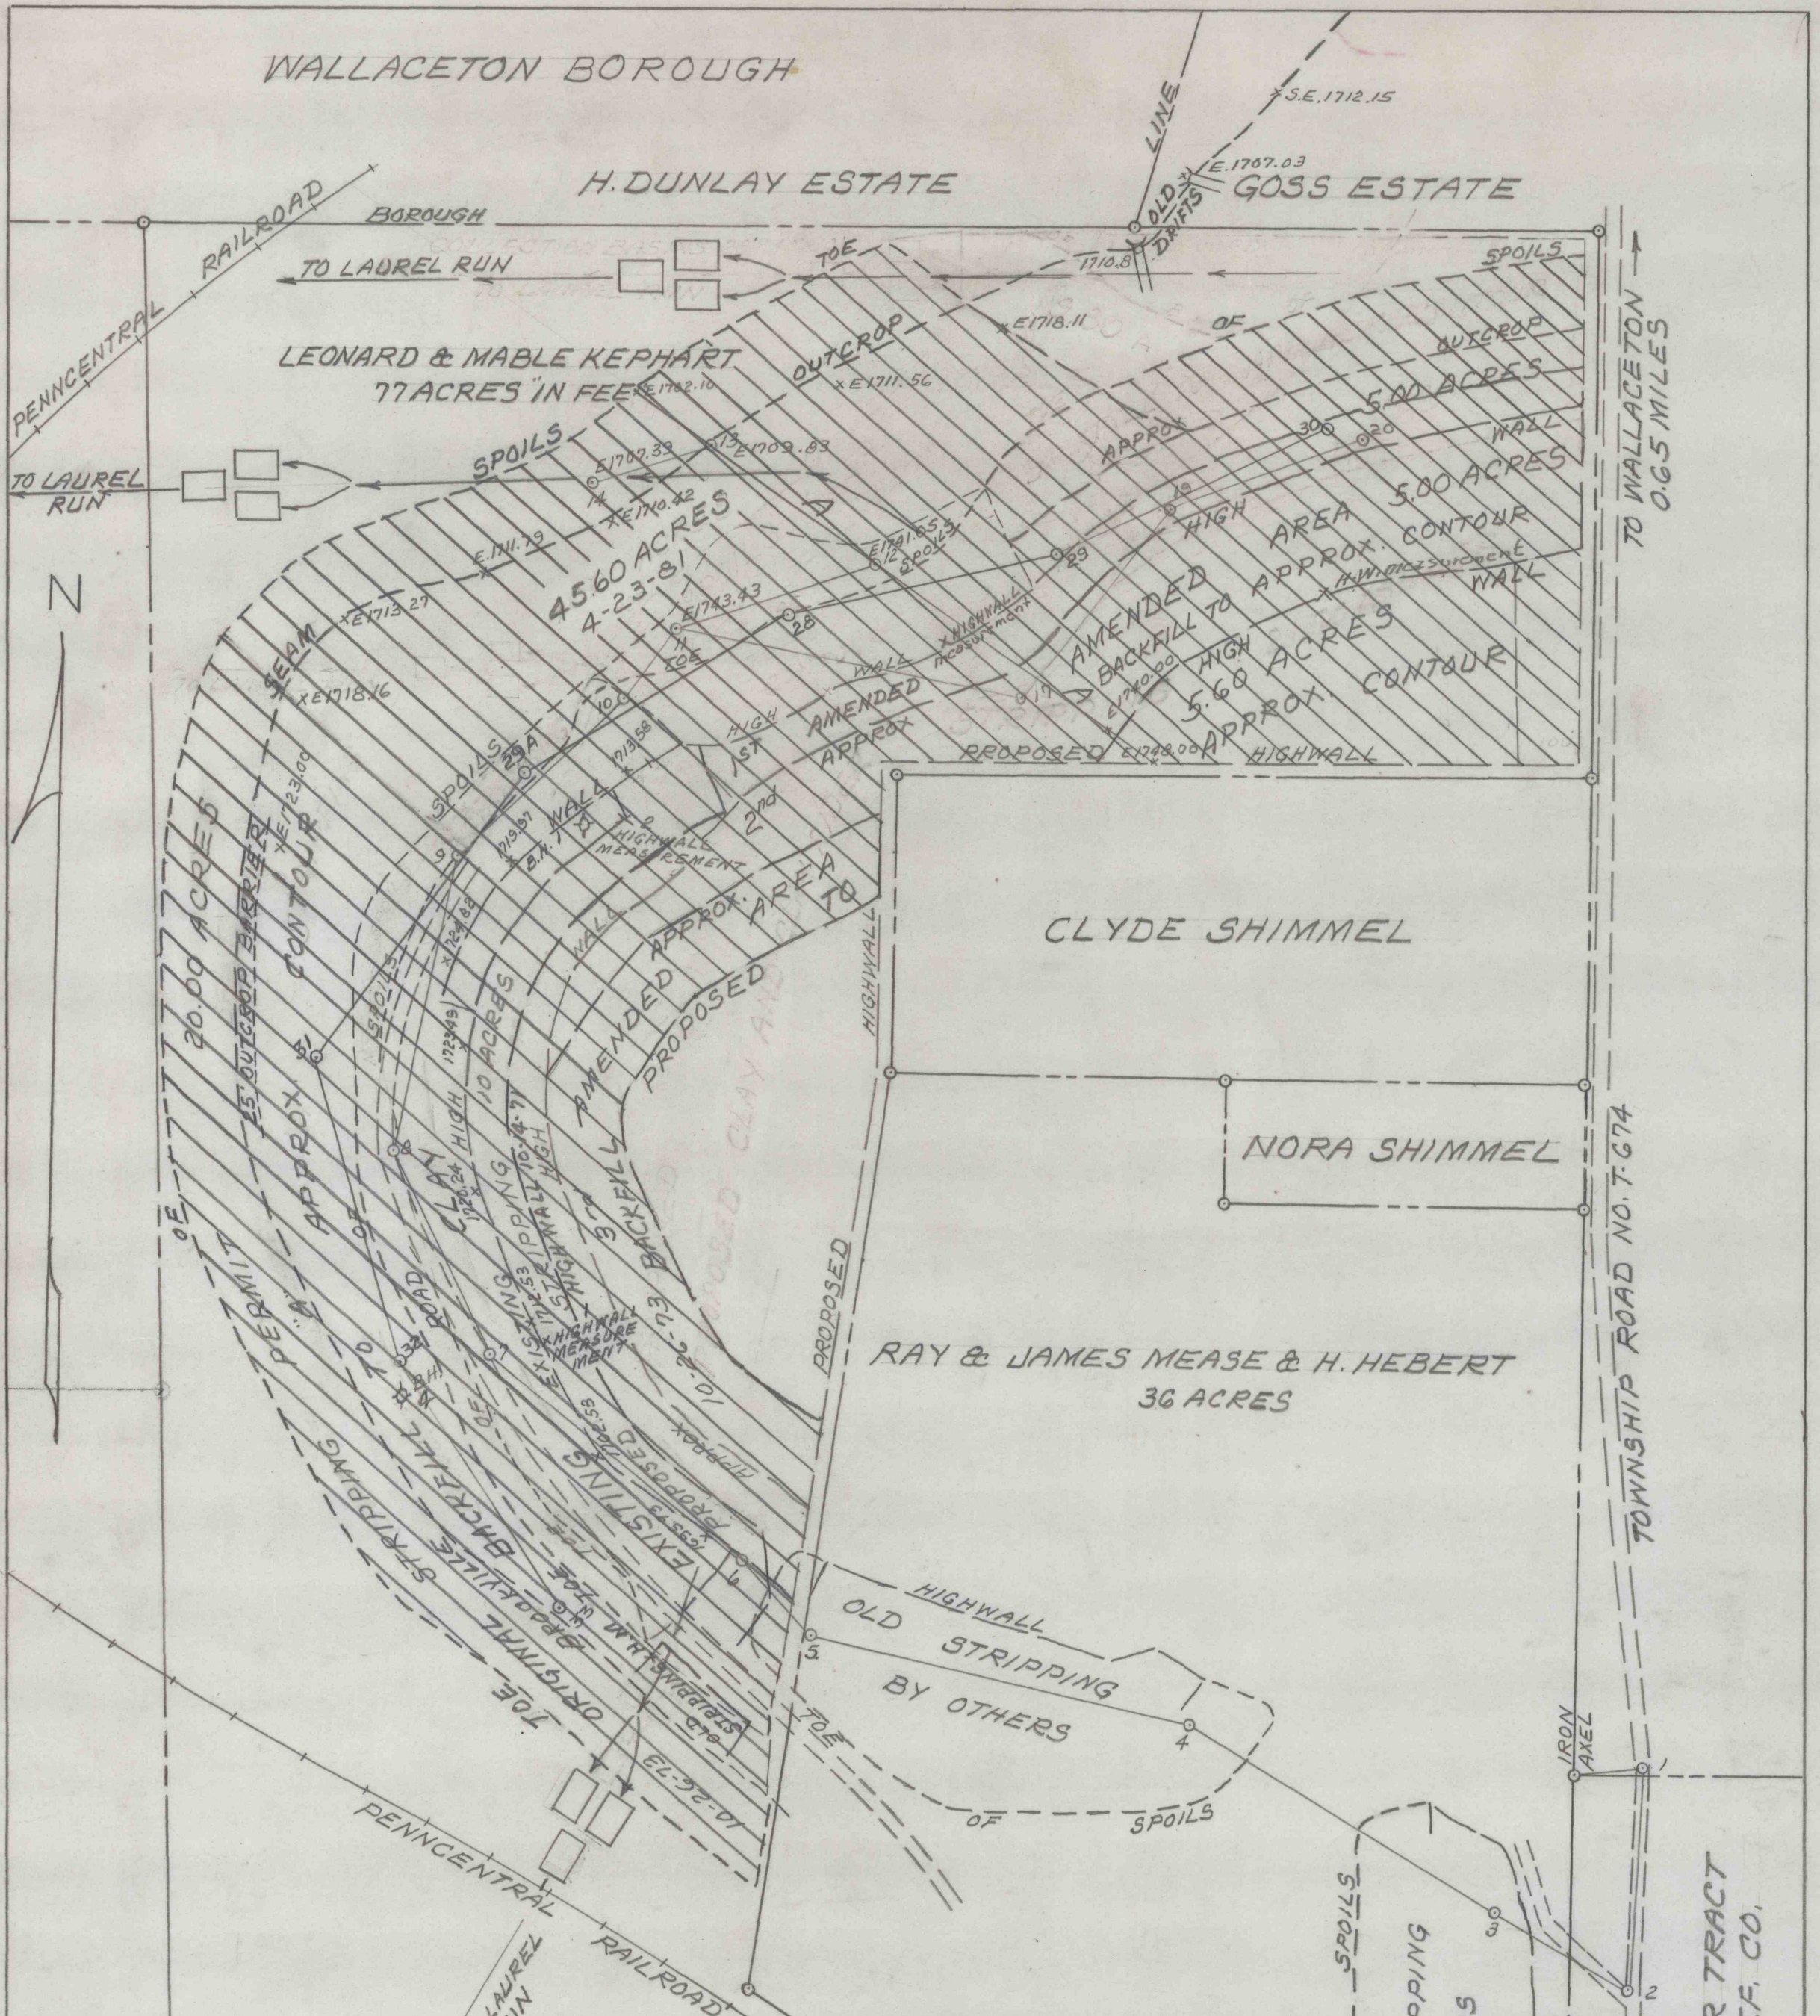

NOTE:  
 EXISTING MINE DRAINAGE PERMIT 268M017 1-23-69  
 AMENDED AREA  
 BROOKVILLE "A" STRIPPING 40.20 A. PLUS SPOILS 9.80A. = 5000 A.  
 CLAY SEAM & CLAY RIDER COAL STRIPPING 21.50 ACRES

NOTE:  
 LICENSE NO. 517-71  
 E. KEPHART  
 6-19-69 ORIGINAL PERMIT 10.00 A. - S.P. NO. 517-1 COLL. BOND NO. 8484 July 31 1969 300  
 8-6-70 1st AMENDED AREA 5.00 A. - S.P. NO. 517-1A COLL. BOND NO. 10754 500  
 10-19-71 2nd AMENDED AREA 5.00 A. - S.P. NO. 517-1A2 COLL. BOND NO. 12369 500  
 10-26-73 3rd AMENDED AREA 5.60 A. - S.P. NO. 517-1A BOND NO. 924A760A  
 10-26-73 ORIGINAL PERMIT 20.00 A. - S.P. NO. 517- BOND NO. 924A760A  
 4-23-81 BACKFILLED & LEVELED 45.60 A.

4182 M

MAP SHOWING CLAY SEAM STRIPPING  
 OPERATED BY ARDELL HAMER  
 BOGGS TWP. CLEARFIELD COUNTY PENNA.  
 SCALE 1" = 200' OCT. 27, 1968

BERNARD LUCAS ASSOC.  
 Rev. 2-16-71

C.D.791

5814