


655H  
4459

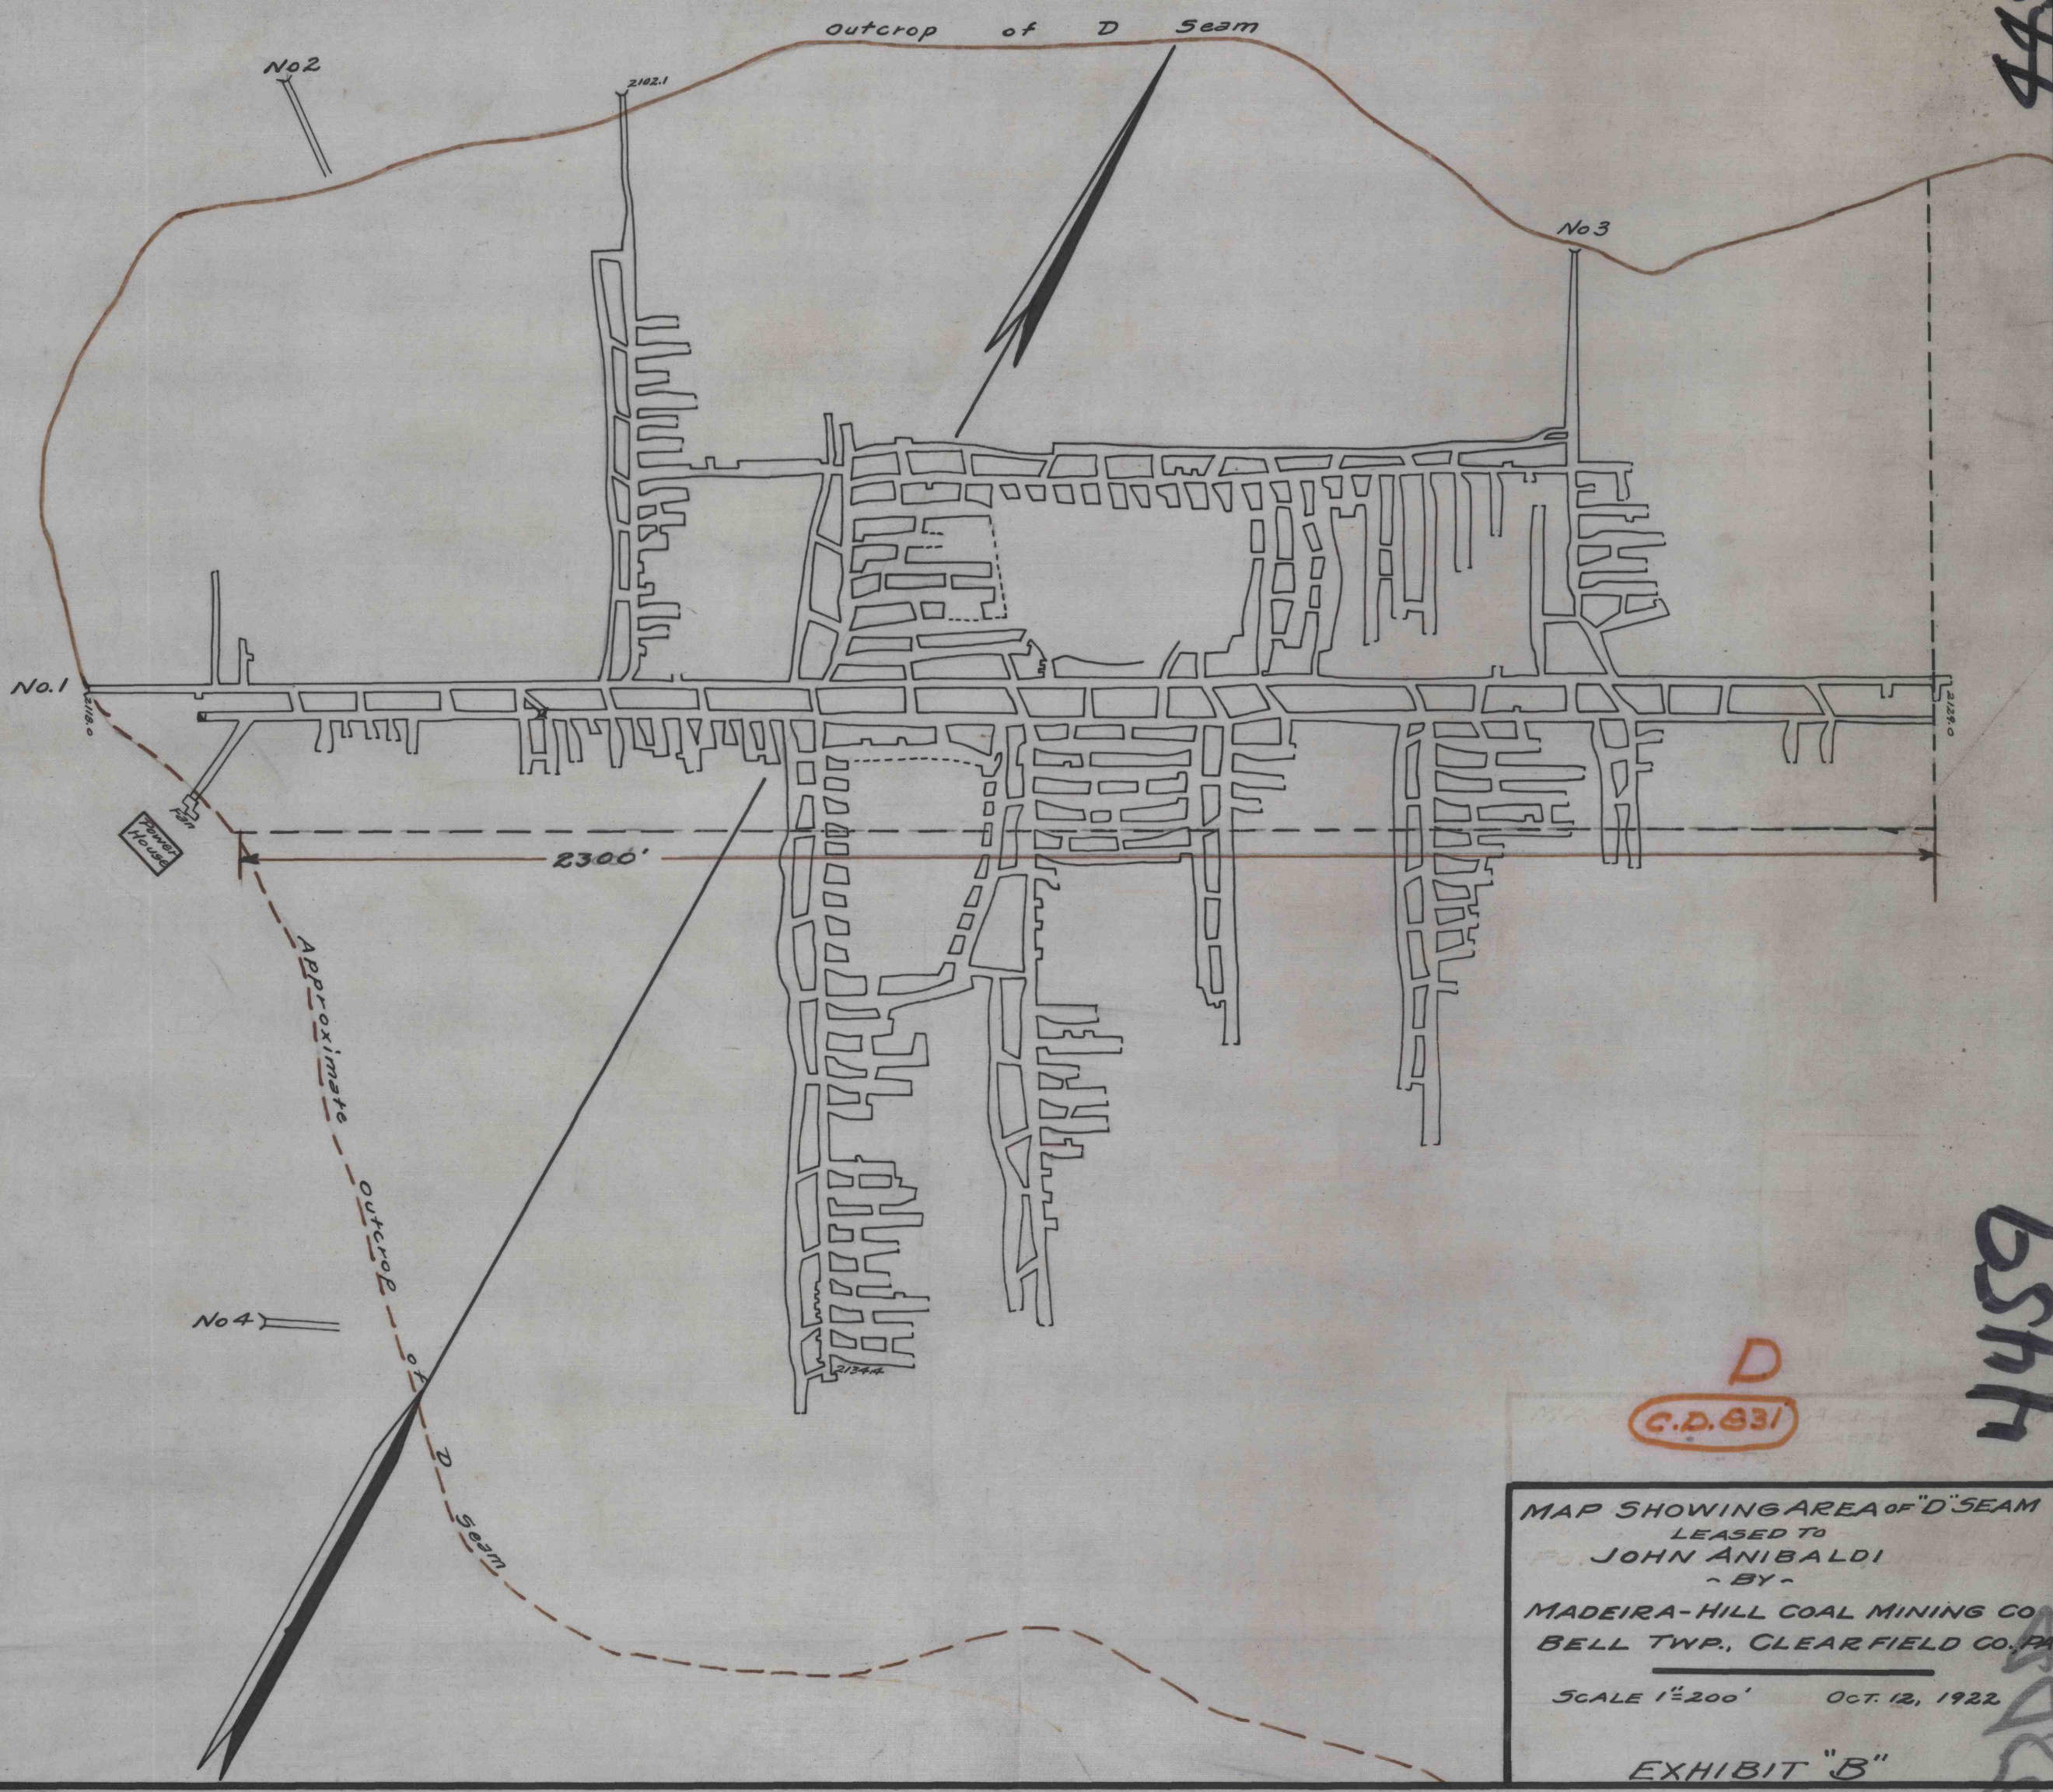

D  
 C.D. 831

MAP SHOWING AREA OF "D" SEAM  
 LEASED TO  
 JOHN ANIBALDI  
 - BY -  
 MADEIRA-HILL COAL MINING CO.  
 BELL TWP., CLEARFIELD CO., PA.  
 SCALE 1"=200'      OCT. 12, 1922  
 EXHIBIT "B"

655H  
4459

655H  
4459