

REFERENCE DATA

CRESCENT REFRACTORIES CO.

CURWENSVILLE, CLEARFIELD COUNTY, PA.

ENGINEERING DEPARTMENT

JOHN S. HOLDEN'S FARM.


ENV. No. *R2*

SHEET No. *53.*

50-3-474

SCALE 200' = 1"

DATE *8-27-20.*

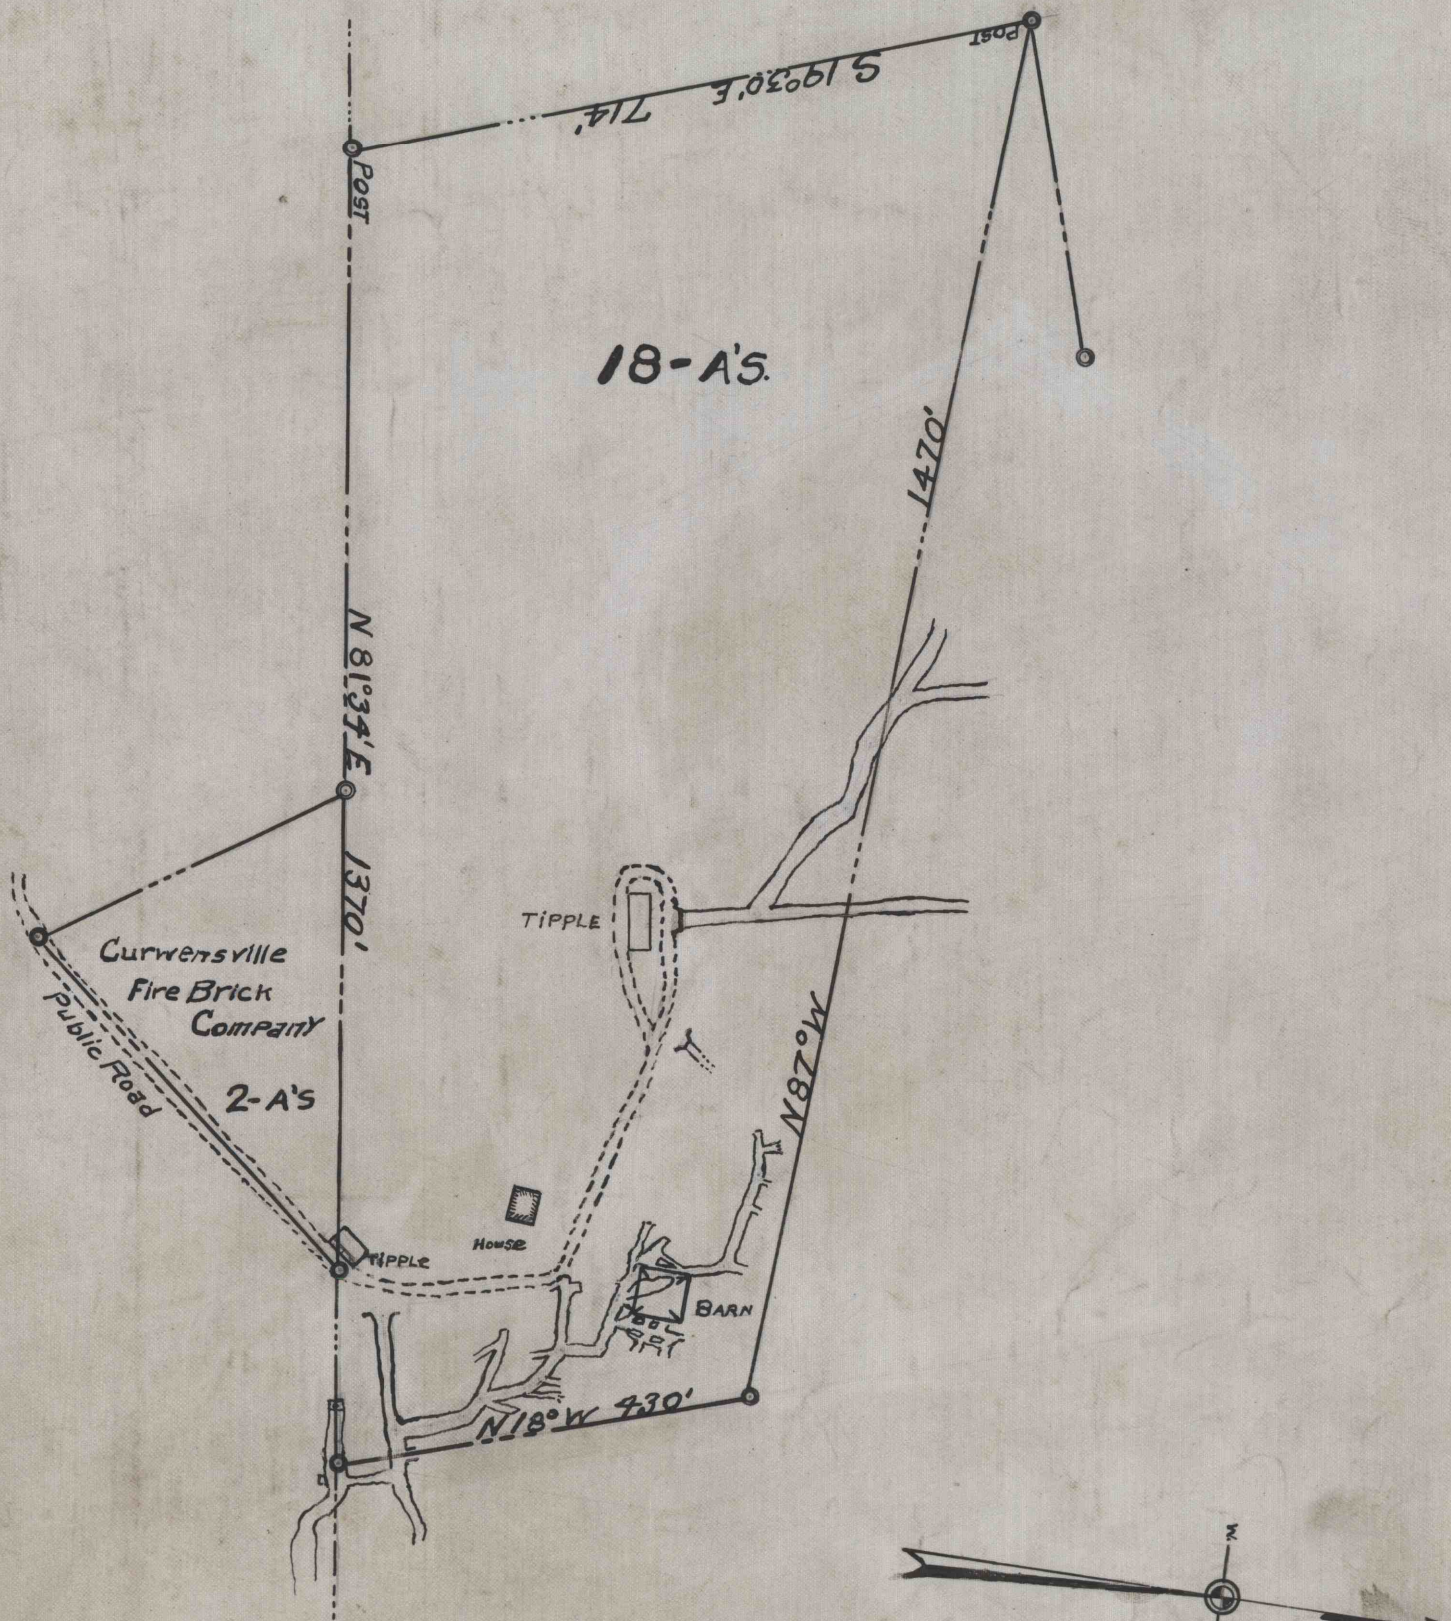

WORKED FROM *3001 N.*

DRAWN BY *B.T.*

CHECKED BY