


1391A

1391A

100  
200

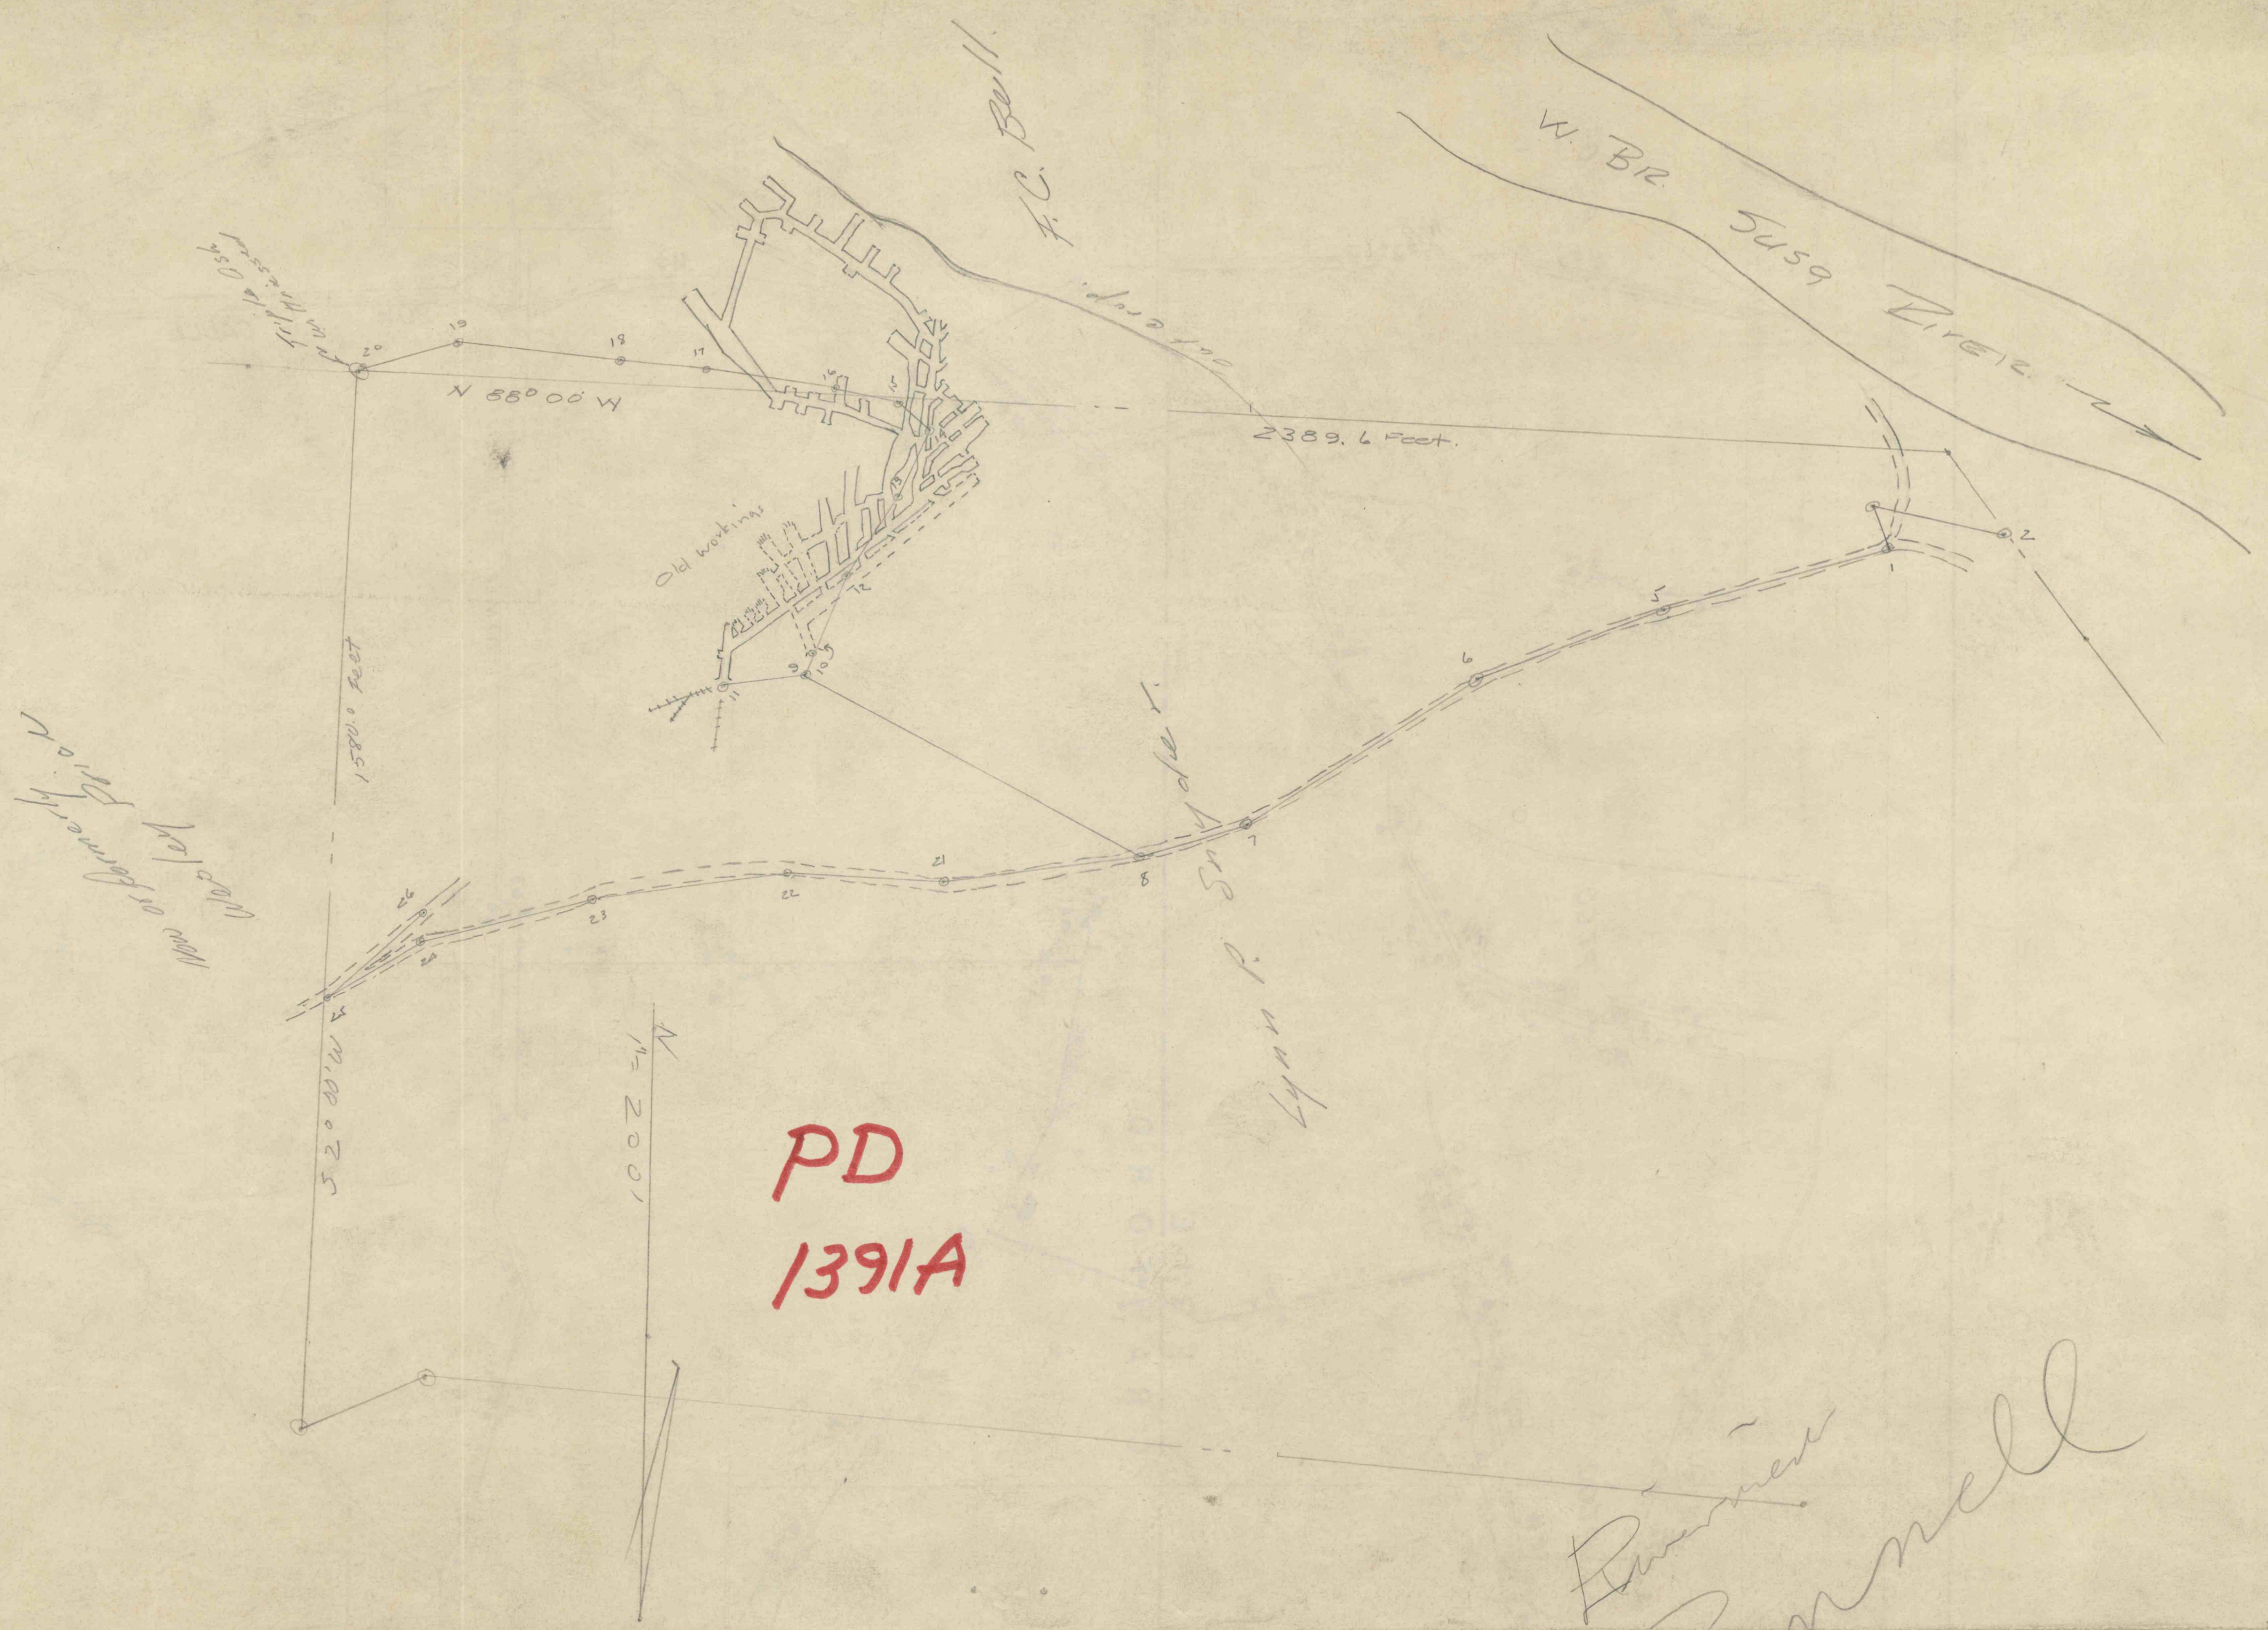

PD  
1391A

Barnes  
Samnell

1391A  
5066

1391A