


BM

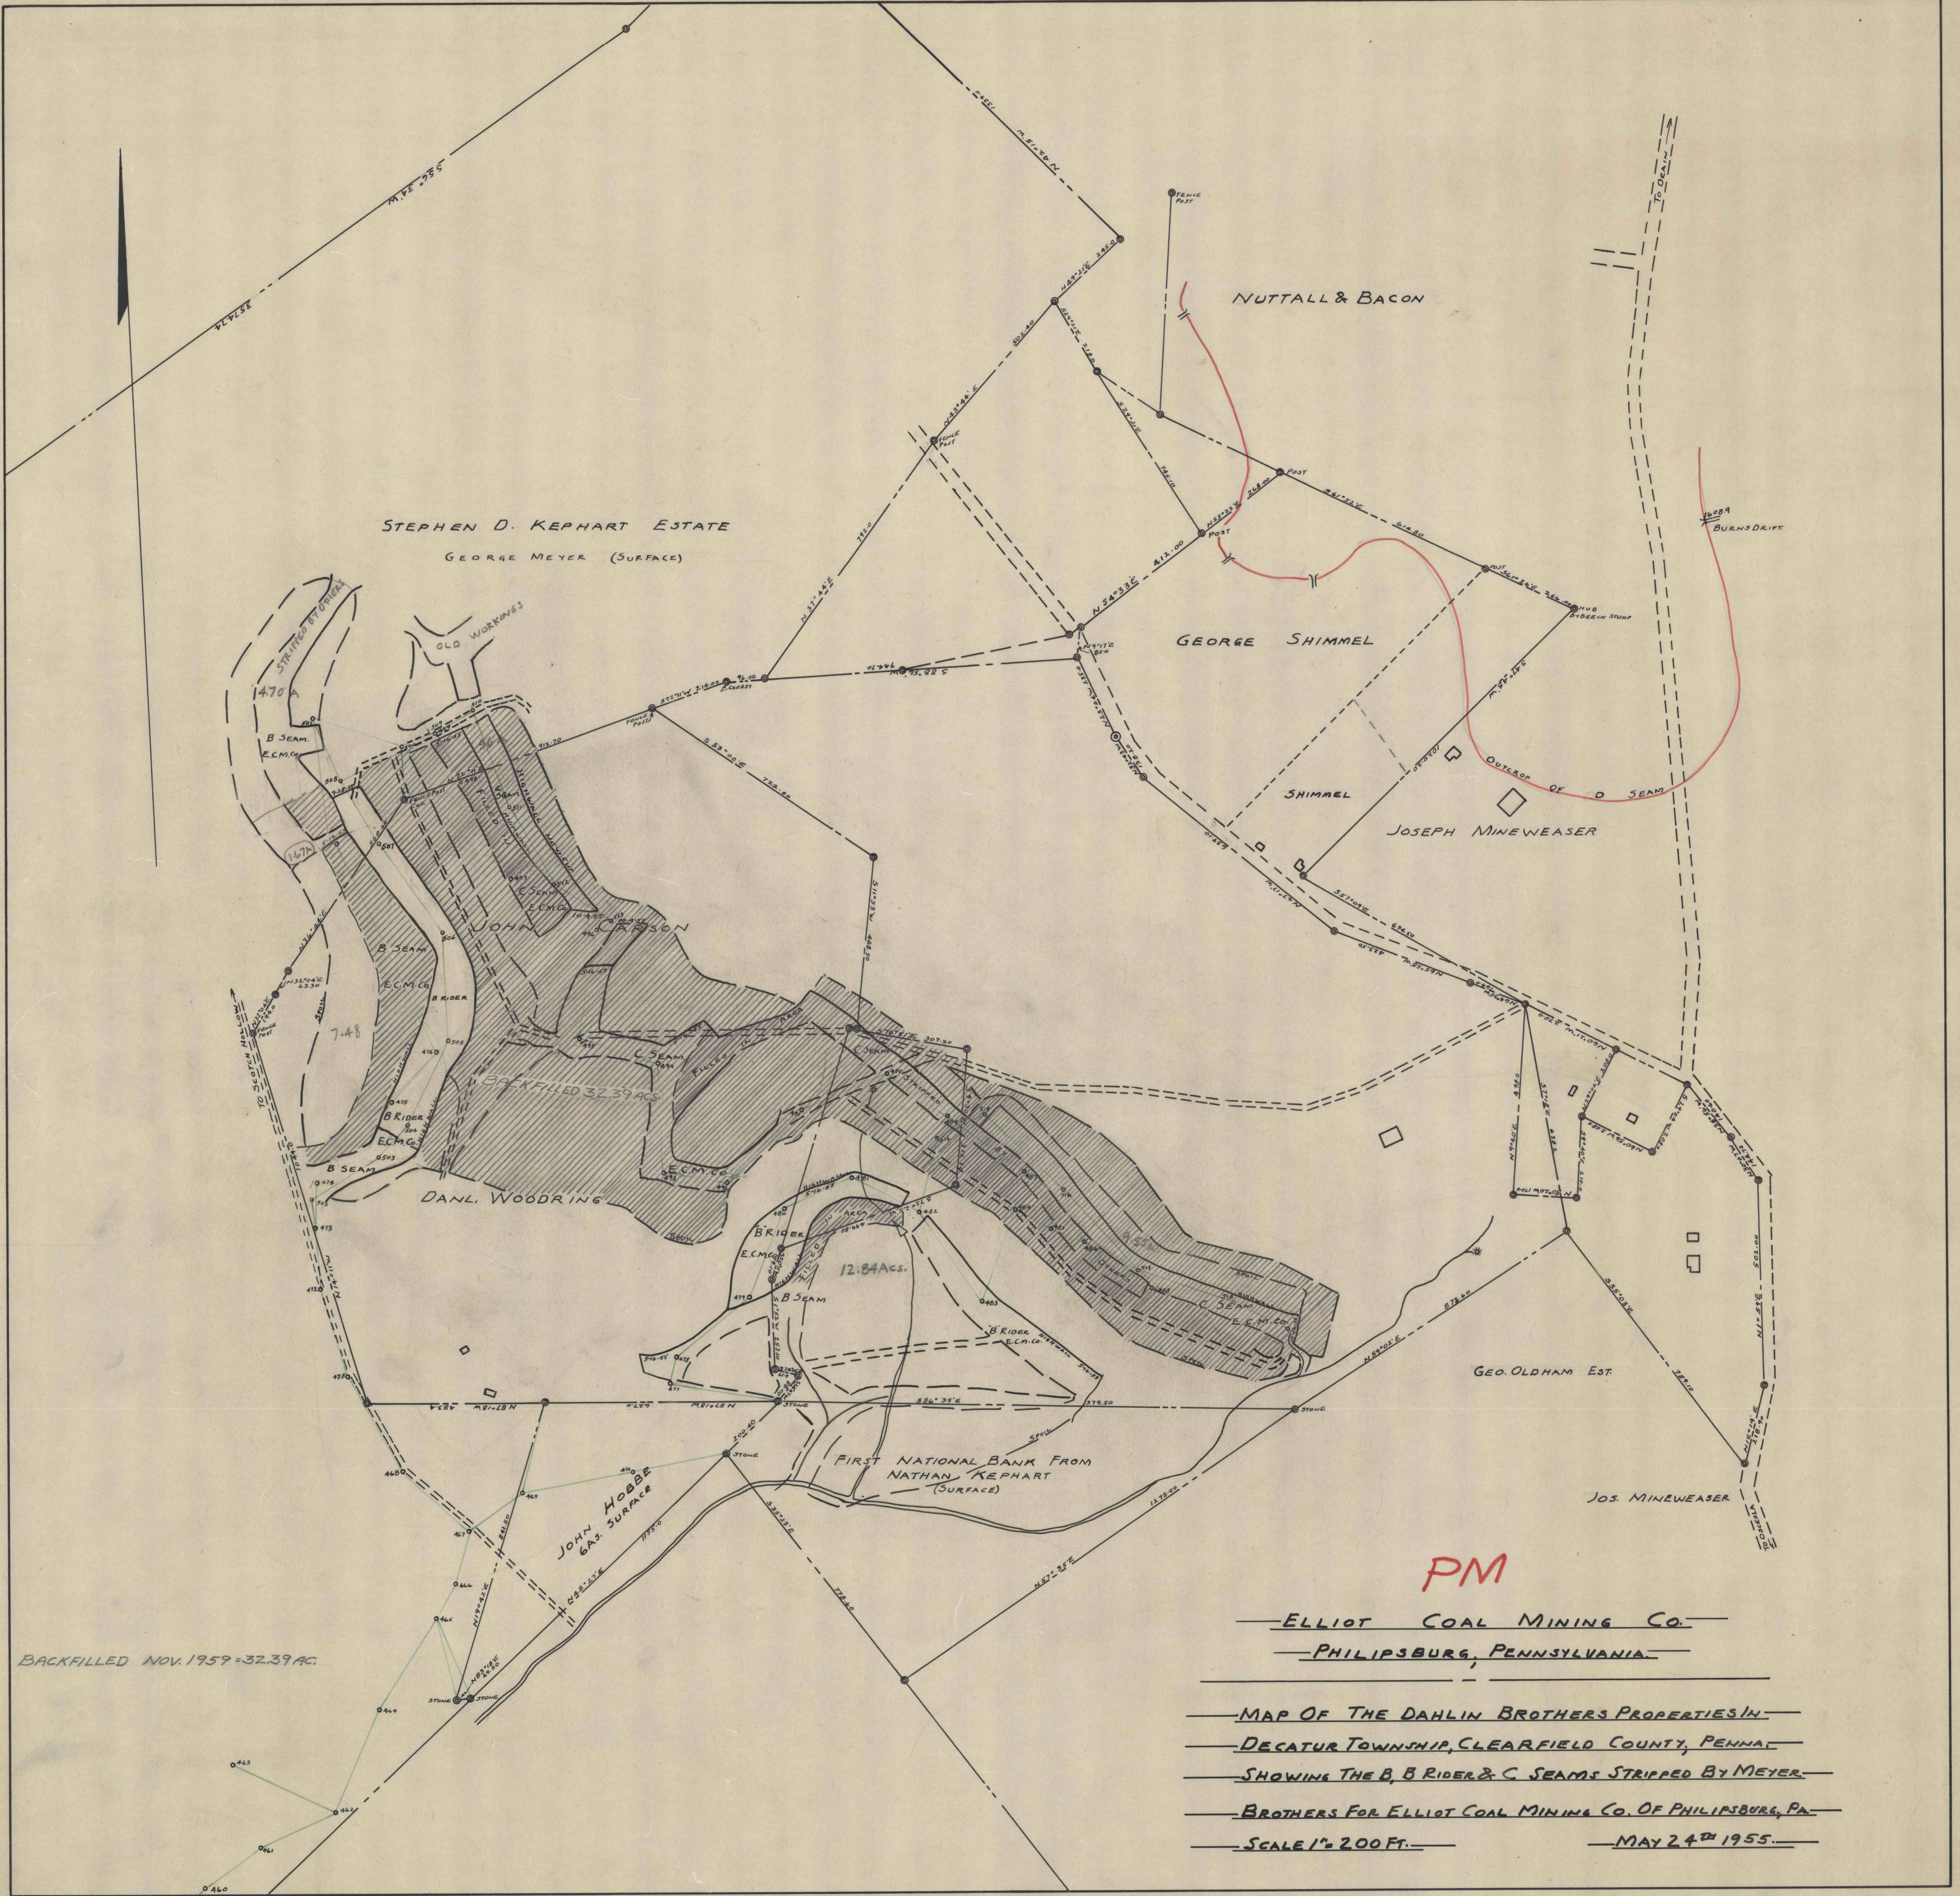

BACKFILLED NOV. 1959 = 32.39 AC.

PM

— ELLIOT COAL MINING CO. —  
 — PHILIPSBURG, PENNSYLVANIA. —

— MAP OF THE DAHLIN BROTHERS PROPERTIES IN —  
 — DECATUR TOWNSHIP, CLEARFIELD COUNTY, PENNA. —  
 — SHOWING THE B, B RIDER & C SEAMS STRIPPED BY MEYER —  
 — BROTHERS FOR ELLIOT COAL MINING CO. OF PHILIPSBURG, PA. —  
 — SCALE 1" = 200 FT. — MAY 24<sup>TH</sup> 1955. —

P822

28  
29  
VOL 1 P 35 55002