


22-5-5

22-5-5

WORKED FROM 56-2-12
SCALE 1" = 200 FT.

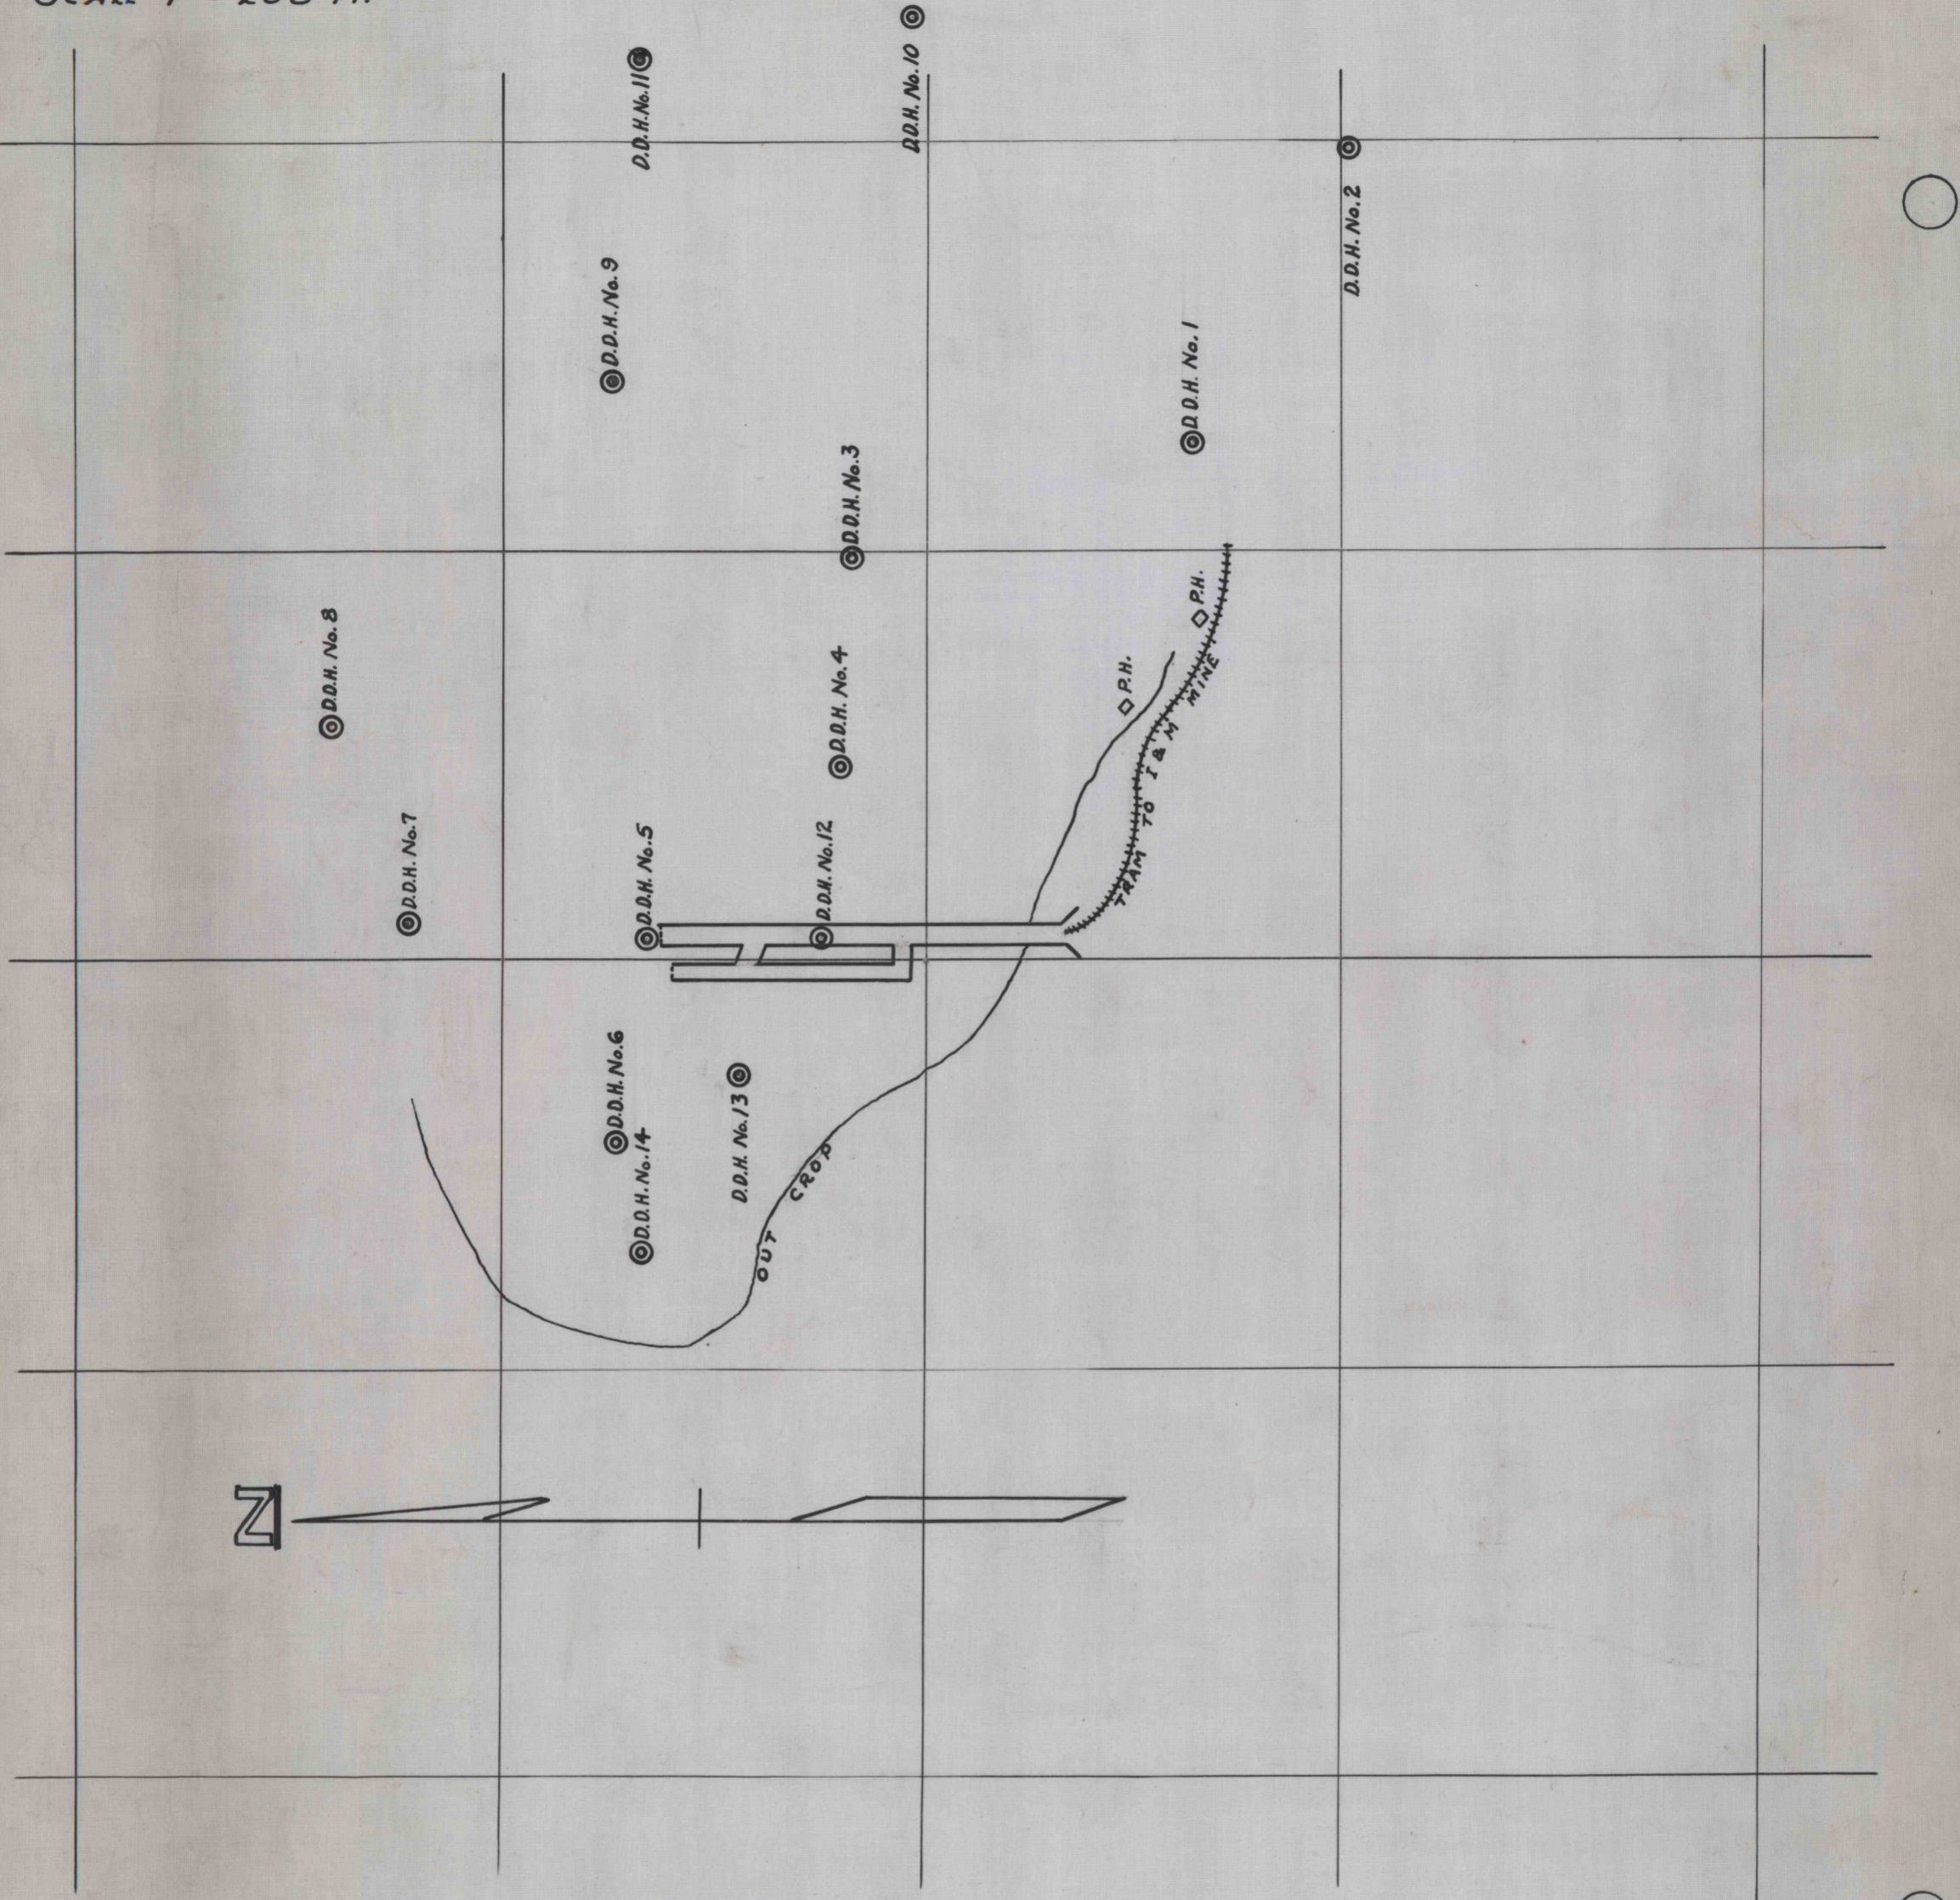

D. D. H. LOCATION
IRVIN & MURRAY No. 2

APRIL 19, 1938

56-2-24

56-2-24