
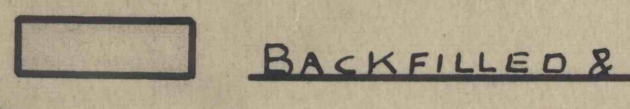


PM

ELLIOT COAL MINING CO.
PHILIPSBURG, PENNSYLVANIA.
MAP SHOWING B, C, D & E SEAM
STRIPPINGS, BACKFILLED & PLANTED
AREA ON PHILIPSBURG COAL & LAND CO.
PROPERTY & OTHERS OPERATED BY ELLIOT
COAL MINING COMPANY IN RUSH
TOWNSHIP CENTRE COUNTY, PENNA.
SCALE 1" = 200' JULY 31st 1952.

6095
8095

LEGEND

-  BACKFILLED
-  BACKFILLED & PLANTED



6095
710

BW