



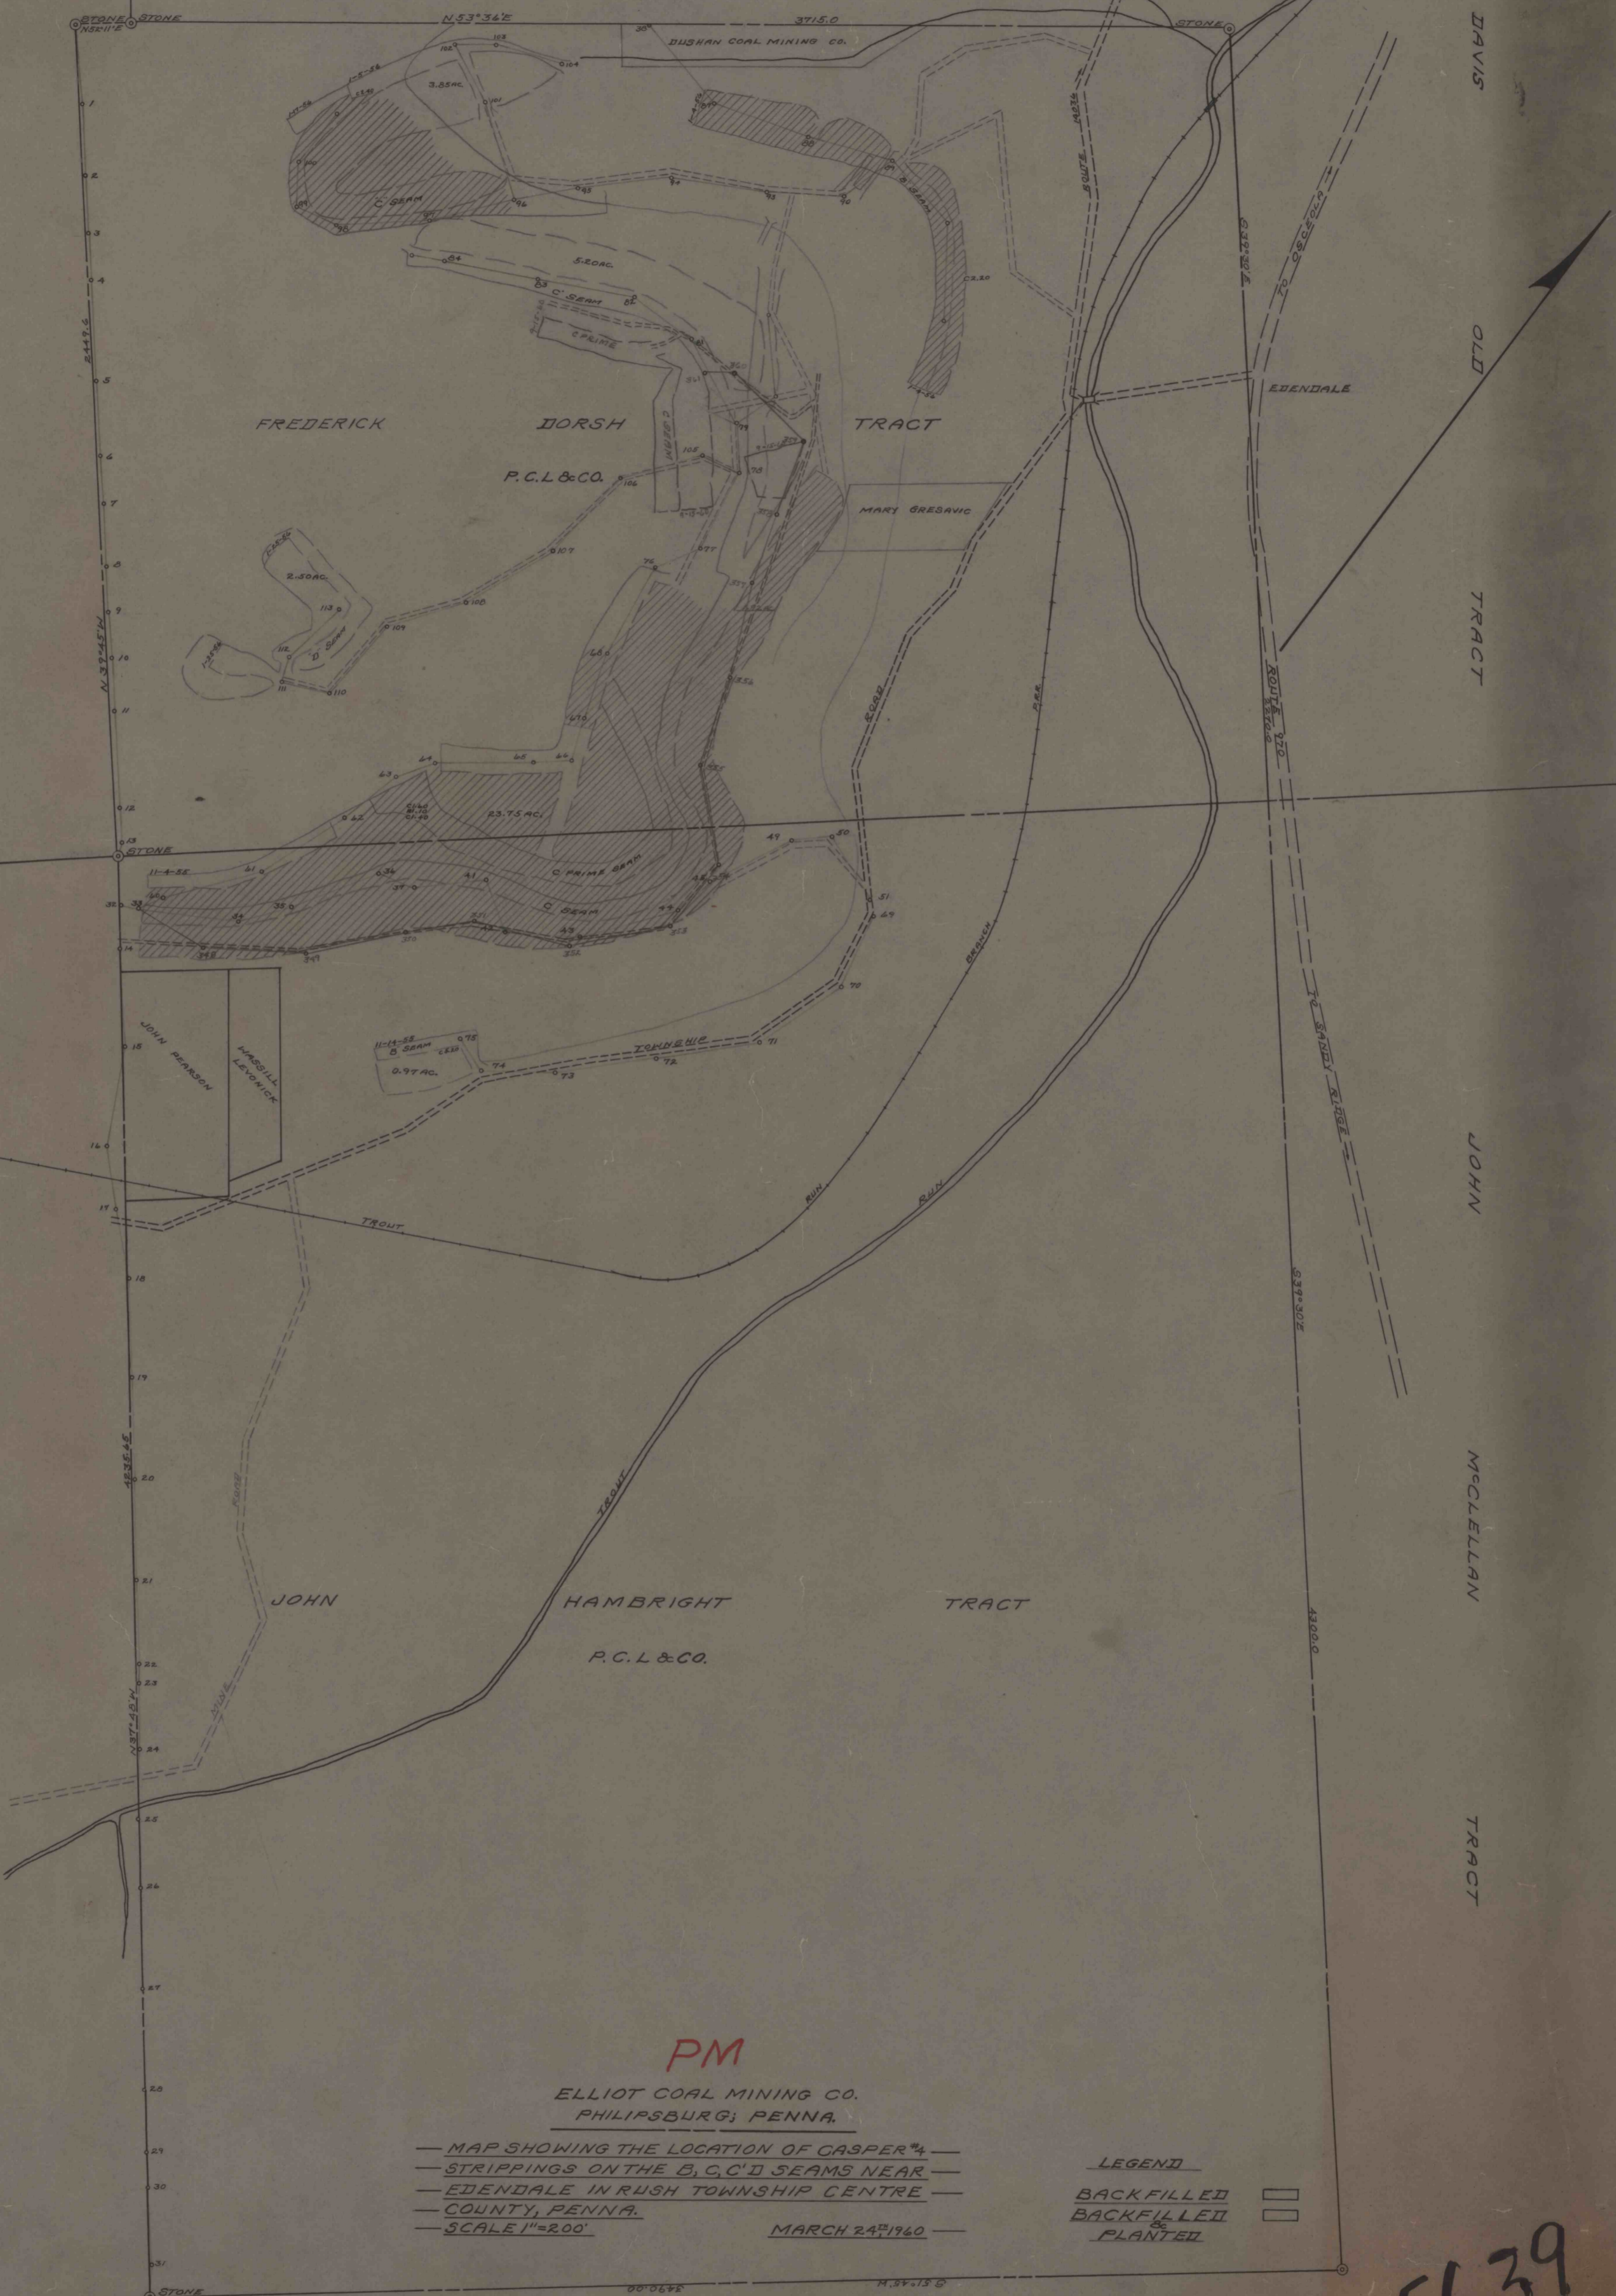

PM

ELLIOT COAL MINING CO.  
PHILIPSBURG, PENNA.

— MAP SHOWING THE LOCATION OF CASPER #4 —  
— STRIPPINGS ON THE B, C, D SEAMS NEAR —  
— EDENDALE IN RUSH TOWNSHIP CENTRE —  
— COUNTY, PENNA. —  
— SCALE 1"=200' —


LEGEND

- BACKFILLED
- BACKFILLED & PLANTED

5639

