


SITE
SITES

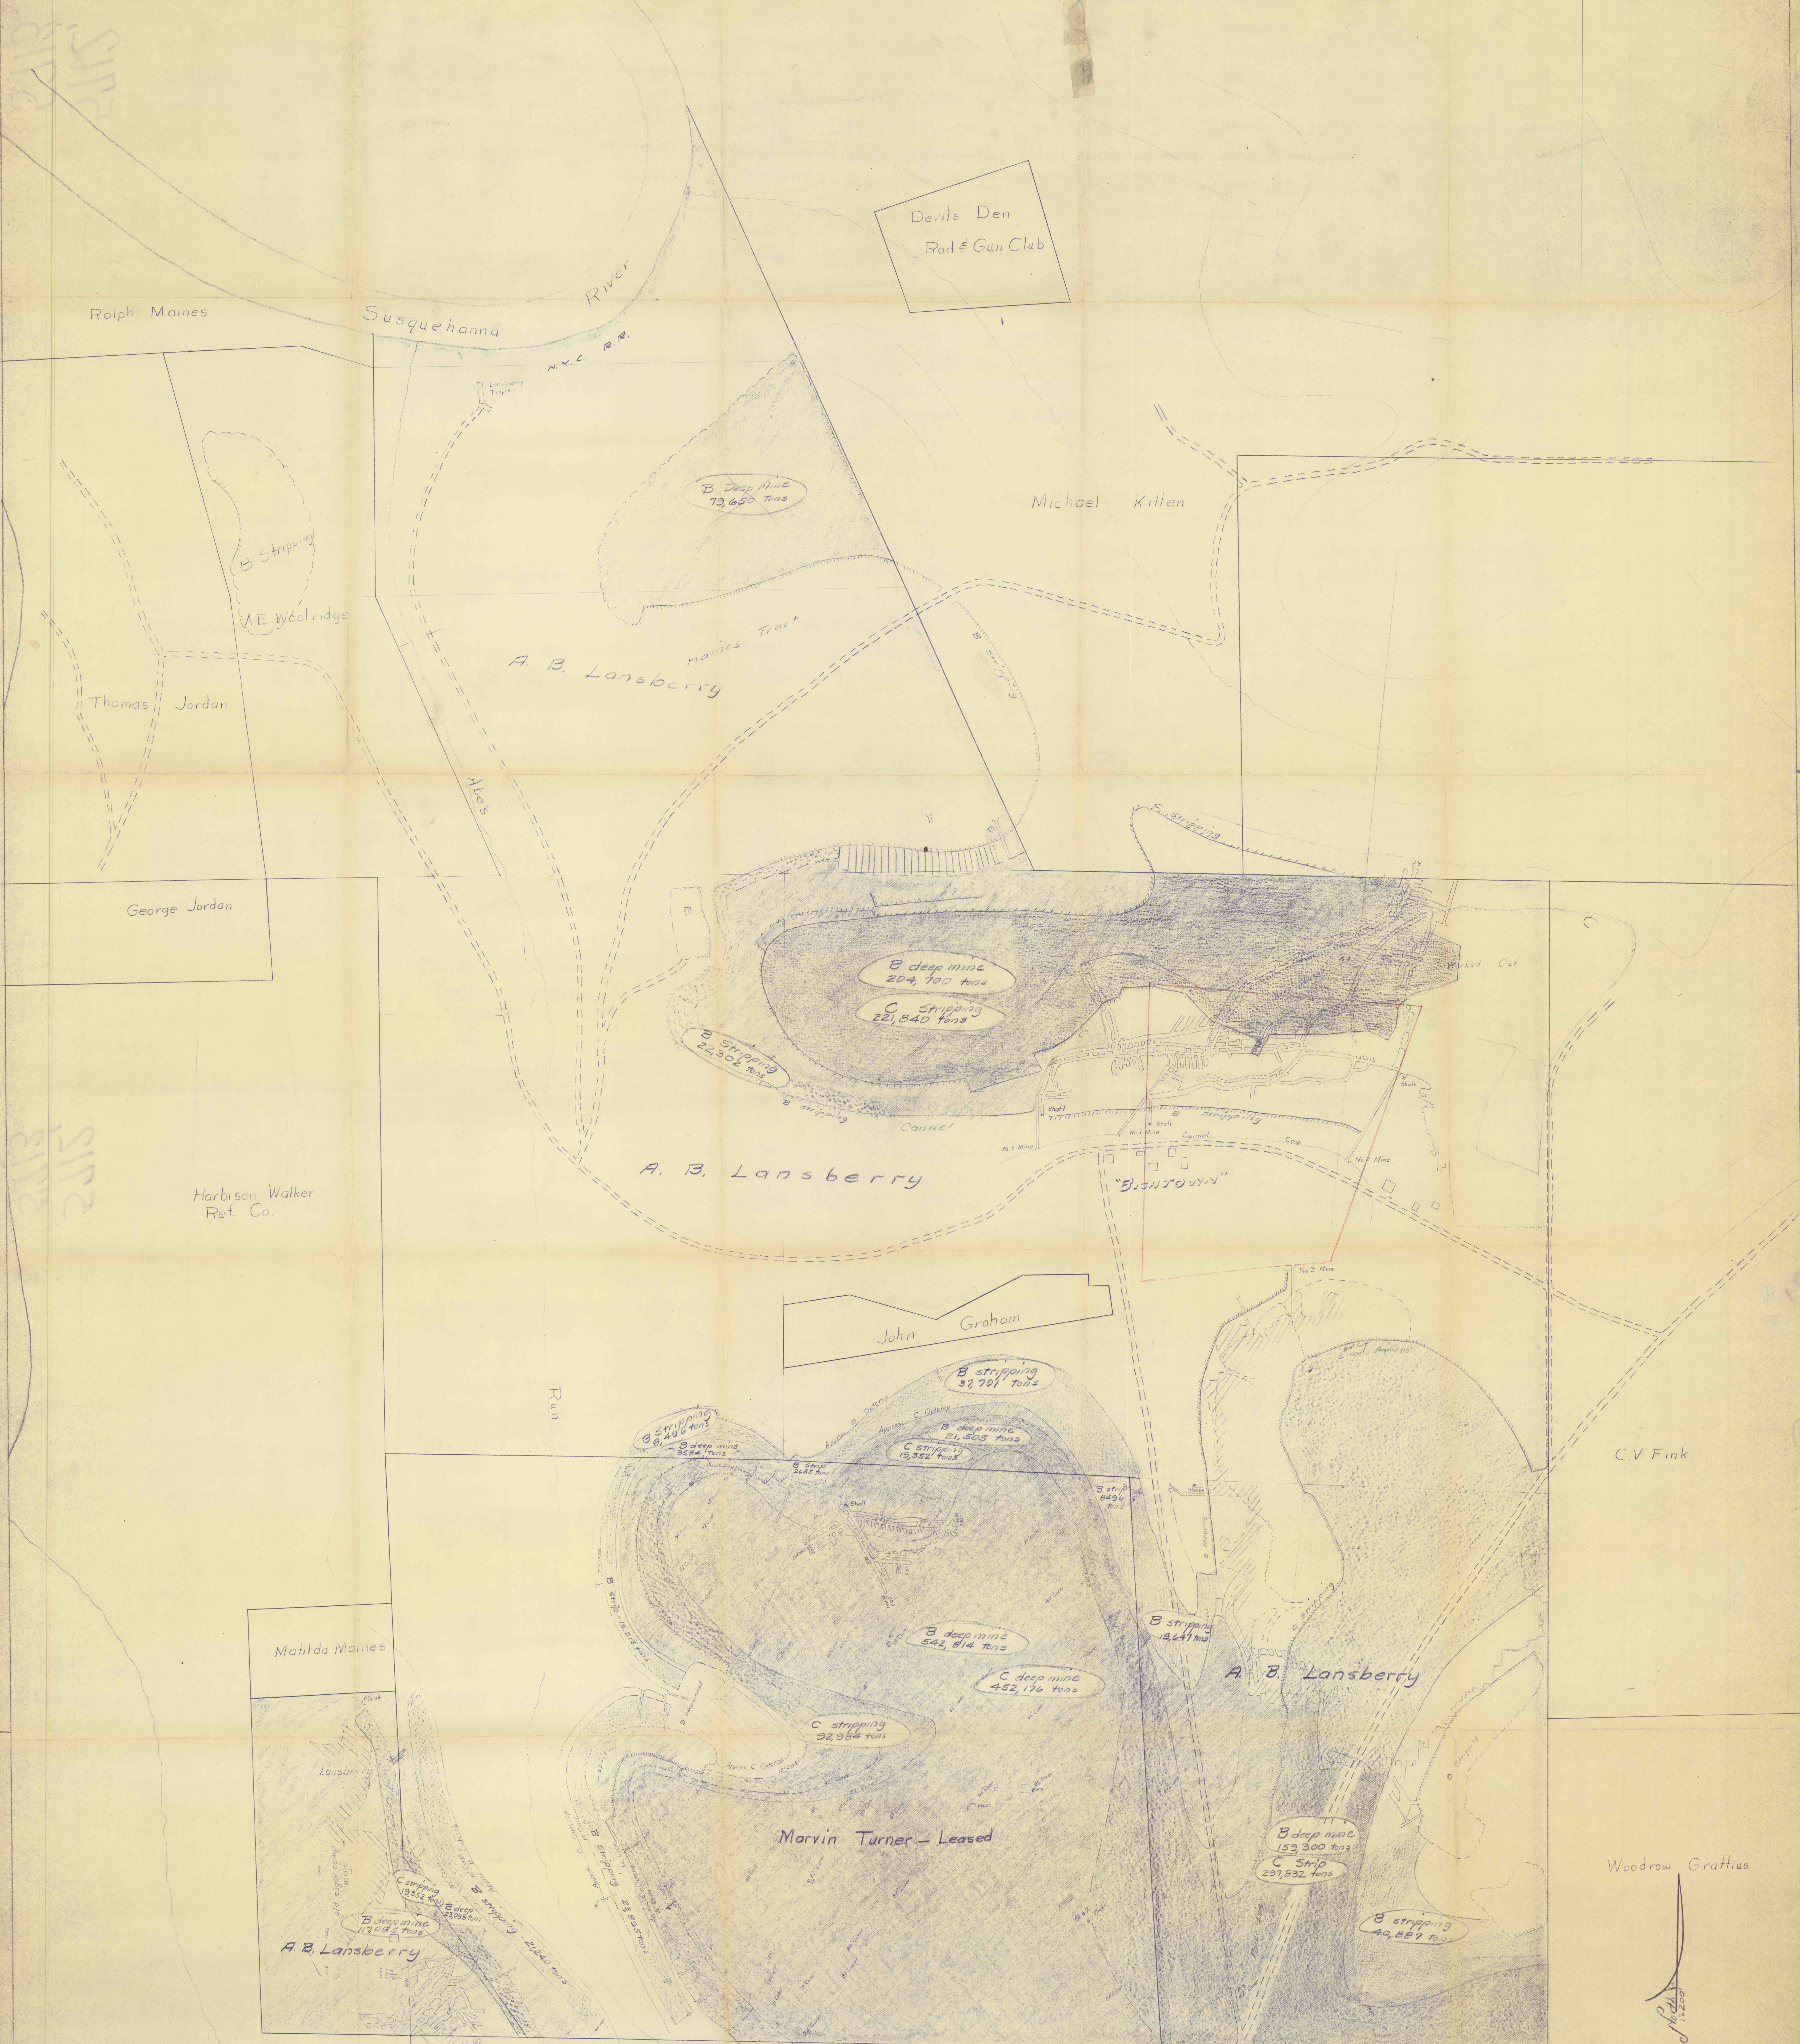

SITE
SITES

Note:
 C coal - average height - 32"
 B coal - " " - 36"
 Specific Gravity - 1.30

Prepared from: Old maps, Aerial Photos,
 USGS and actual surveys

LANSBERRY COAL CO.
 MAP SHOWING
B AND C SEAM COAL
 Bradford Twp., Clearfield Co., Penna.
SCALE - 1 inch = 200 feet
 April 10, 1933
 Clearfield, Pa.

Geot Associates Inc., Engrs.
 by John W. Hess, PE.