


P  
 +PLAN+  
 SHOWING AREA OF  
 MOSHANNON VEIN COAL

Near Head of Big Run  
 CLCO. CO. PA.

SCALE 1-INCH = 200 FT.

RE WONDERSHIP M.C.  
 in the hands of

See LETTER July 28-1900.

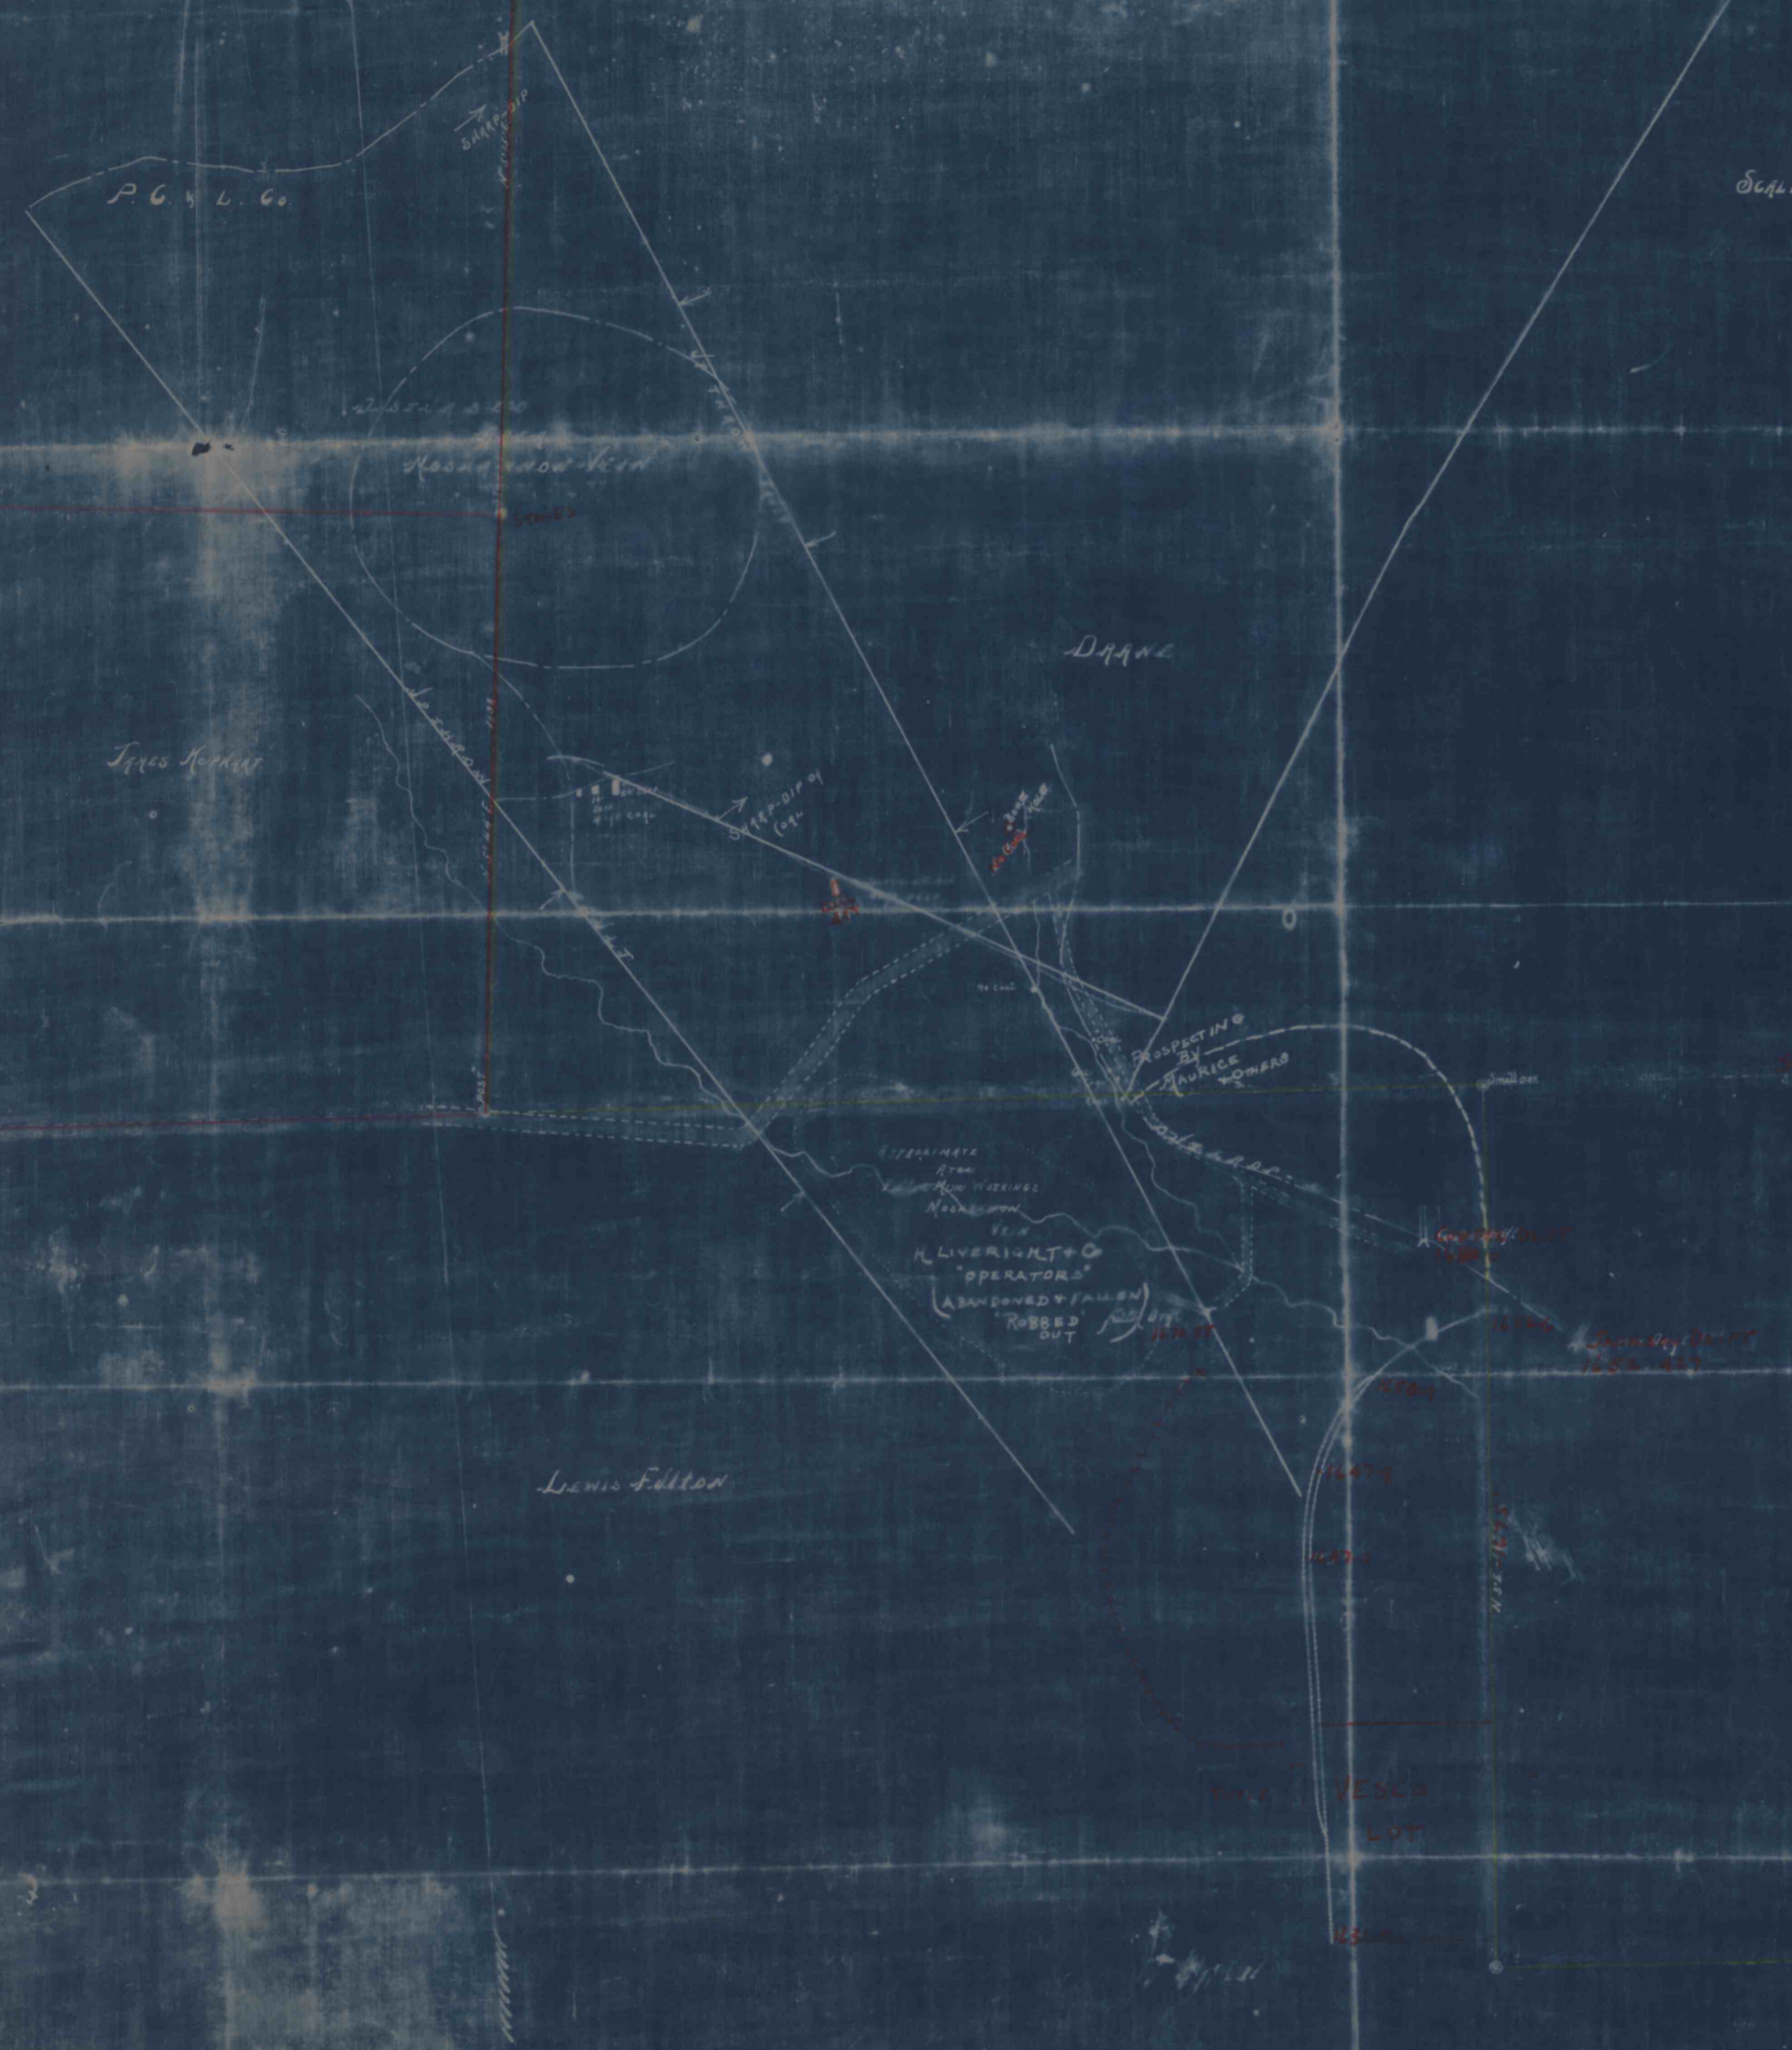

5000 E - 1500  
 LINE C-7477

