




bd

6177

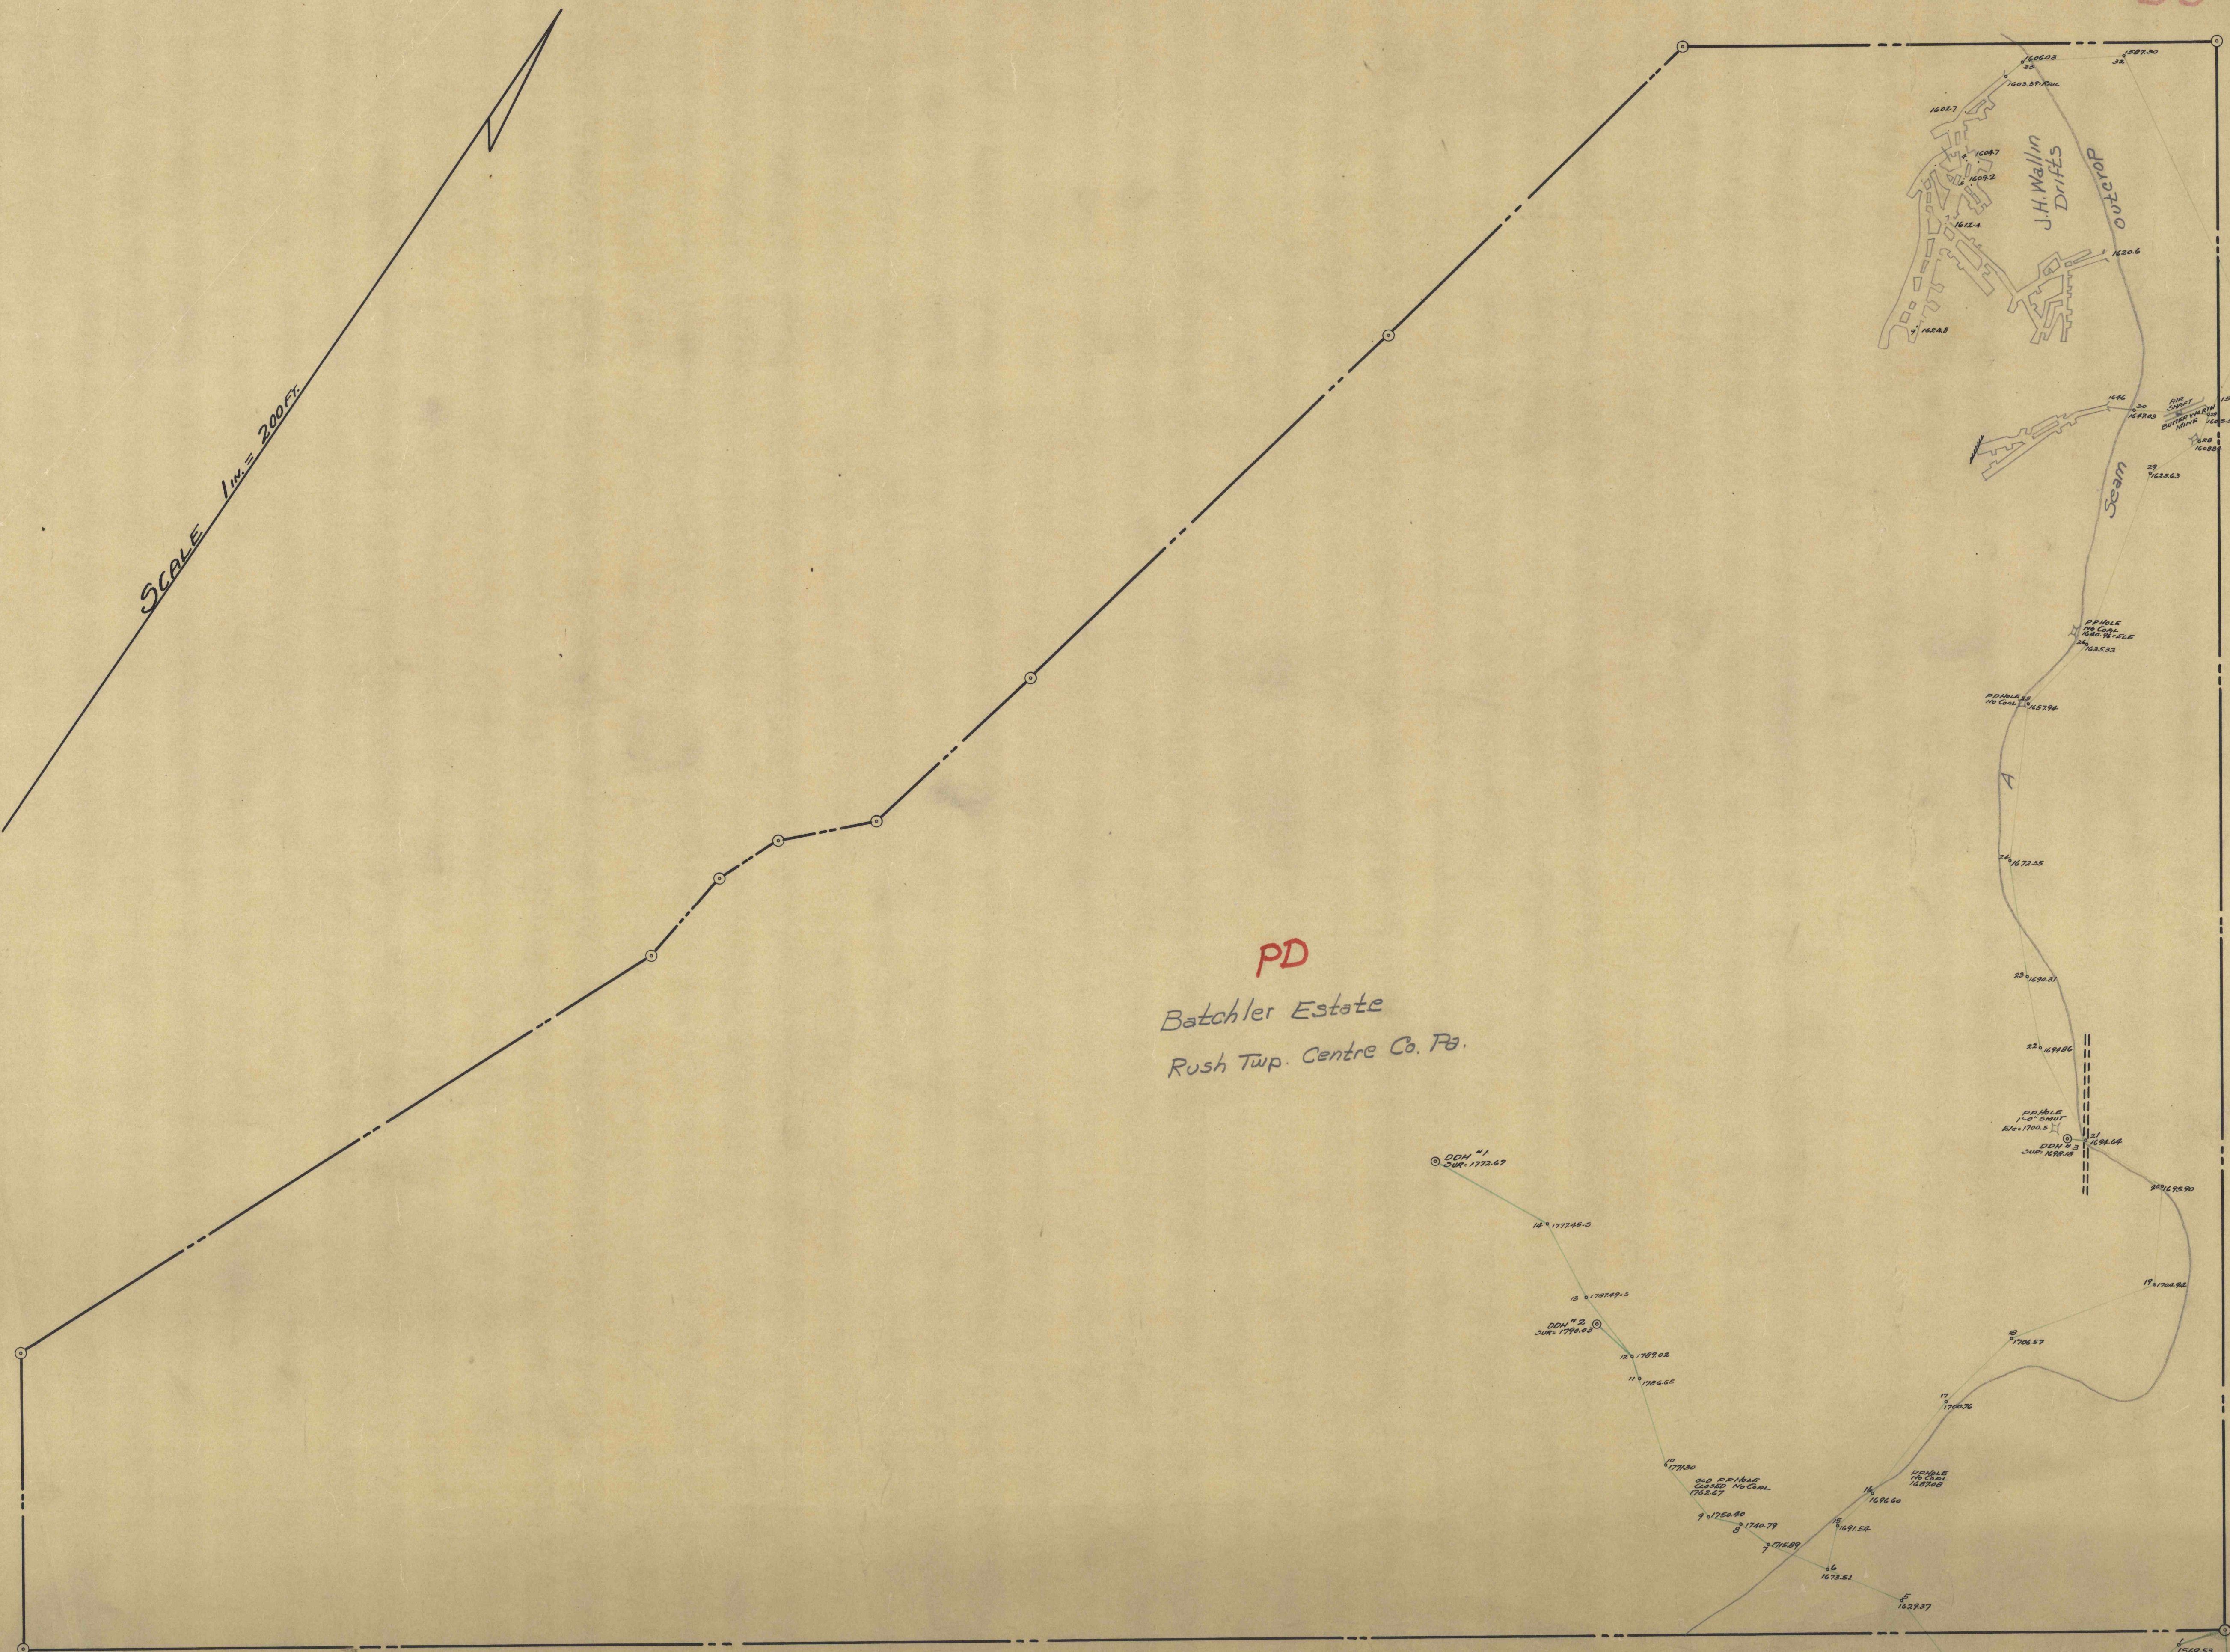

SCALE 1 in. = 200 ft.

PD
Batchler Estate
Rush Twp. Centre Co. Pa.

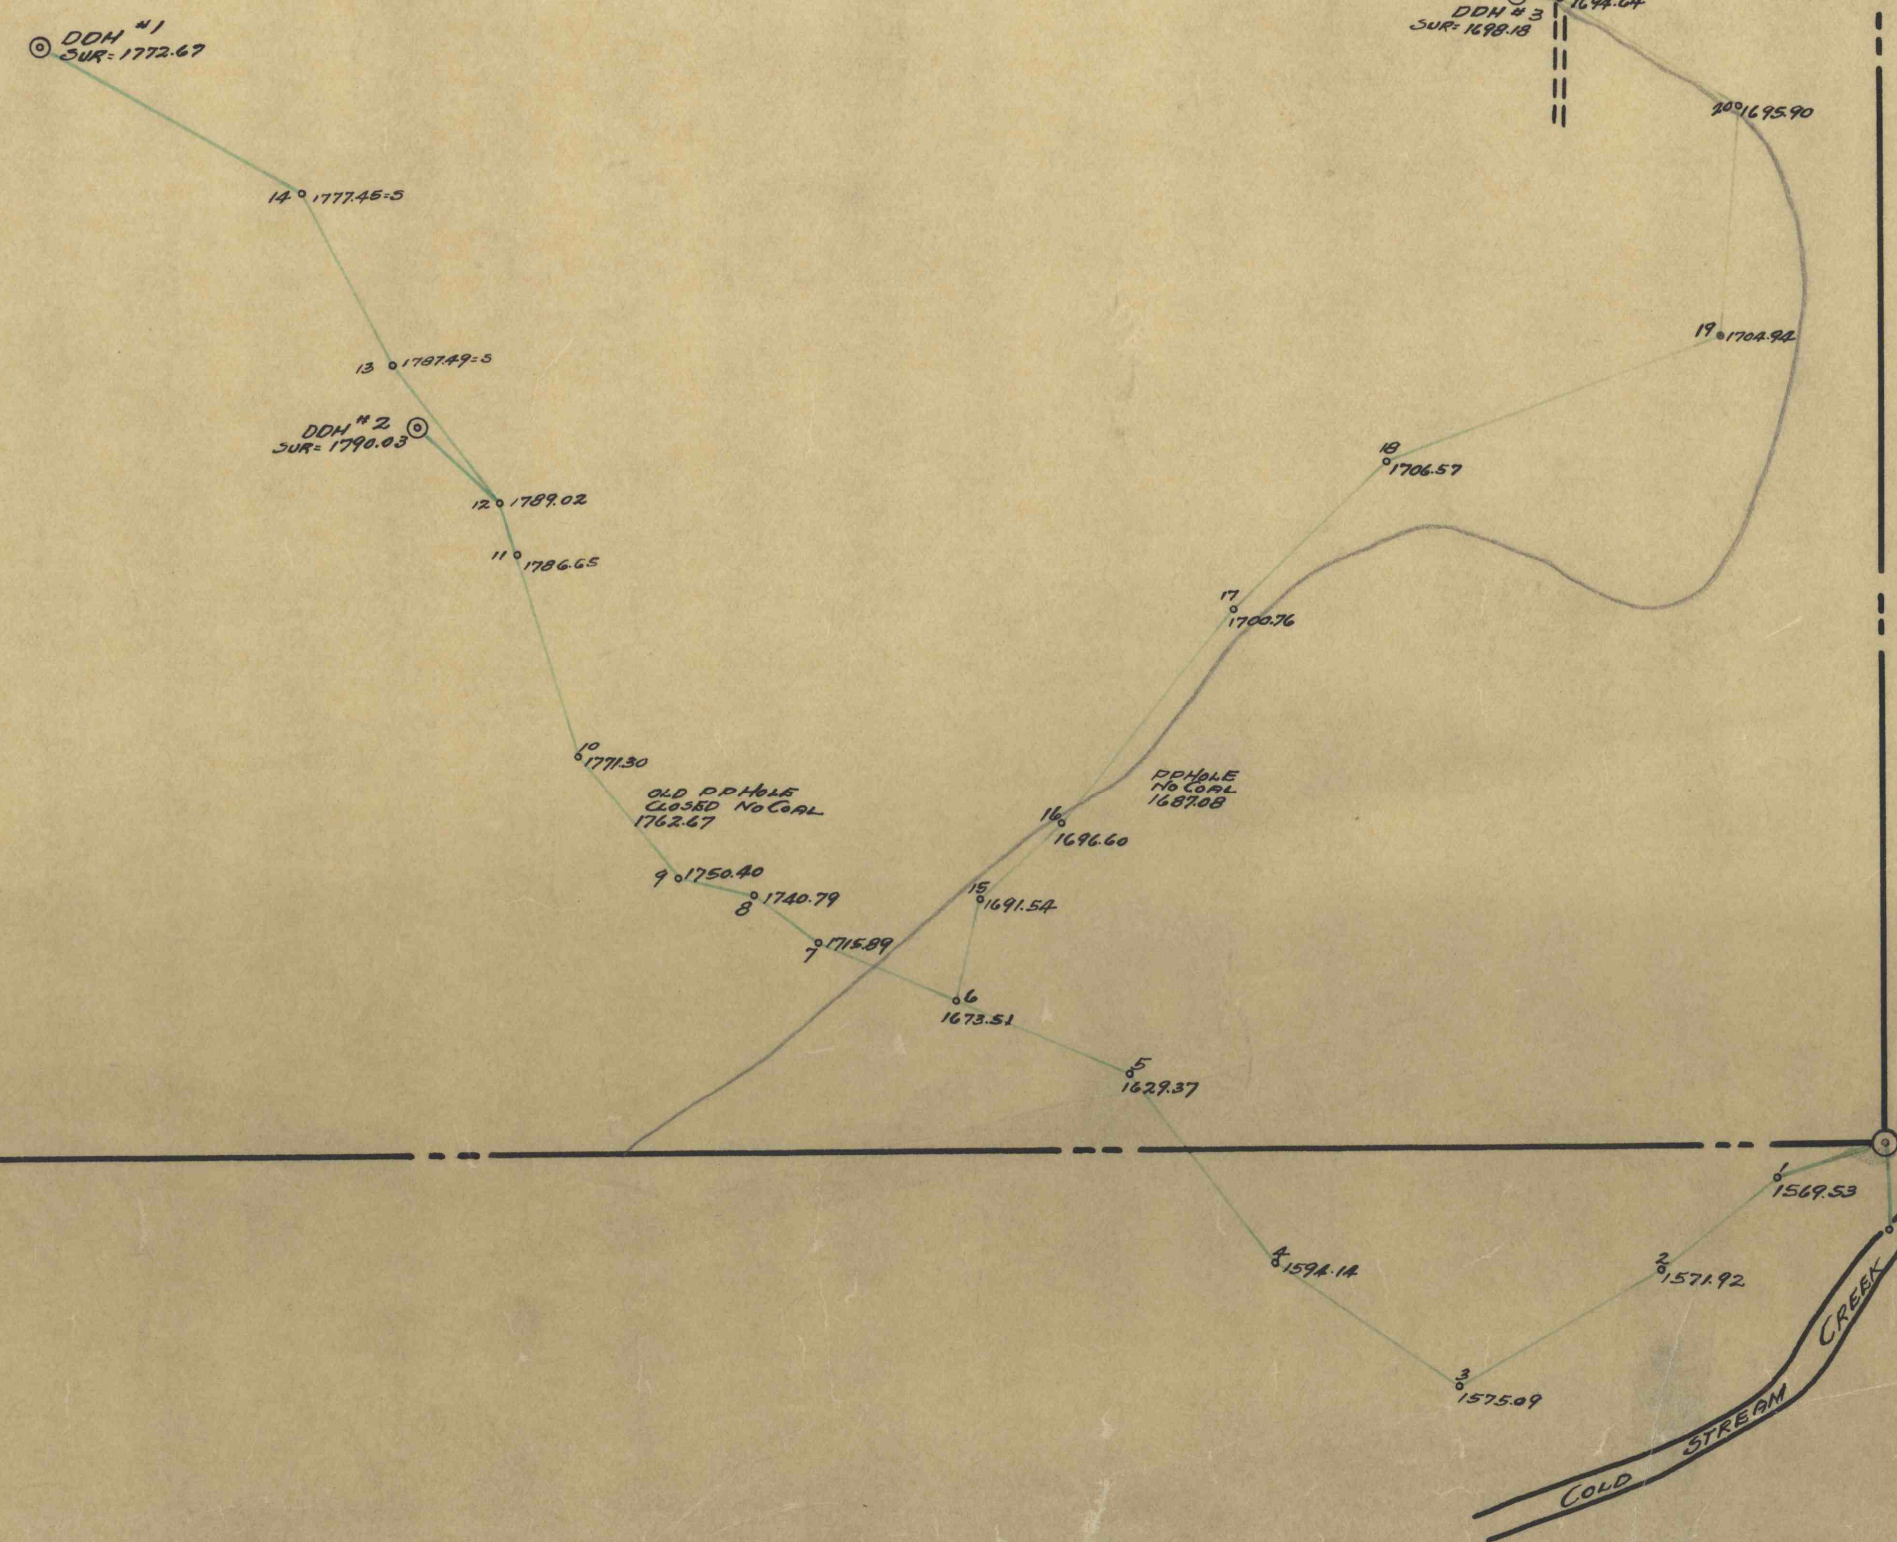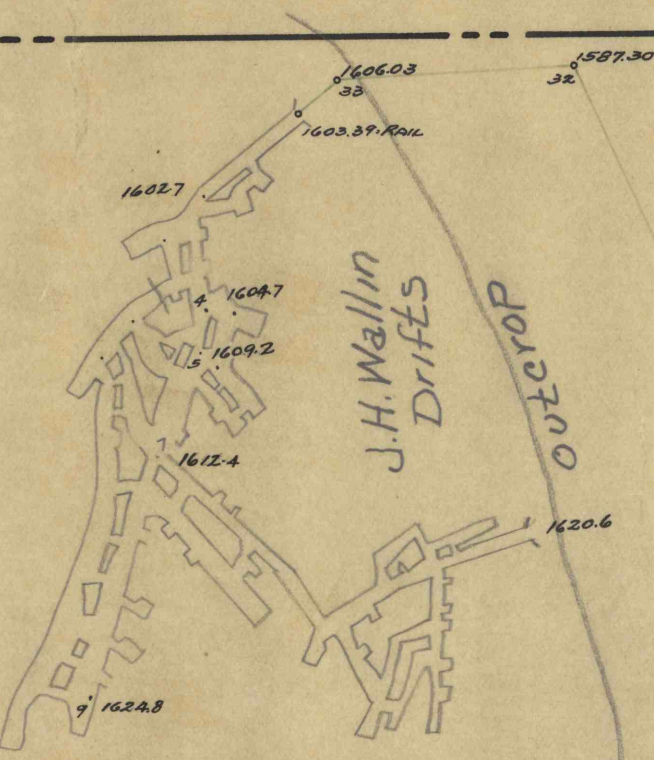

6177