

122d


8138

W.C. Beckwith
C.B.C. Tract
Empire Coal

60875
60800.45

6551

8138

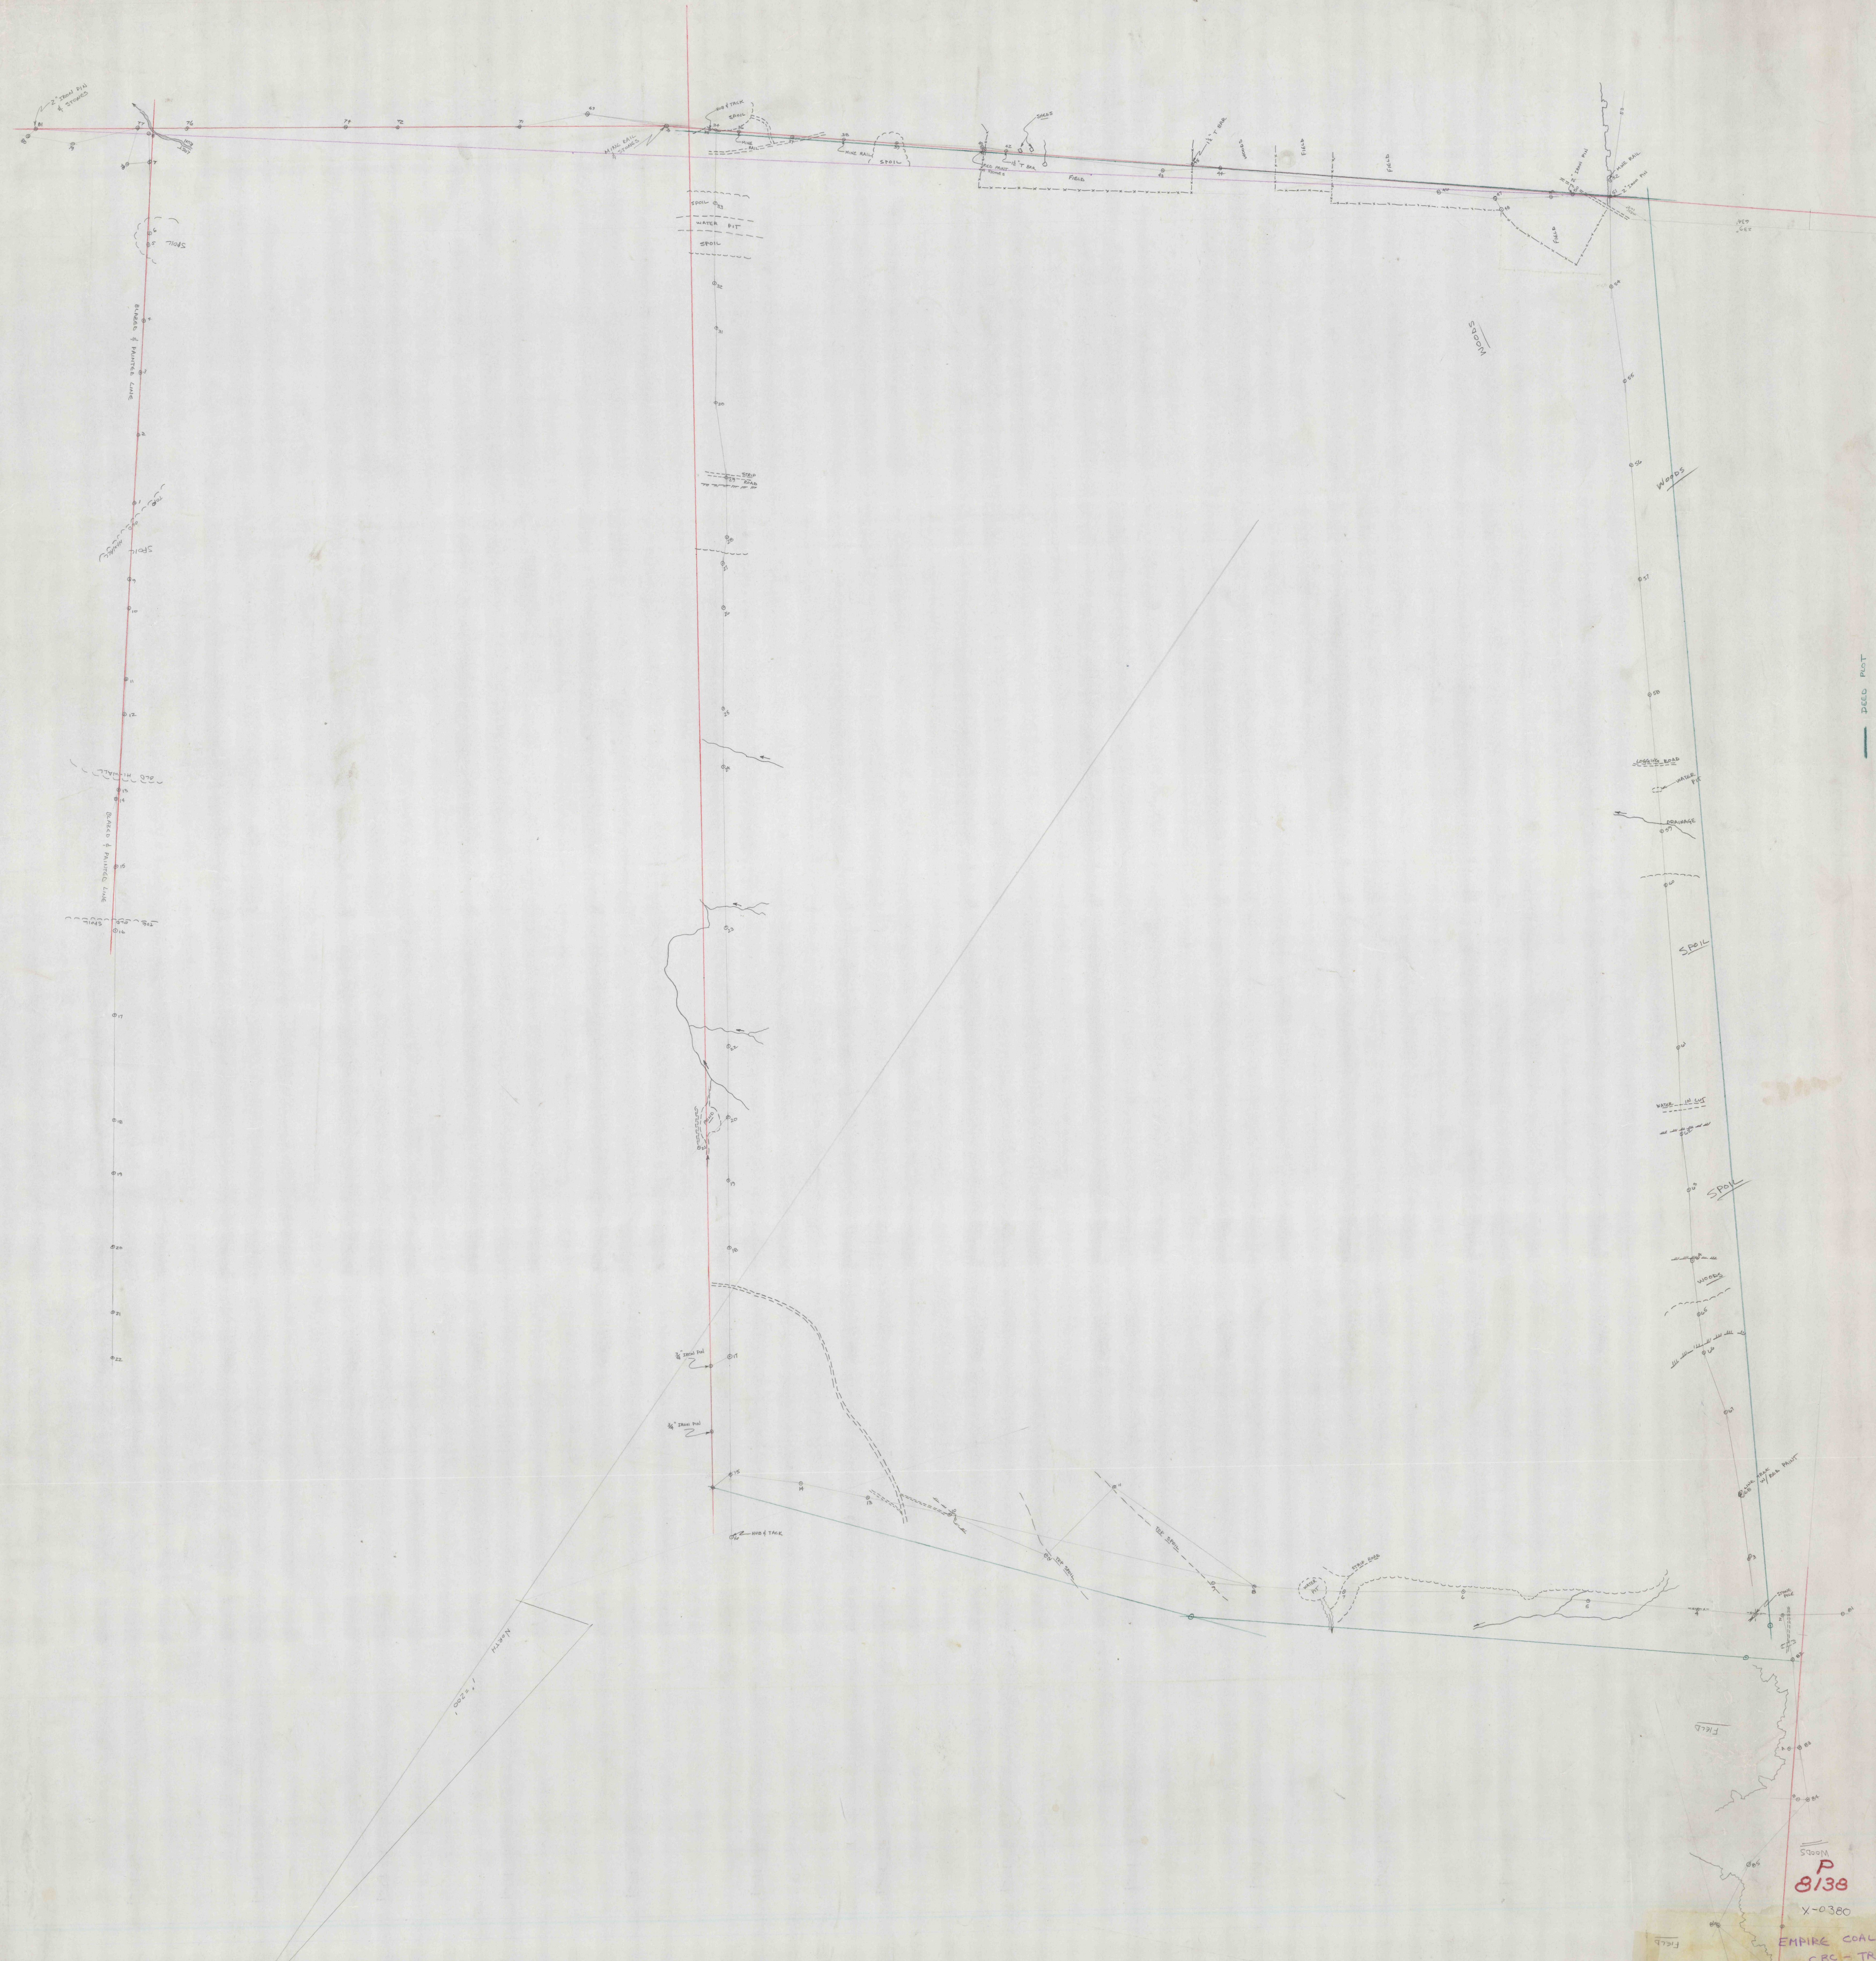

DEEG PUT
LINES FROM ACTUAL SURVEY

Sheet
P
8138
X-0380

EMPIRE COAL
C.B.C. TRACT
NEAR BOARLMAN